


0376-311

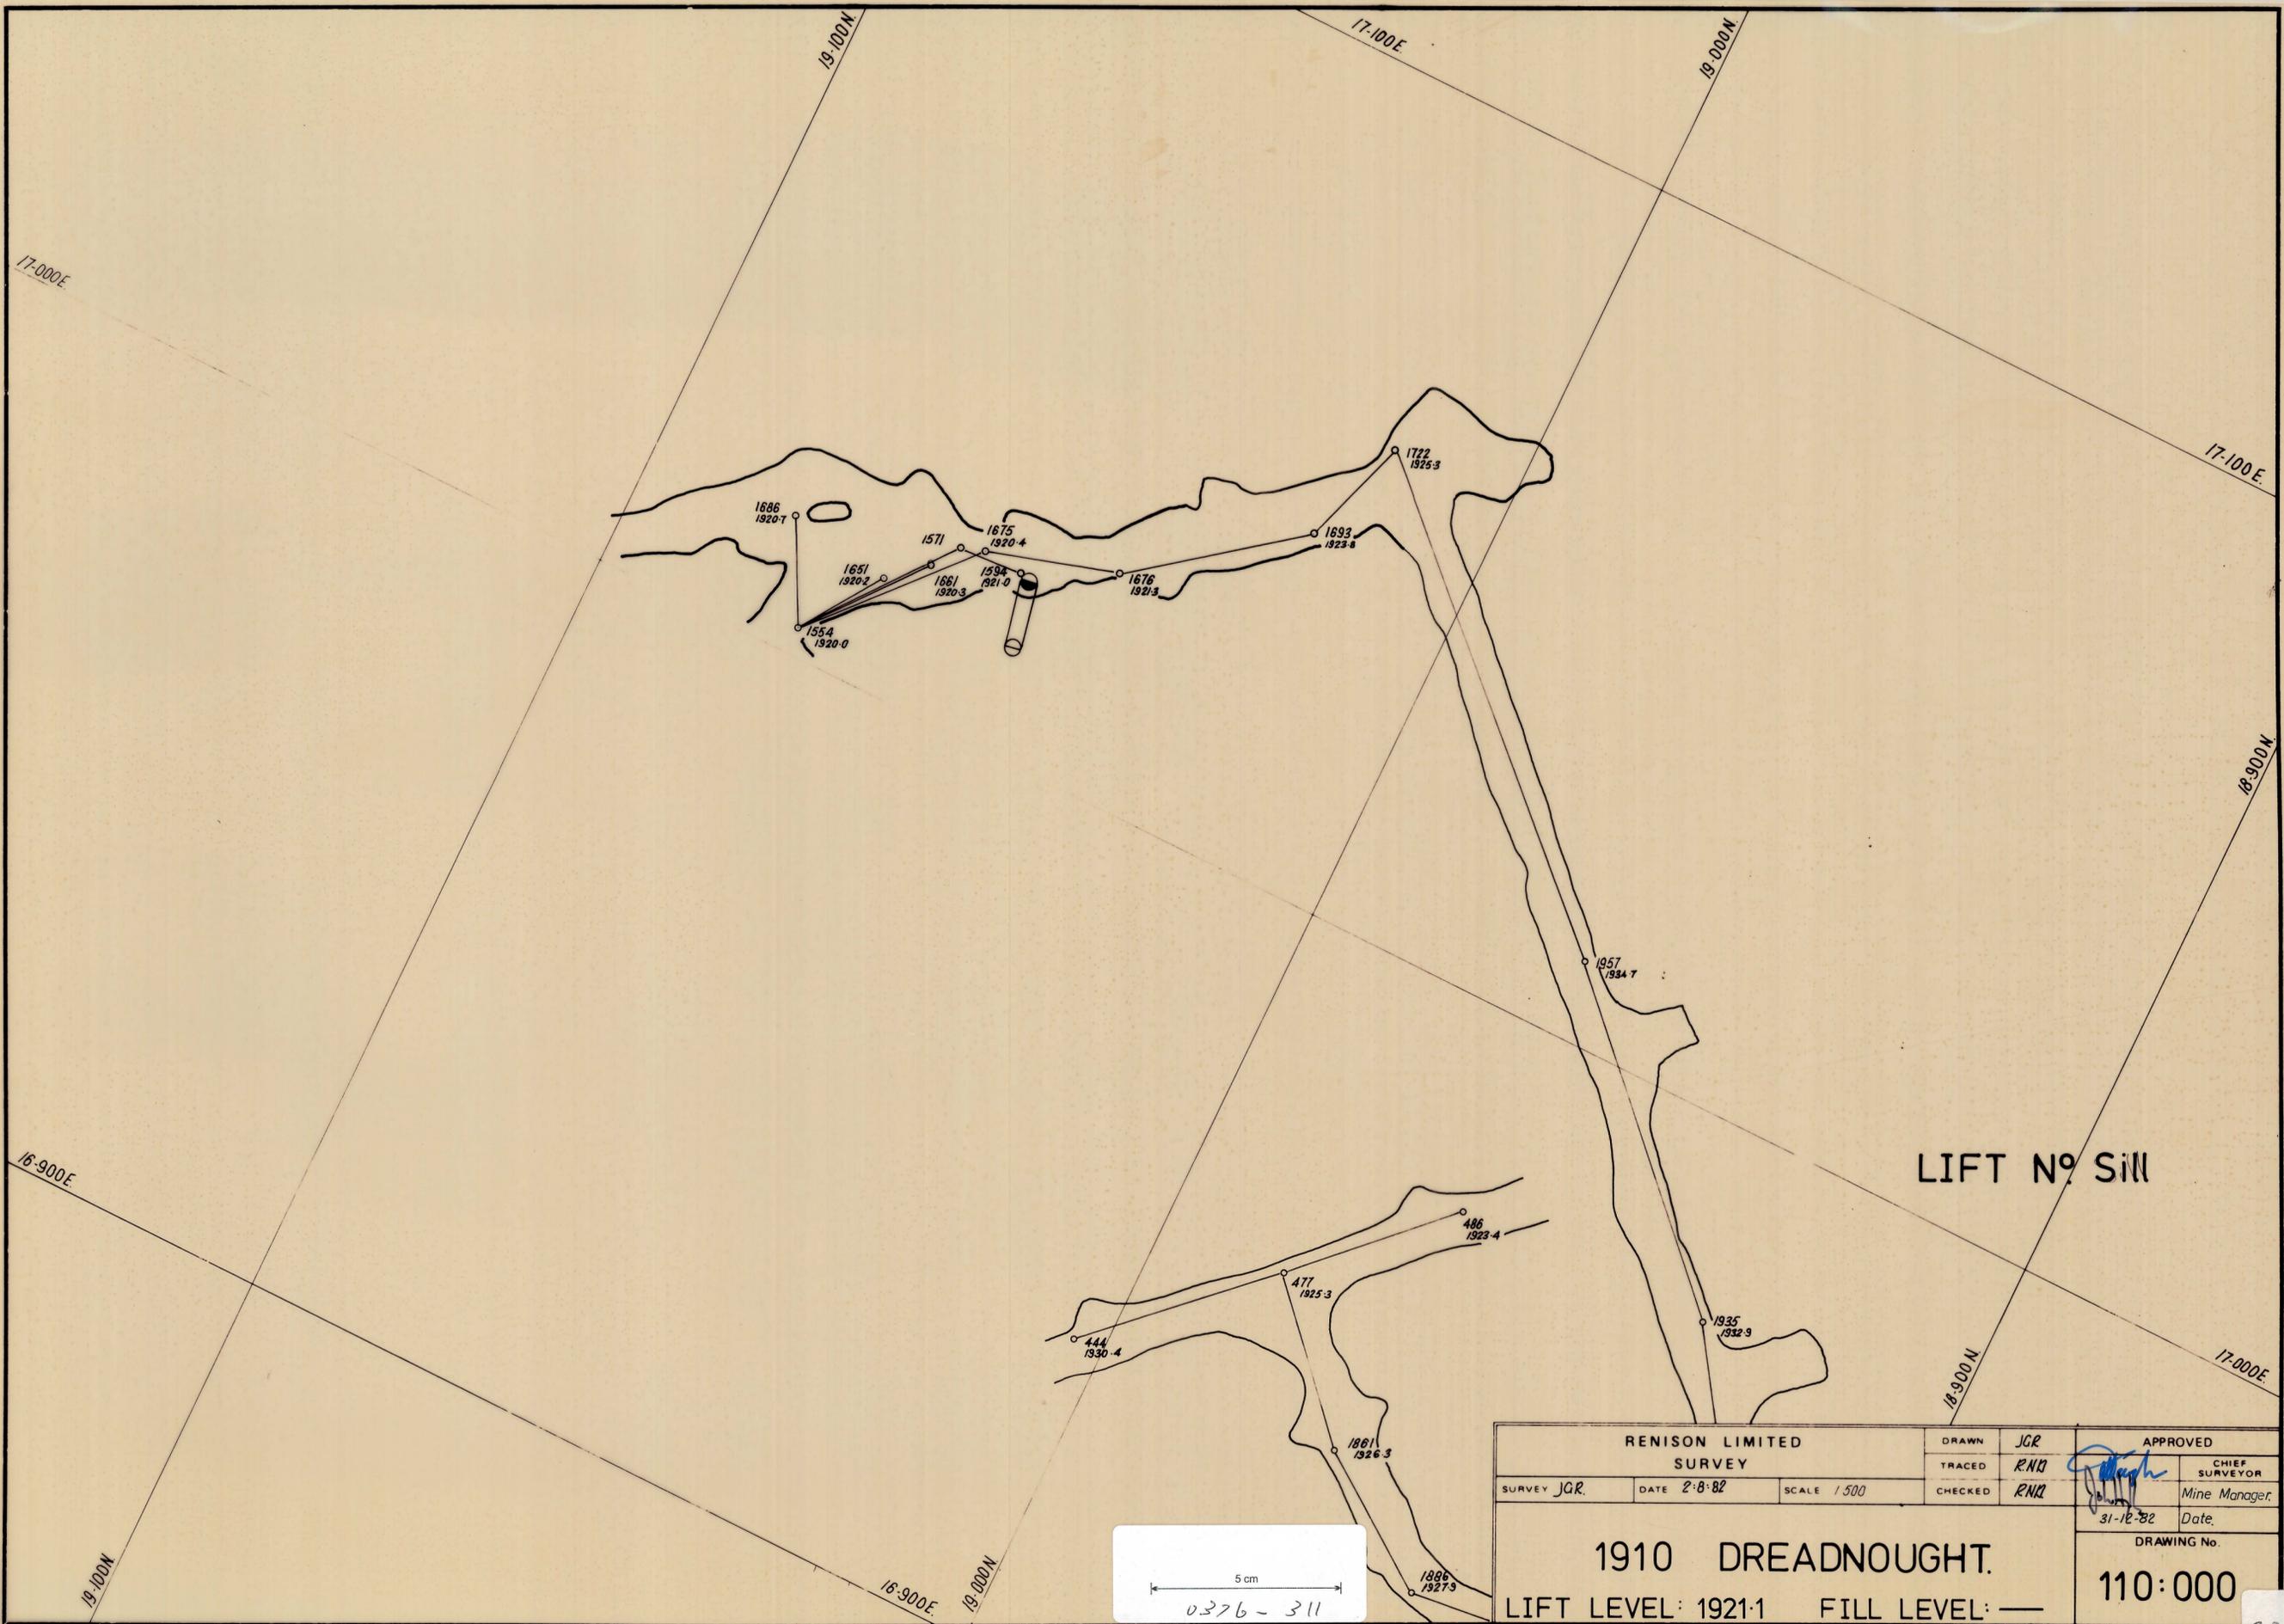

RENISON LIMITED SURVEY			DRAWN	JGR	APPROVED
			TRACED	R.N.D.	CHIEF SURVEYOR
			CHECKED	R.N.D.	Mine Manager.
SURVEY	JGR.	DATE	2-8-82	SCALE	1/500
					31-12-82 Date.
1910 DREADNOUGHT.					DRAWING No.
LIFT LEVEL: 1921.1					110:000
FILL LEVEL: —					

5 cm
0376-311

83145