


0376-312

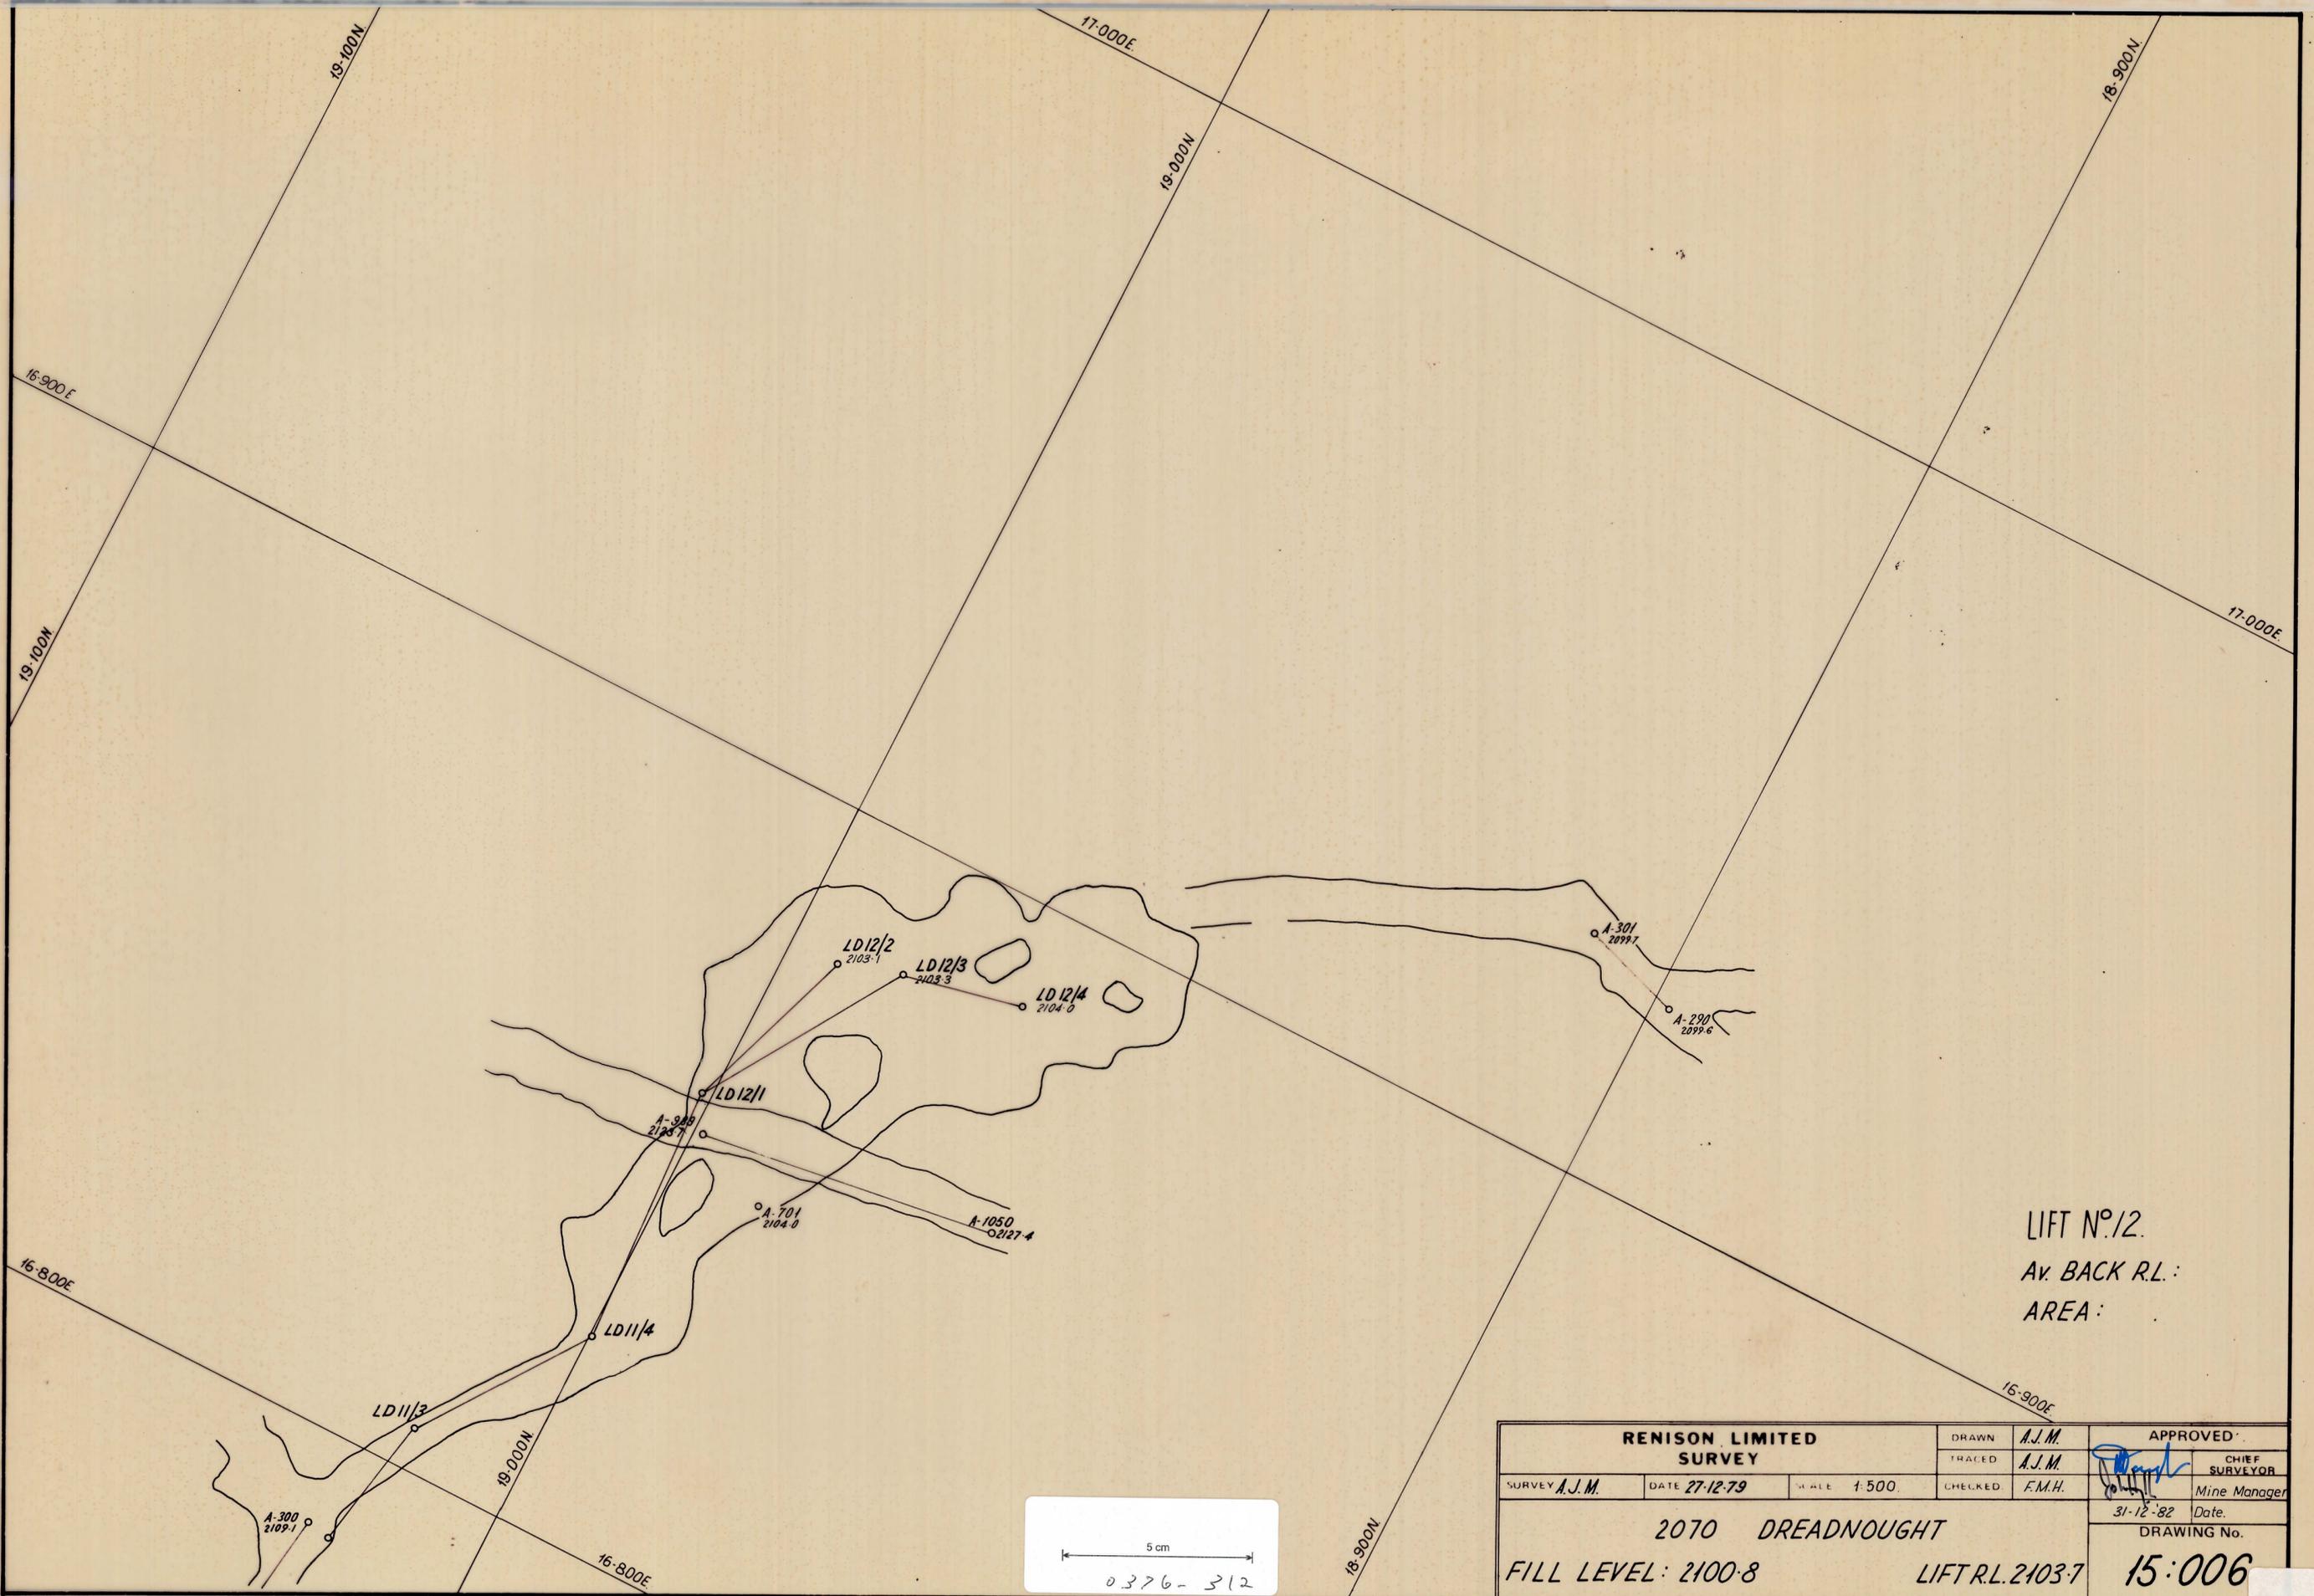

LIFT N°12.  
 Av. BACK R.L. :  
 AREA :

<b>RENISON LIMITED SURVEY</b>			DRAWN A.J.M.	APPROVED
SURVEY A.J.M.	DATE 27-12-79	SCALE 1:500	TRACED A.J.M.	<i>[Signature]</i> CHIEF SURVEYOR
			CHECKED F.M.H.	Mine Manager
2070 DREADNOUGHT				31-12-82 Date.
FILL LEVEL: 2100.8				DRAWING No.
LIFT R.L. 2103.7				15:006

5 cm  
 0376-312

83144