



0376-313

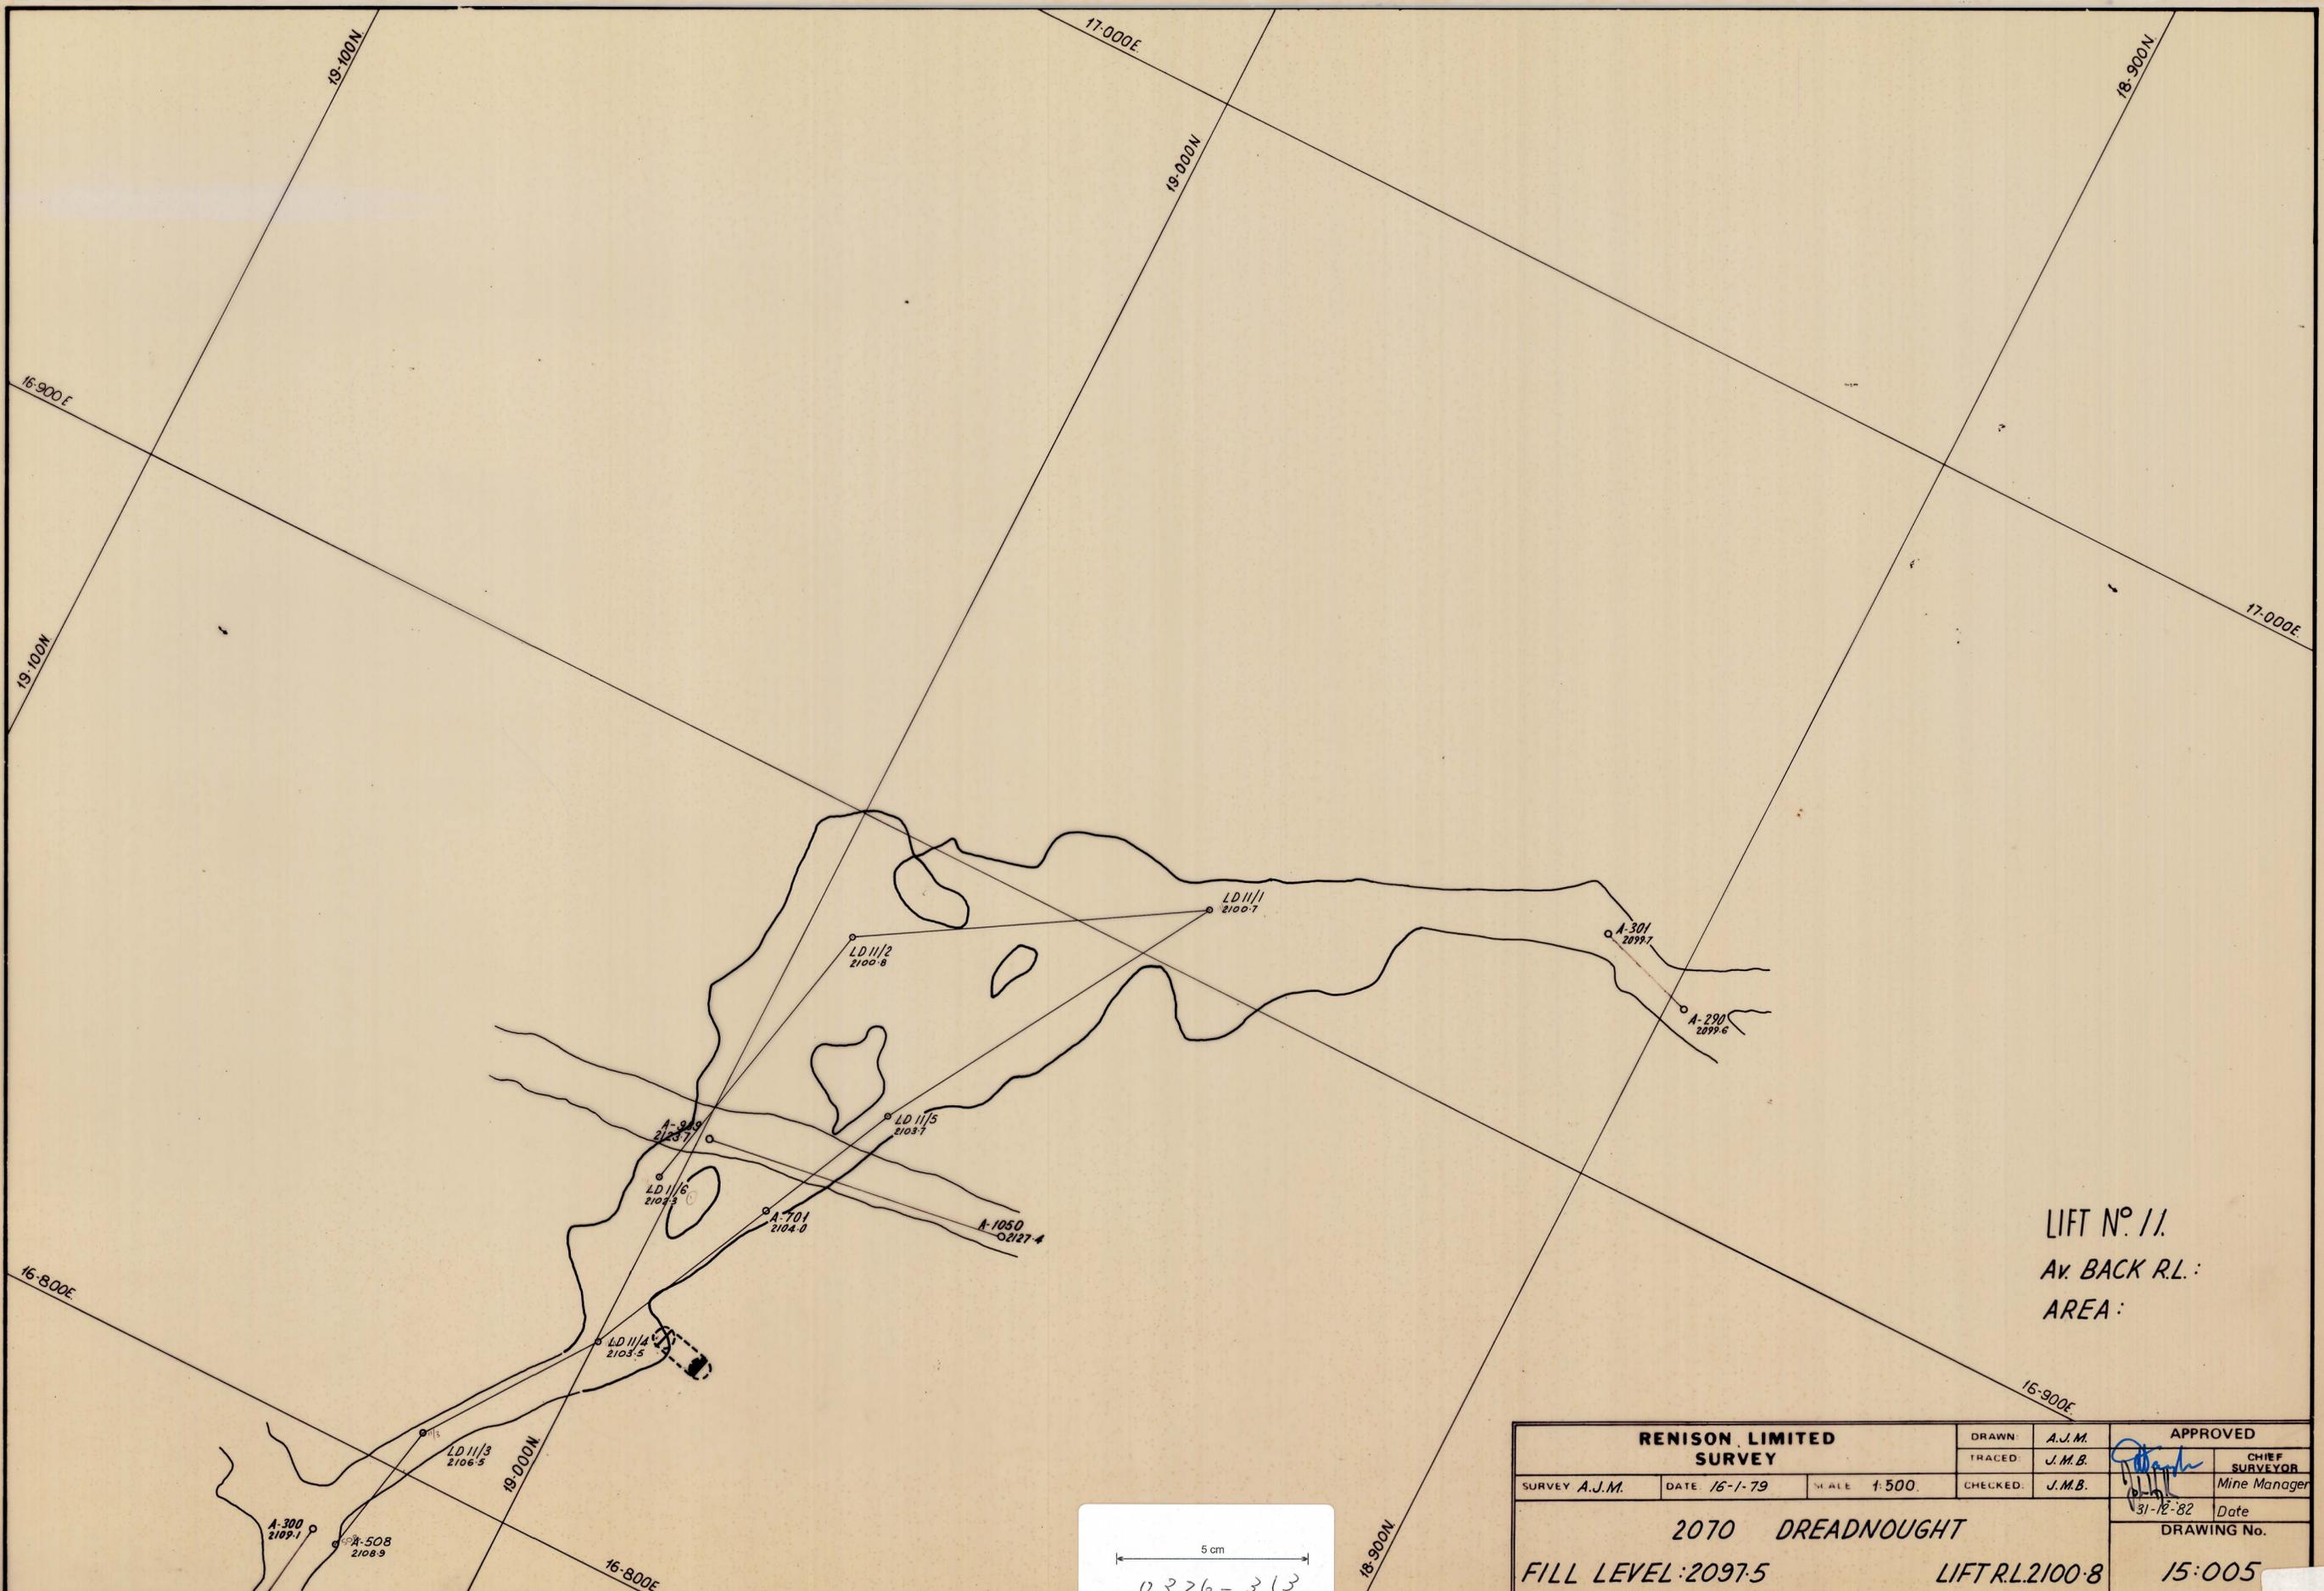

LIFT N^o 11.
 Av. BACK R.L.:
 AREA:

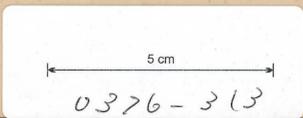

RENISON LIMITED SURVEY			DRAWN: A.J.M.	APPROVED
			TRACED: J.M.B.	CHIEF SURVEYOR
SURVEY A.J.M.	DATE 16-1-79	SCALE 1:500	CHECKED: J.M.B.	Mine Manager
2070 DREADNOUGHT			31-12-82 Date	
			DRAWING No.	
FILL LEVEL: 2097.5			LIFT R.L. 2100.8	
			15:005	

83143