


0376-314

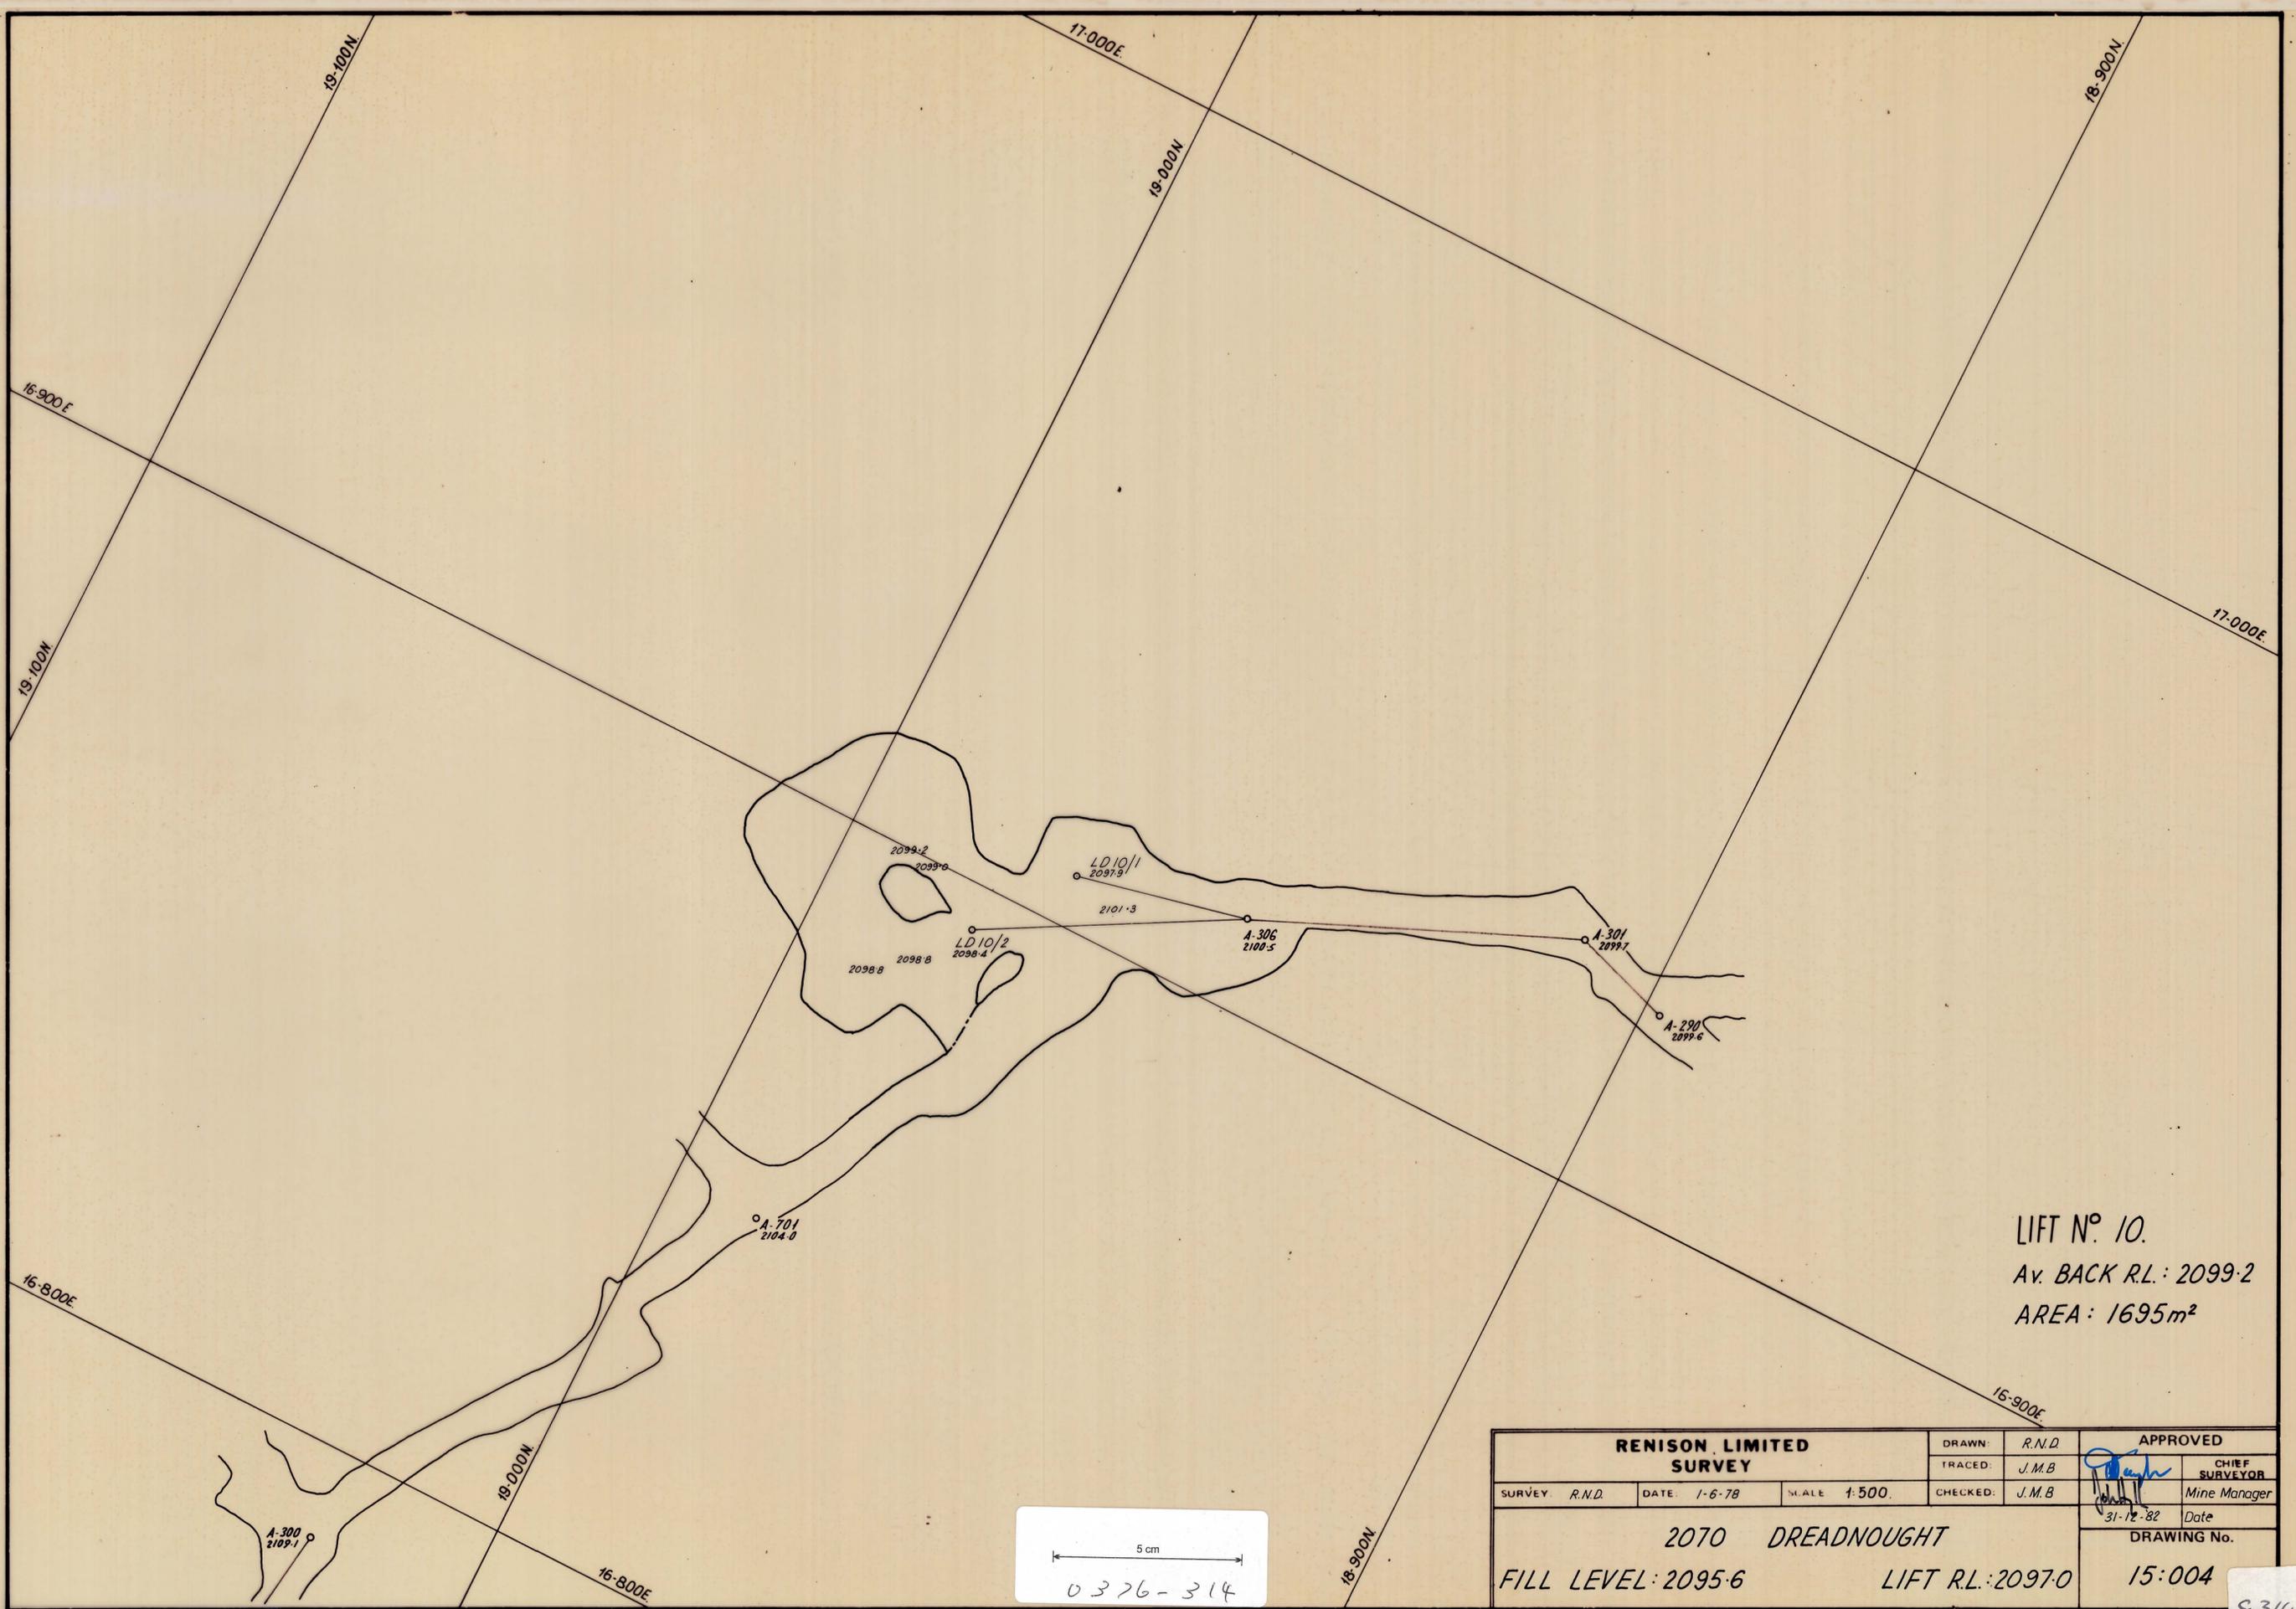

LIFT N^o 10.
 Av. BACK R.L.: 2099.2
 AREA: 1695m²

RENISON LIMITED SURVEY				DRAWN: R.N.D.	APPROVED	
				TRACED: J.M.B.	CHIEF SURVEYOR	
SURVEY: R.N.D.	DATE: 1-6-78	SCALE: 1:500	CHECKED: J.M.B.	31-12-82		Mine Manager
2070 DREADNOUGHT				Date		DRAWING No.
FILL LEVEL: 2095.6				LIFT R.L.: 2097.0		15:004

5 cm
 0376-314

83142