


0376-315

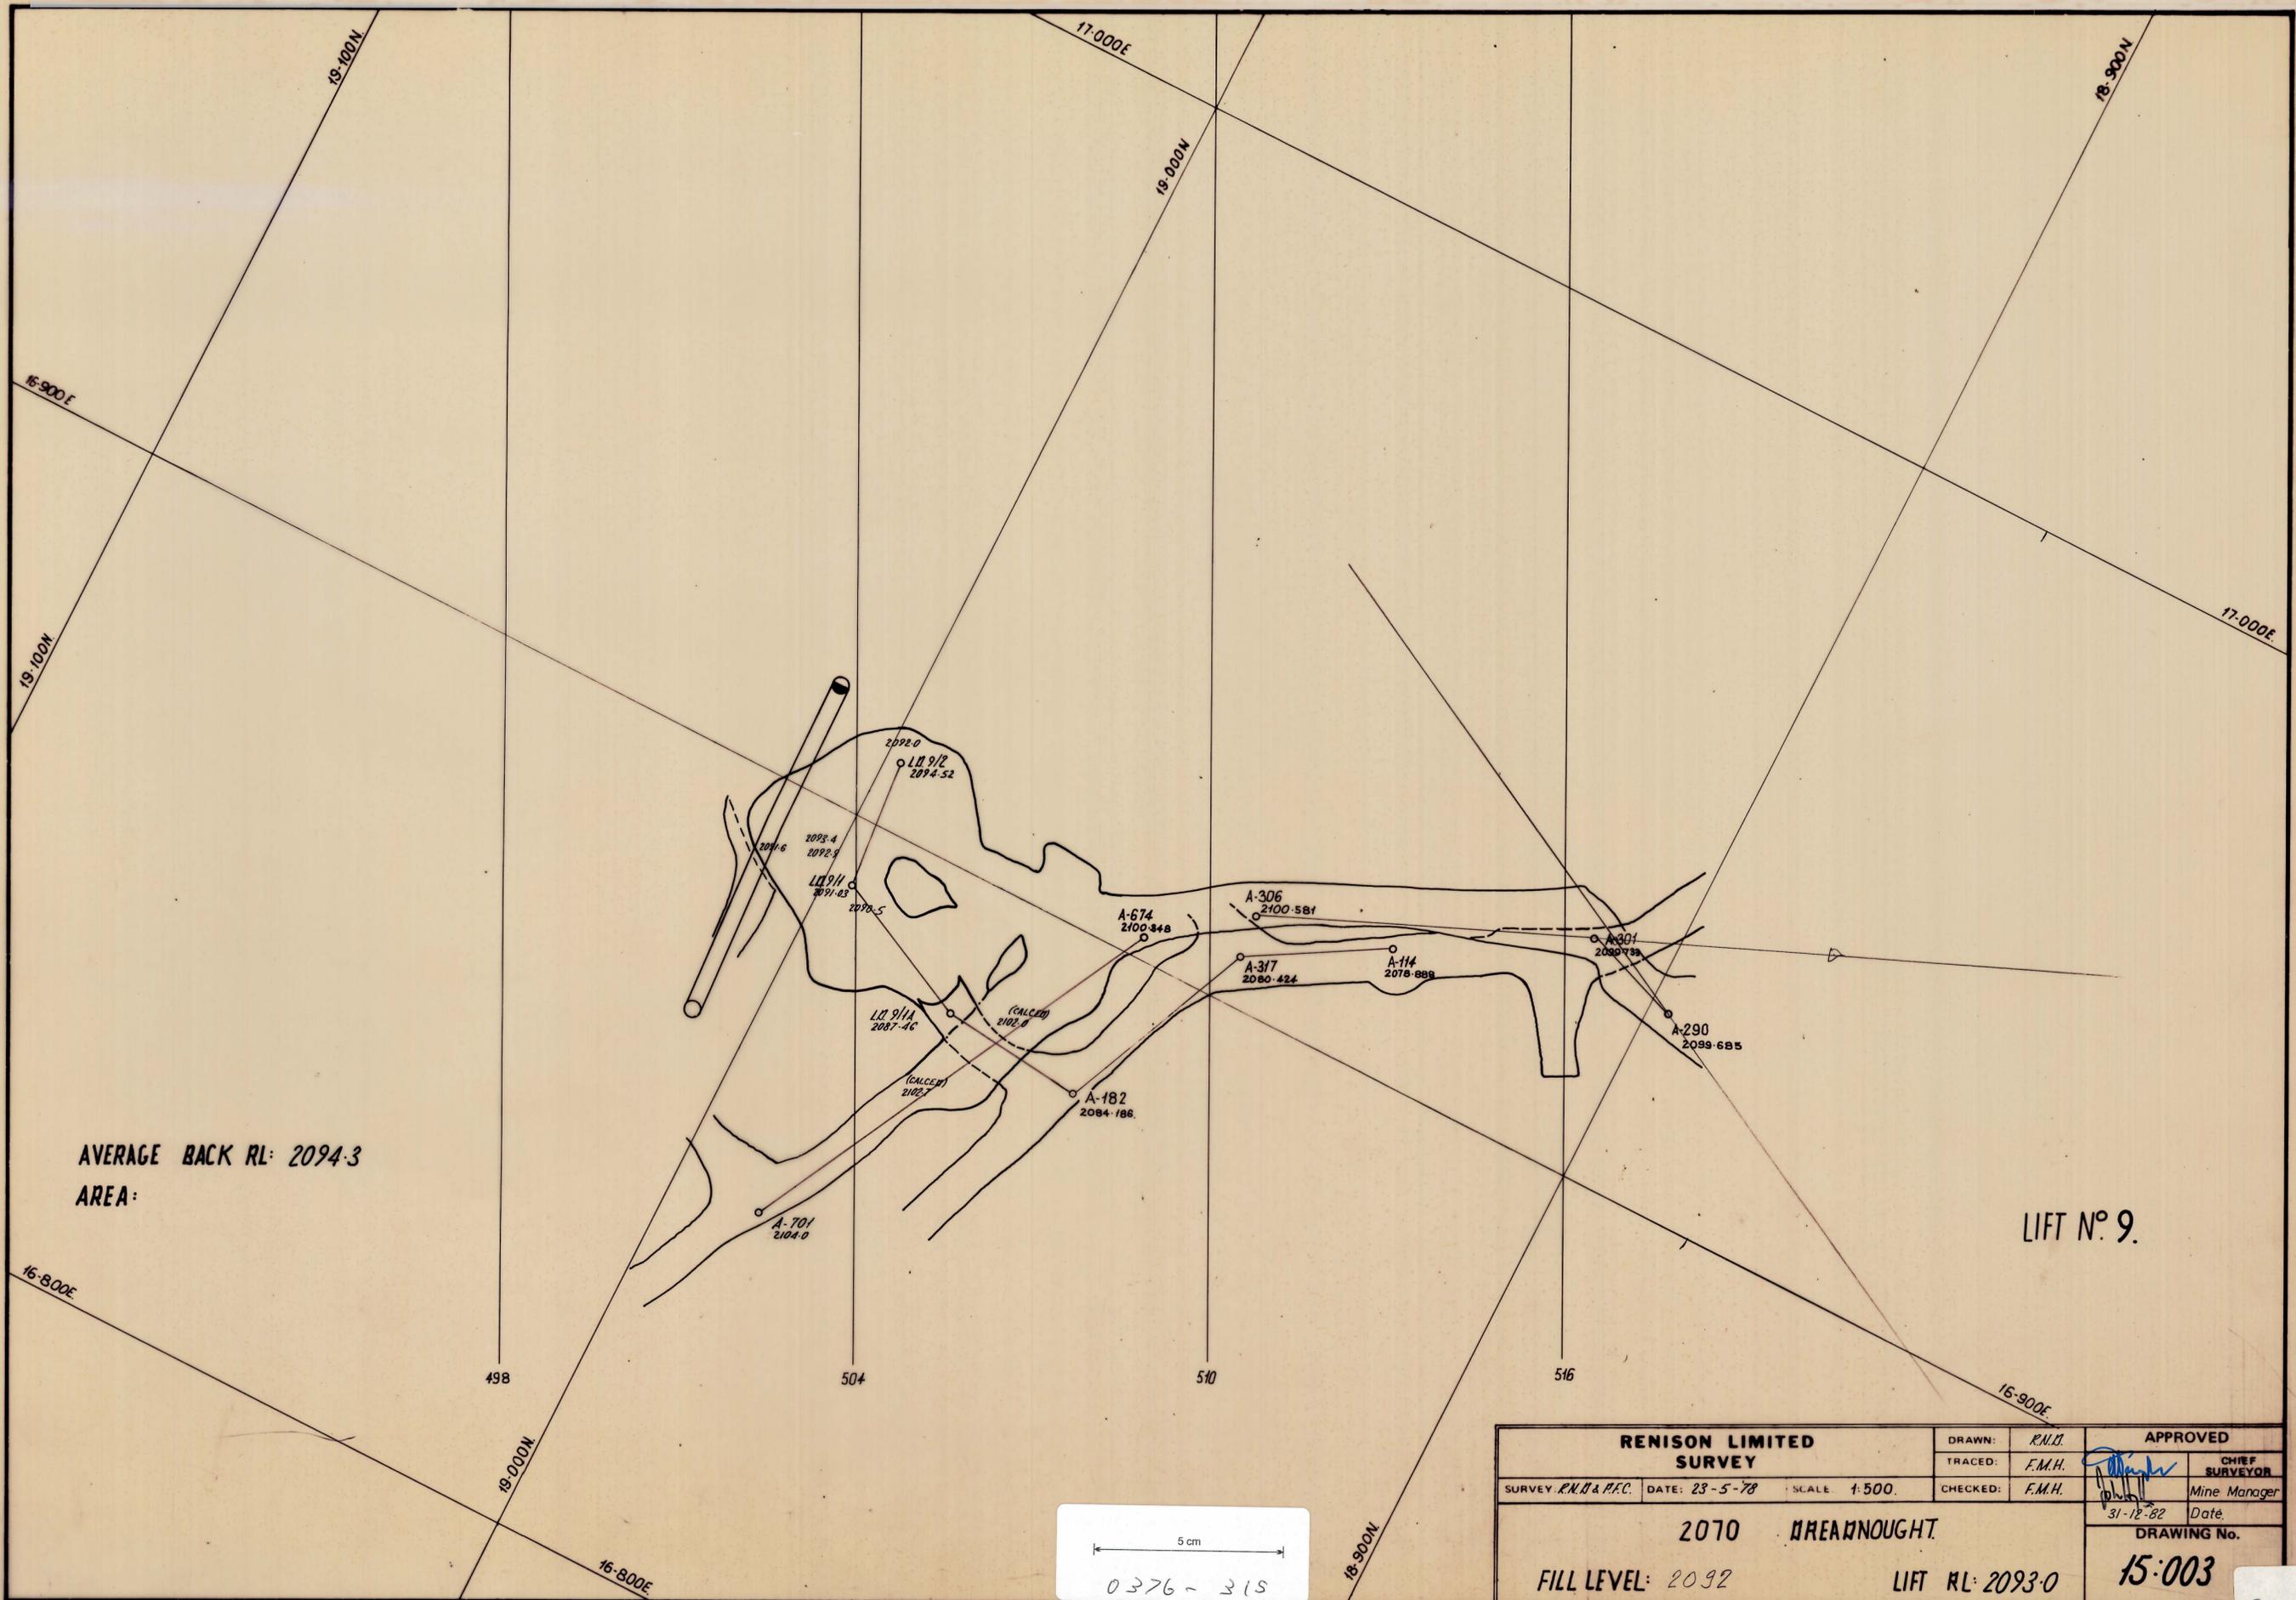

AVERAGE BACK RL: 2094.3
AREA:

LIFT N° 9.

RENISON LIMITED SURVEY		DRAWN: R.M.D.	APPROVED	
SURVEY R.M.D. & P.F.C.		TRACED: F.M.H.	CHIEF SURVEYOR	
DATE: 23-5-78	SCALE: 1:500	CHECKED: F.M.H.	Mine Manager	
2070 DREANNUGHT		31-12-82 Date		DRAWING No.
FILL LEVEL: 2092		LIFT RL: 2093.0		15:003

5 cm
0376-315

83141