


0376-316

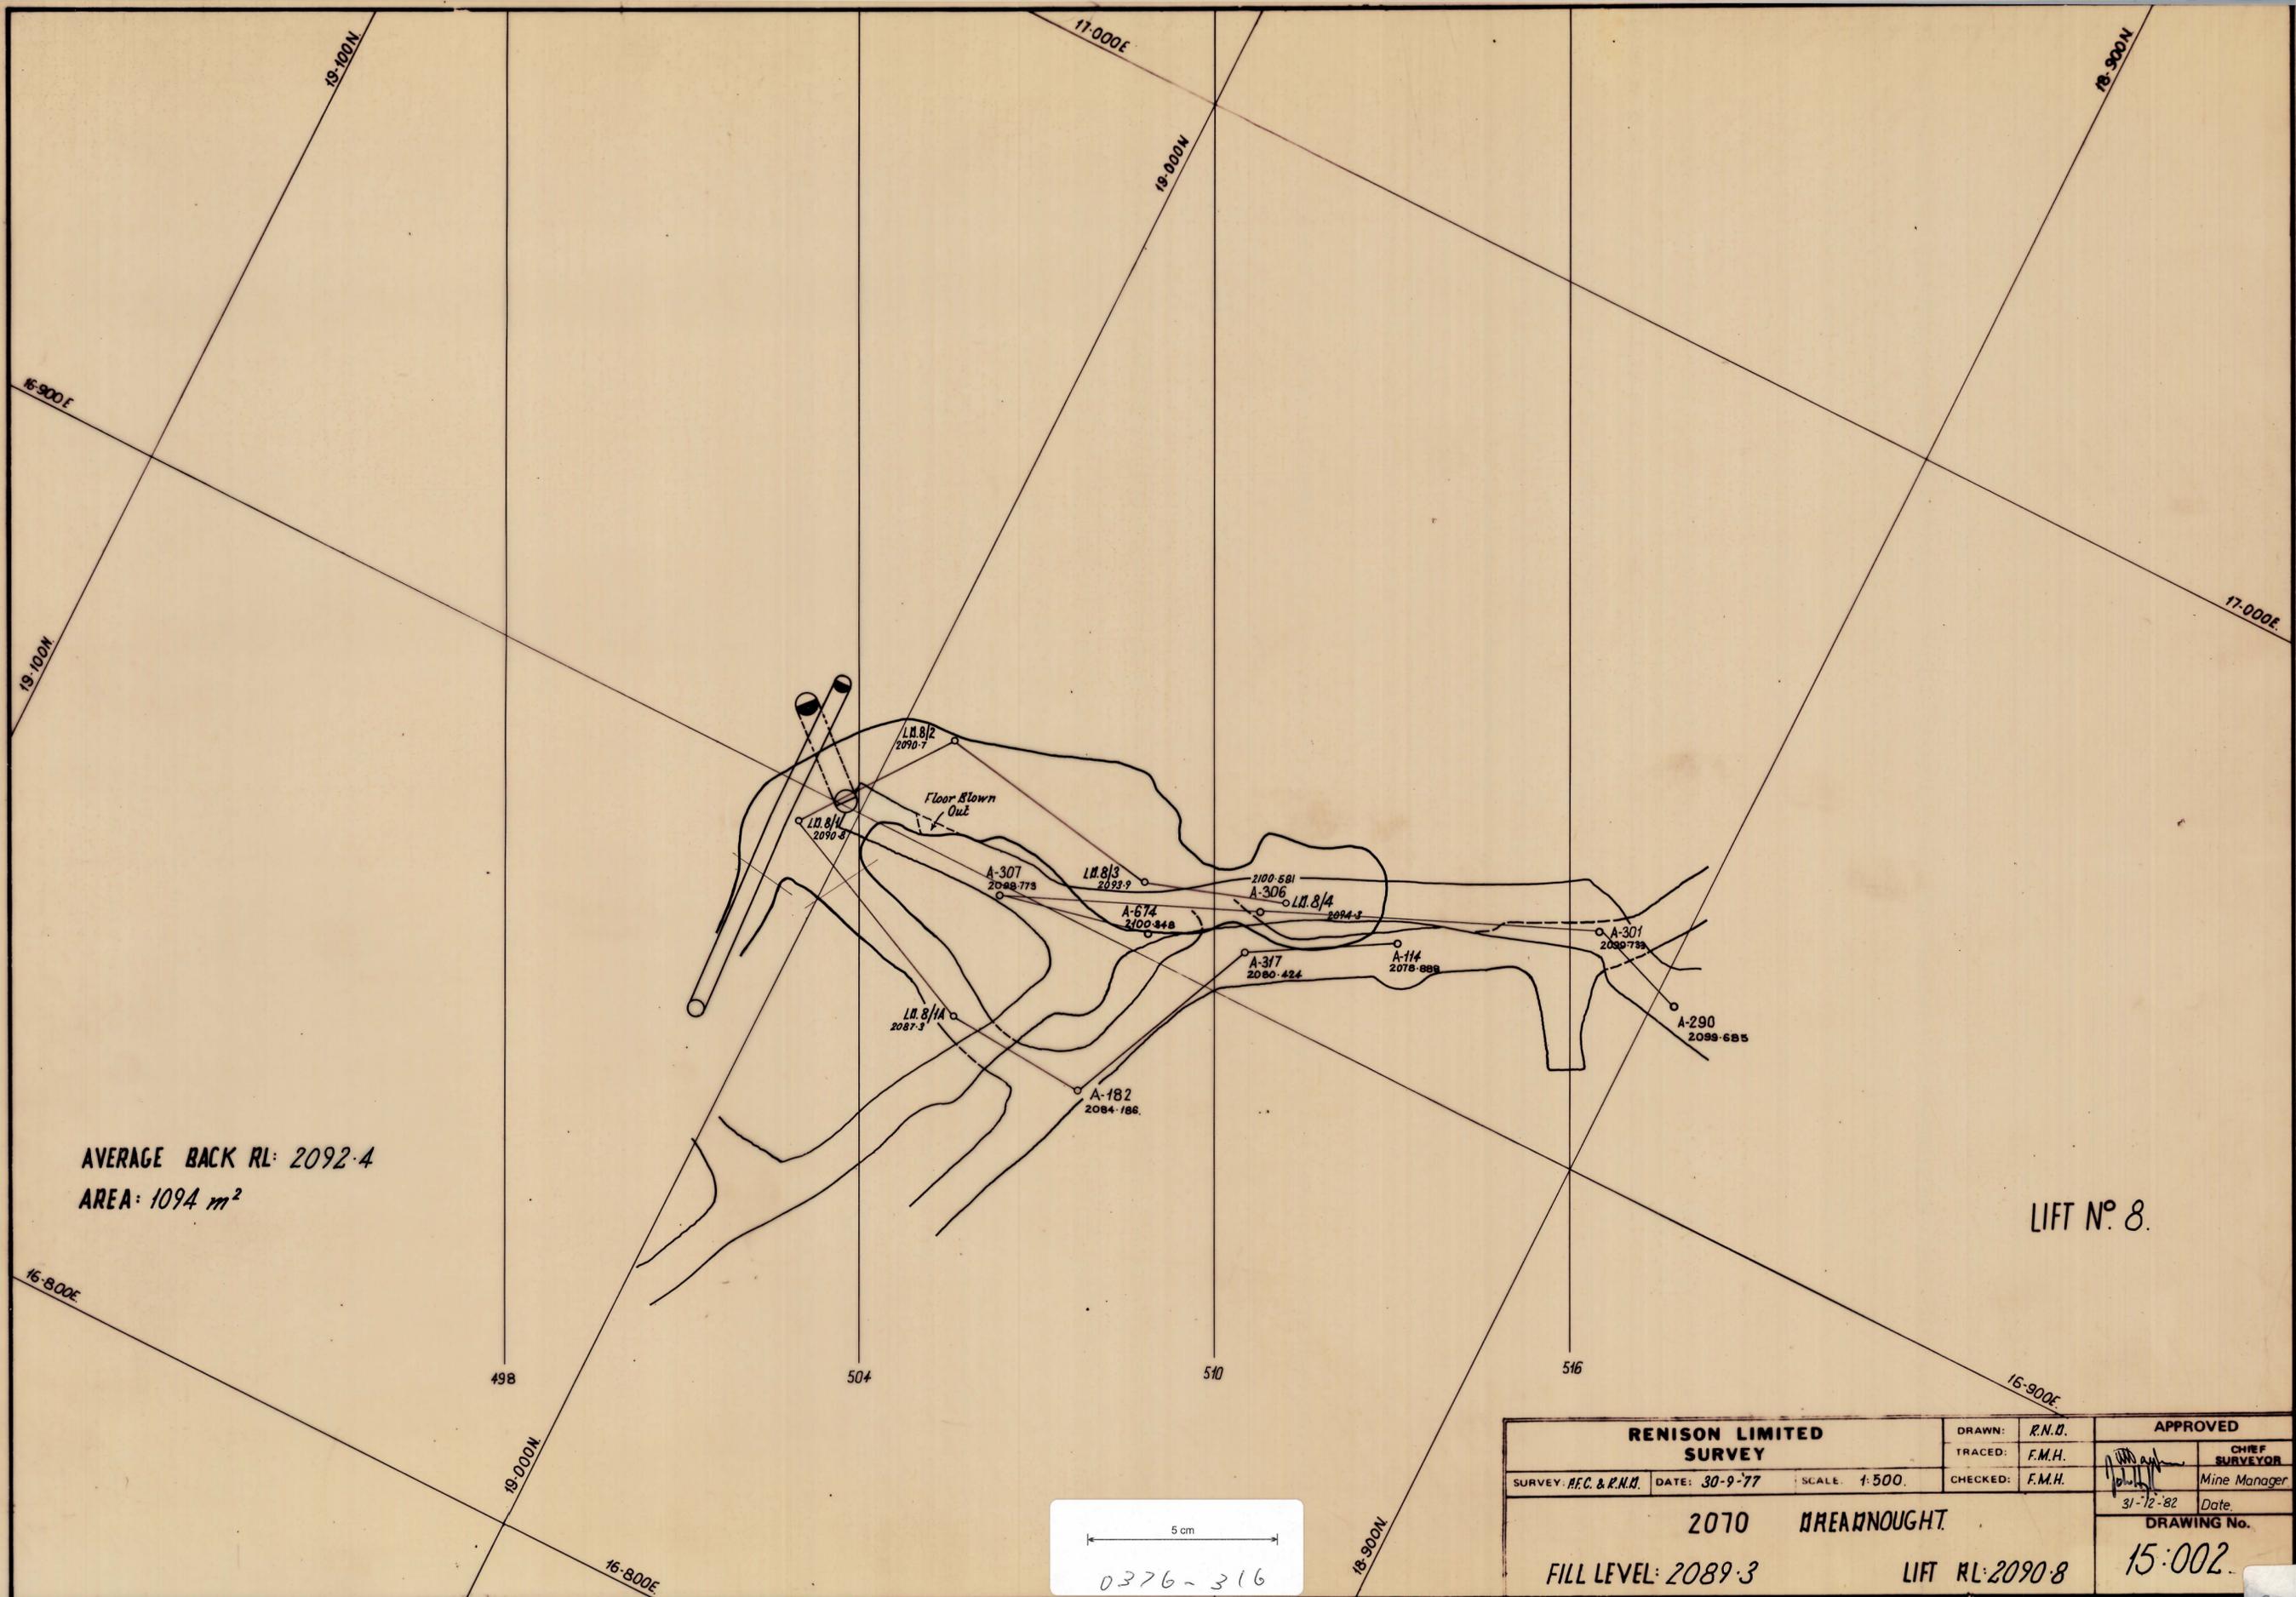

AVERAGE BACK RL: 2092.4
 AREA: 1094 m²

LIFT NO. 8.

5 cm
 0376-316

RENISON LIMITED SURVEY		DRAWN: R.N.D.	APPROVED	
		TRACED: F.M.H.		CHIEF SURVEYOR
SURVEY: REC. & R.N.D.	DATE: 30-9-77	SCALE: 1:500	CHECKED: F.M.H.	Mine Manager
2070 DREAUGHT.			31-12-82	Date
FILL LEVEL: 2089.3			DRAWING No. 15:002	
			LIFT RL: 2090.8	

83140