


0376-319

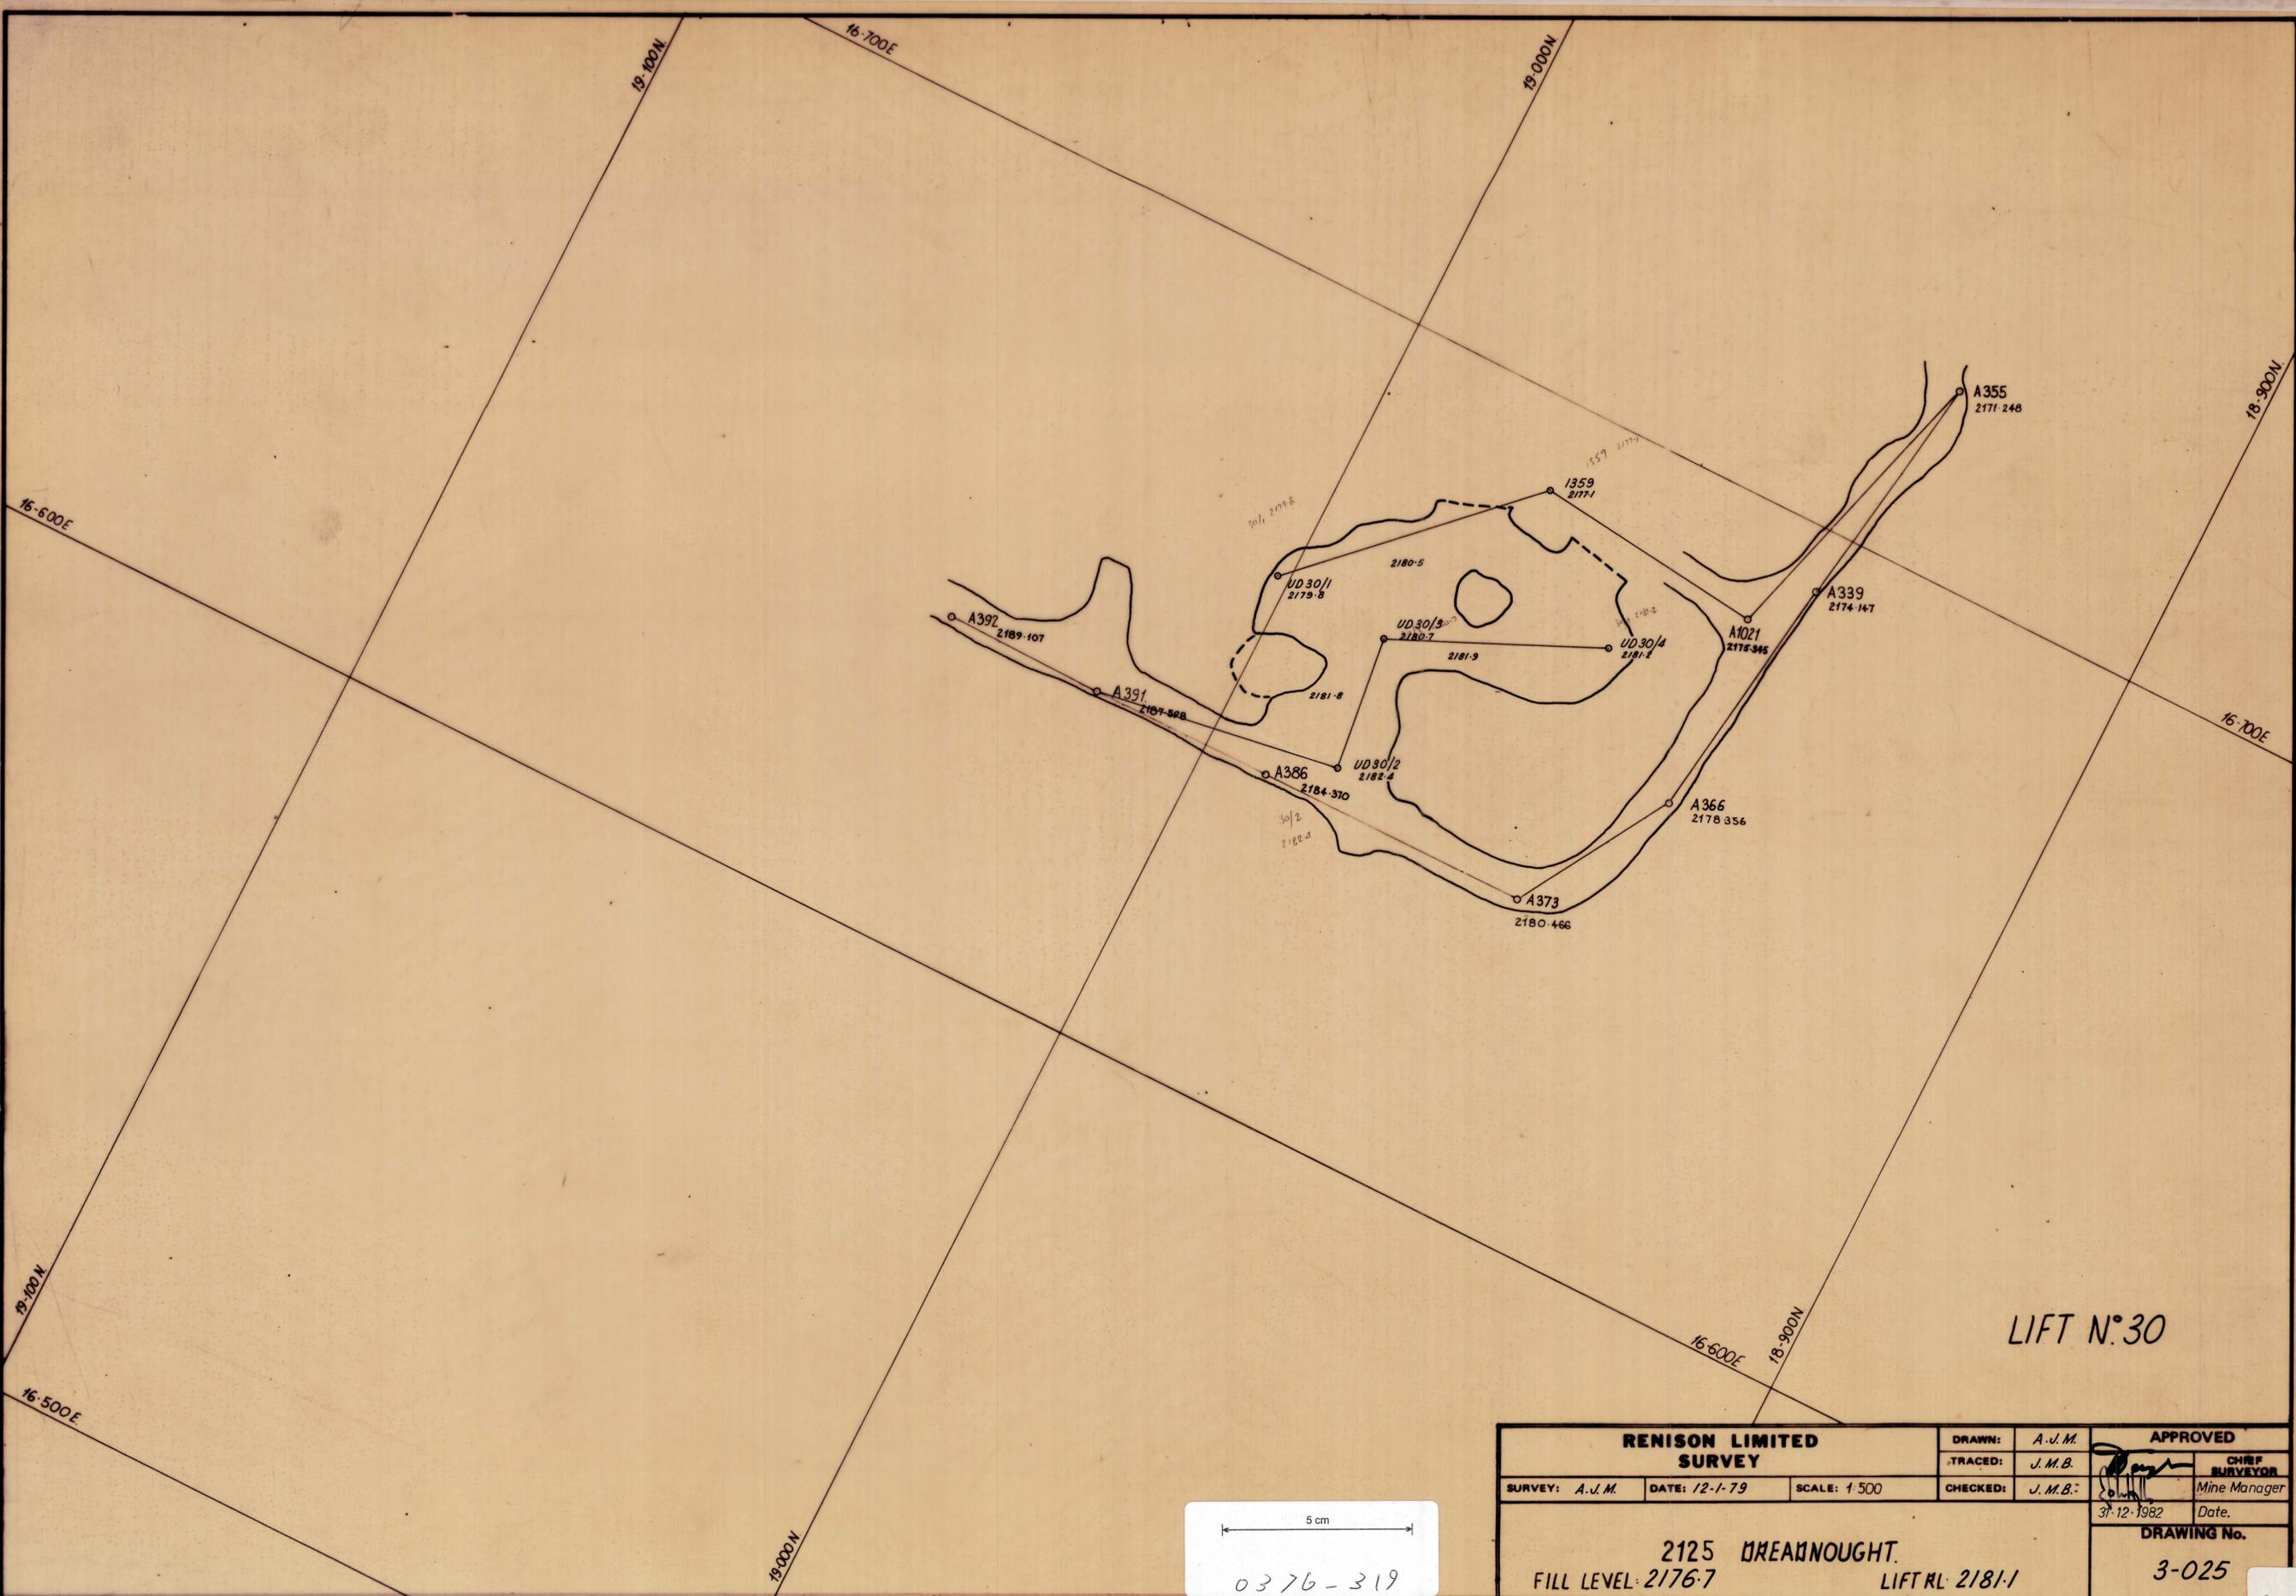

LIFT N°30

5 cm
0376-319

RENISON LIMITED SURVEY			DRAWN: A.J.M.	APPROVED
			TRACED: J.M.B.	CHIEF SURVEYOR
SURVEY: A.J.M.	DATE: 12-1-79	SCALE: 1:500	CHECKED: J.M.B.	Mine Manager
			31-12-1982	Date.
			DRAWING No.	
2125 DREAMNOUGHT. FILL LEVEL: 2176.7			LIFT RL: 2181.1 3-025	

83134