




AVERAGE BACK RL: 2178.4
 AREA: 1910 m²

LIFT N° 29

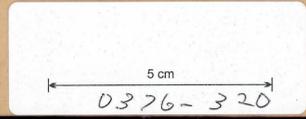

RENISON LIMITED SURVEY			DRAWN: J.K.D.	APPROVED	
			TRACED: R.N.D.	CHIEF SURVEYOR	
SURVEY: R.N.D.	DATE: 9-8-77.	SCALE: 1:500	CHECKED: A.J.M.	Mine Manager	
			31-12-1982		Date
				DRAWING No.	
2125 DREADNOUGHT				3-024	
FILL LEVEL: 2174.4			LIFT RL: 2178.4		

83133