


0376-321

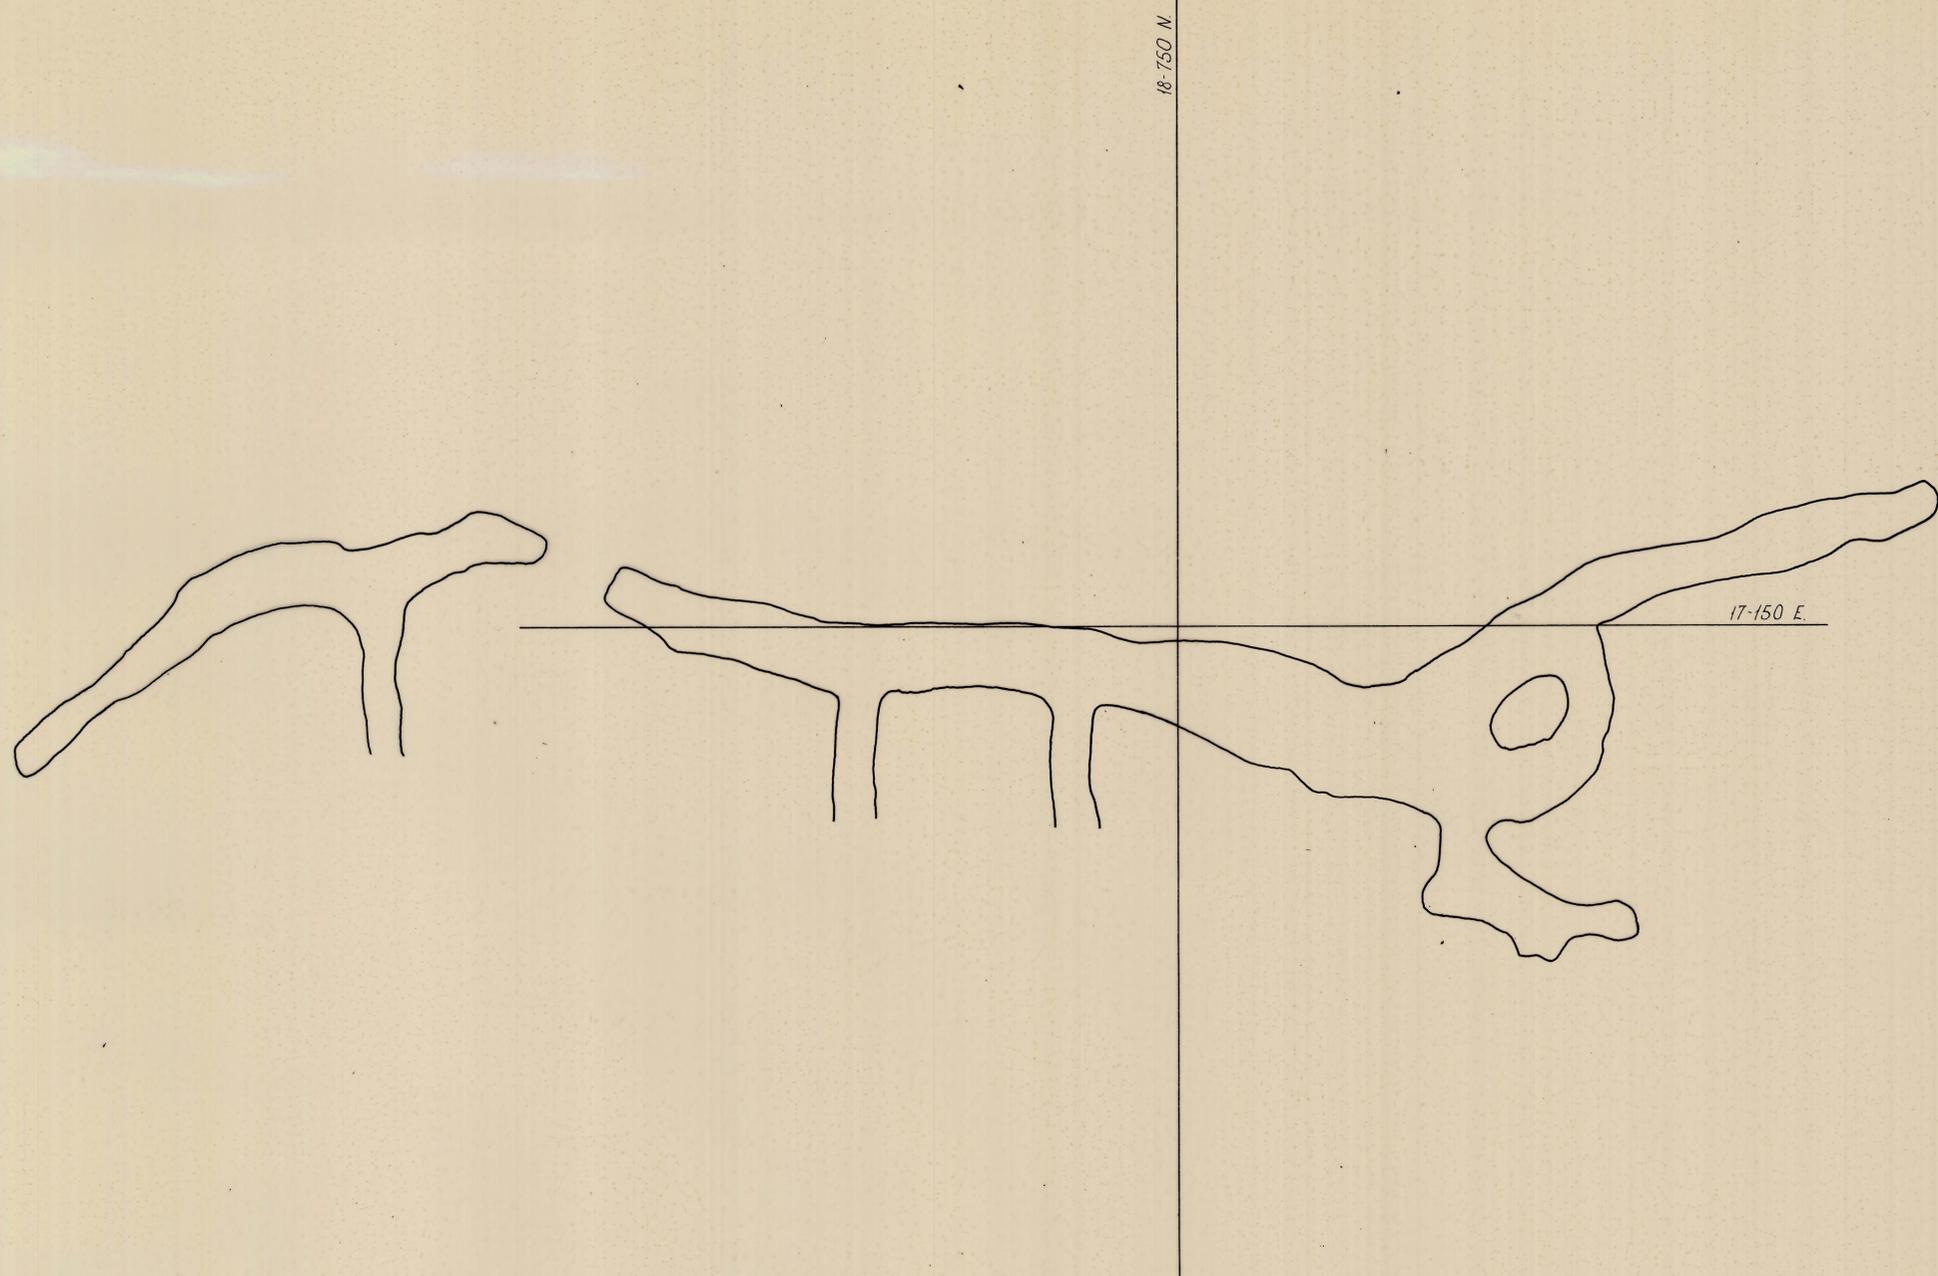

DATE		MANAGER	SURVEYOR	RENISON LIMITED SURVEY.		DRAWING No.
31-12-78				DATE	25-2-77	73:001
31-12-82				SCALE	1:500	
				1900 NORTH STEBBINS.		93091
				LEVEL: 1920.		