


0376-322

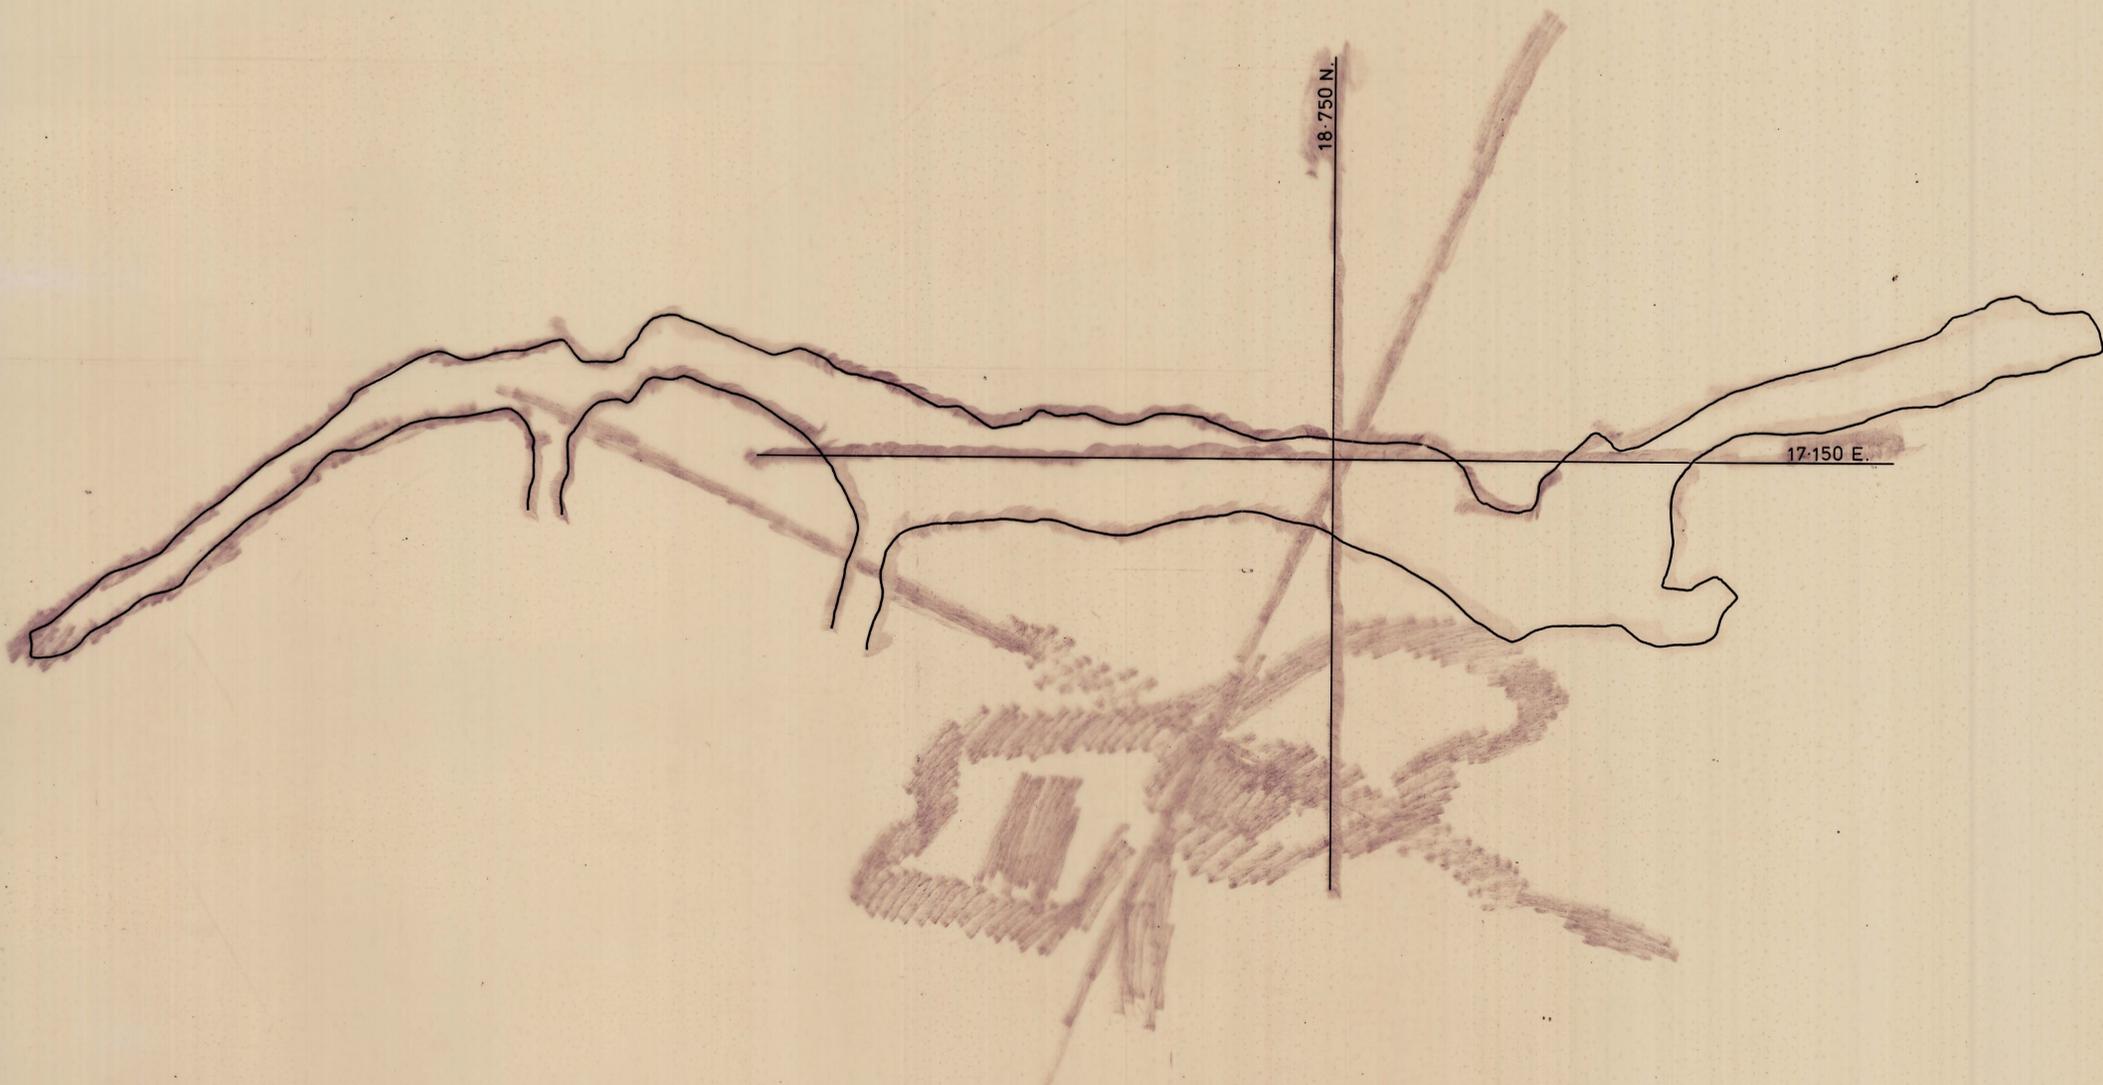

5 cm
0376-322

DATE	MANAGER	SURVEYOR	RENISON LIMITED.		DRAWING No.
31-12-75			SURVEY.		
31-12-82	<i>[Signature]</i>	<i>[Signature]</i>	DRAWN: F.M.H.	DATE: 10-12-75	SCALE: 1-500
			1900 NORTH STEBBINS		73:001
			LEVEL: 1912.		

83096