


0376-323

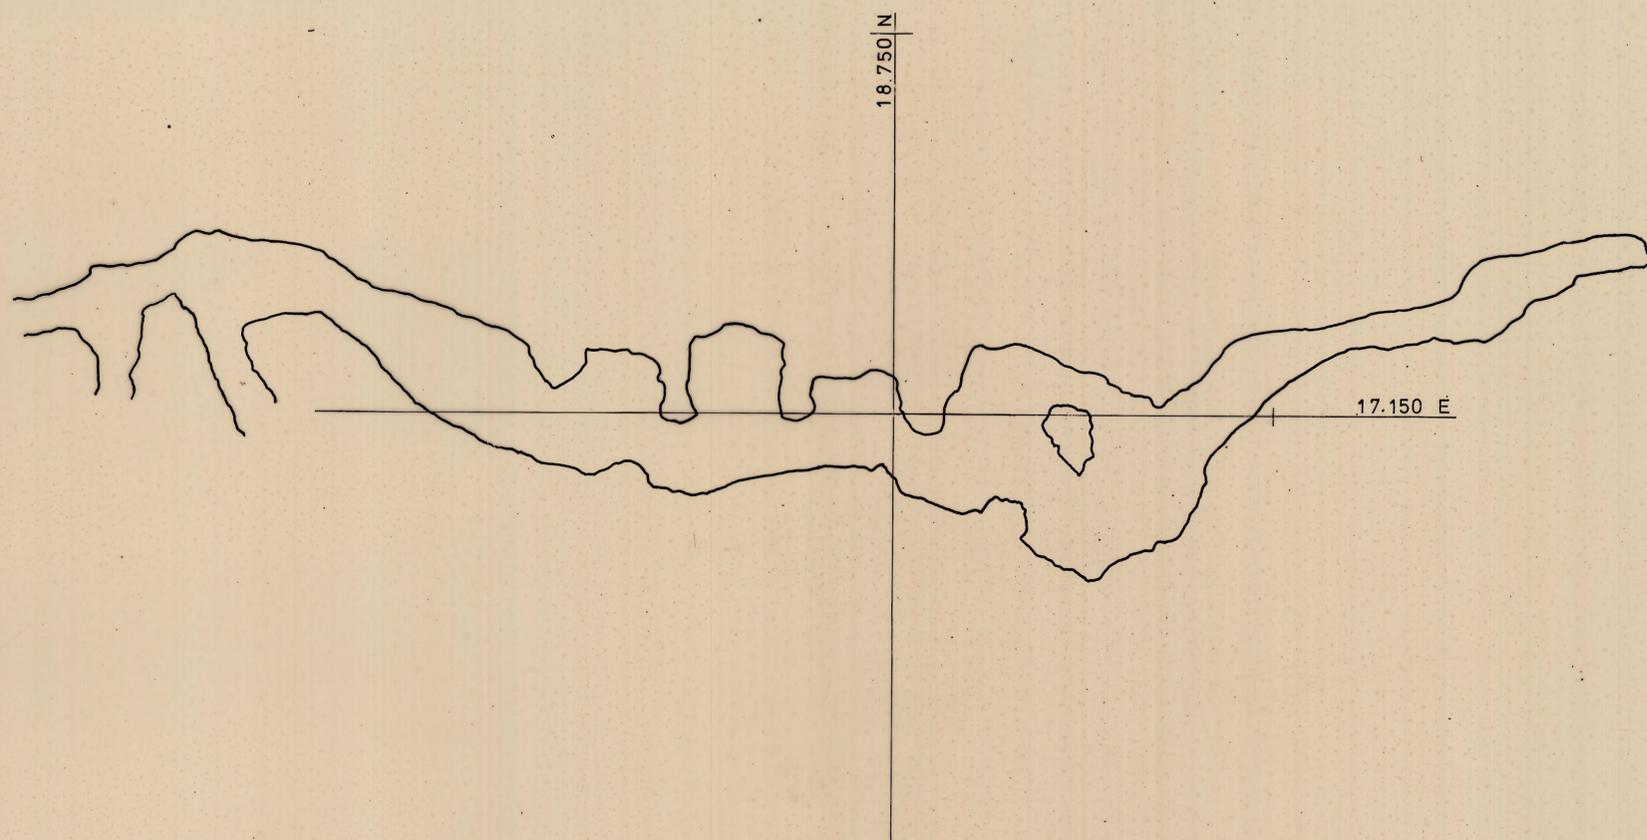

5 cm  
0376-323

DATE	MANAGER	SURVEYOR	RENISON LIMITED SURVEY.		DRAWING No.
31-12-74					73:001
31-12-82	<i>[Signature]</i>	<i>[Signature]</i>	DRAWN: A. J. M.	DATE: 9-12-74 SCALE: 1: 500	
			1900 NORTH STEBBINS LEVEL: 1906		

83095