


0376-324

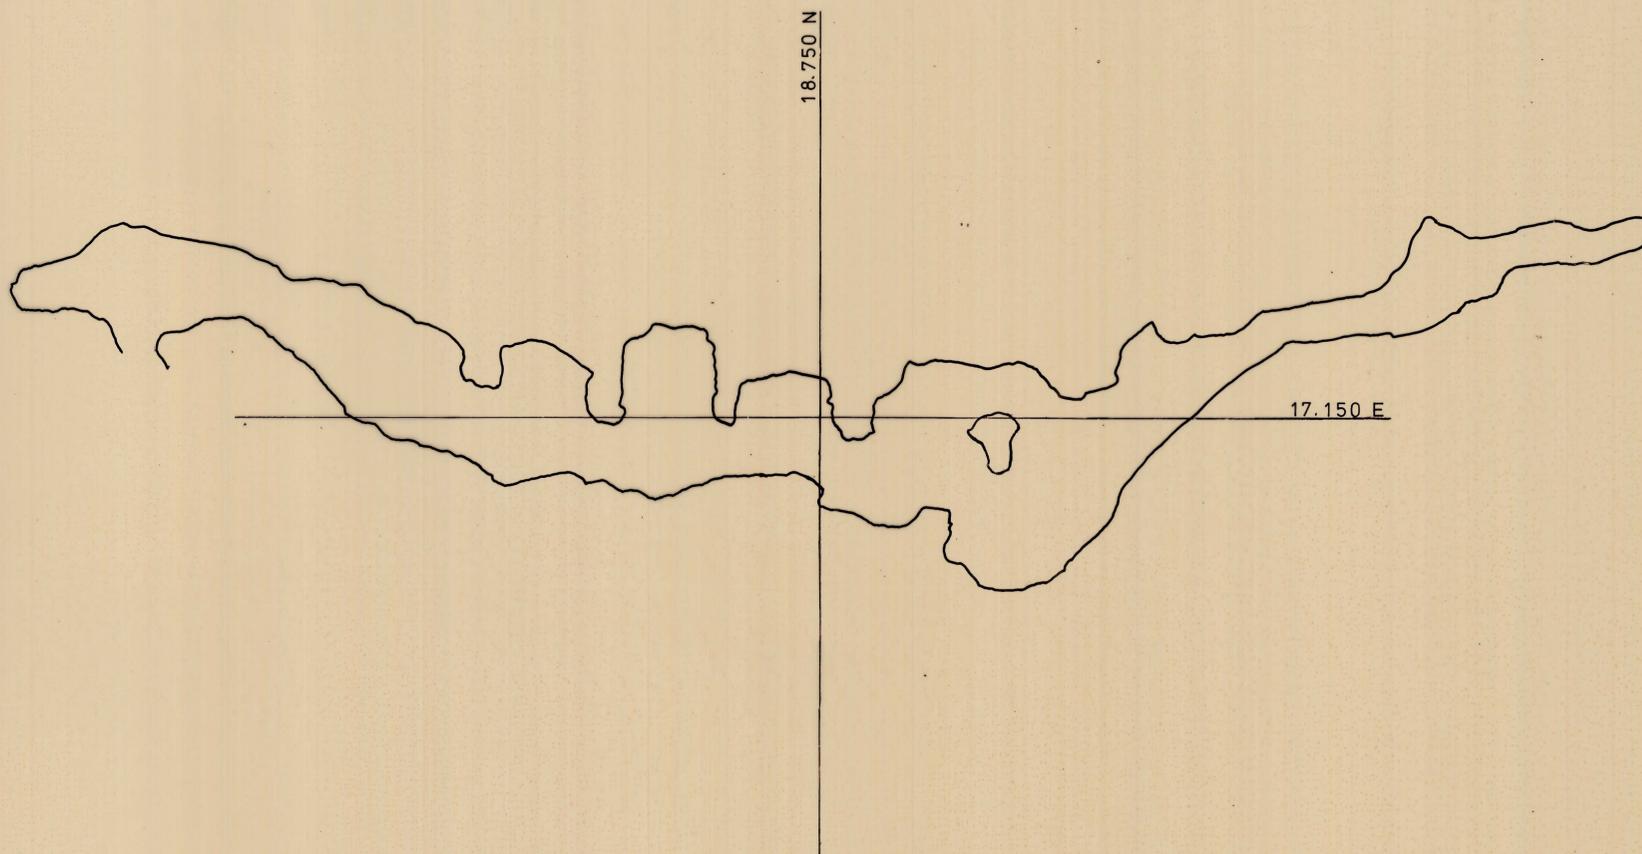

5 cm
0376-324

DATE	MANAGER	SURVEYOR	RENISON LIMITED SURVEY			DRAWING No.
31-12-74						73:001
31-12-82	<i>J. H. H.</i>	<i>W. J. H.</i>	DRAWN: A. J. M.	DATE: 9. 12. 74.	SCALE: 1:500	
			1900 NORTH STEBBINS LEVEL: 1904			

83094