


0376-325

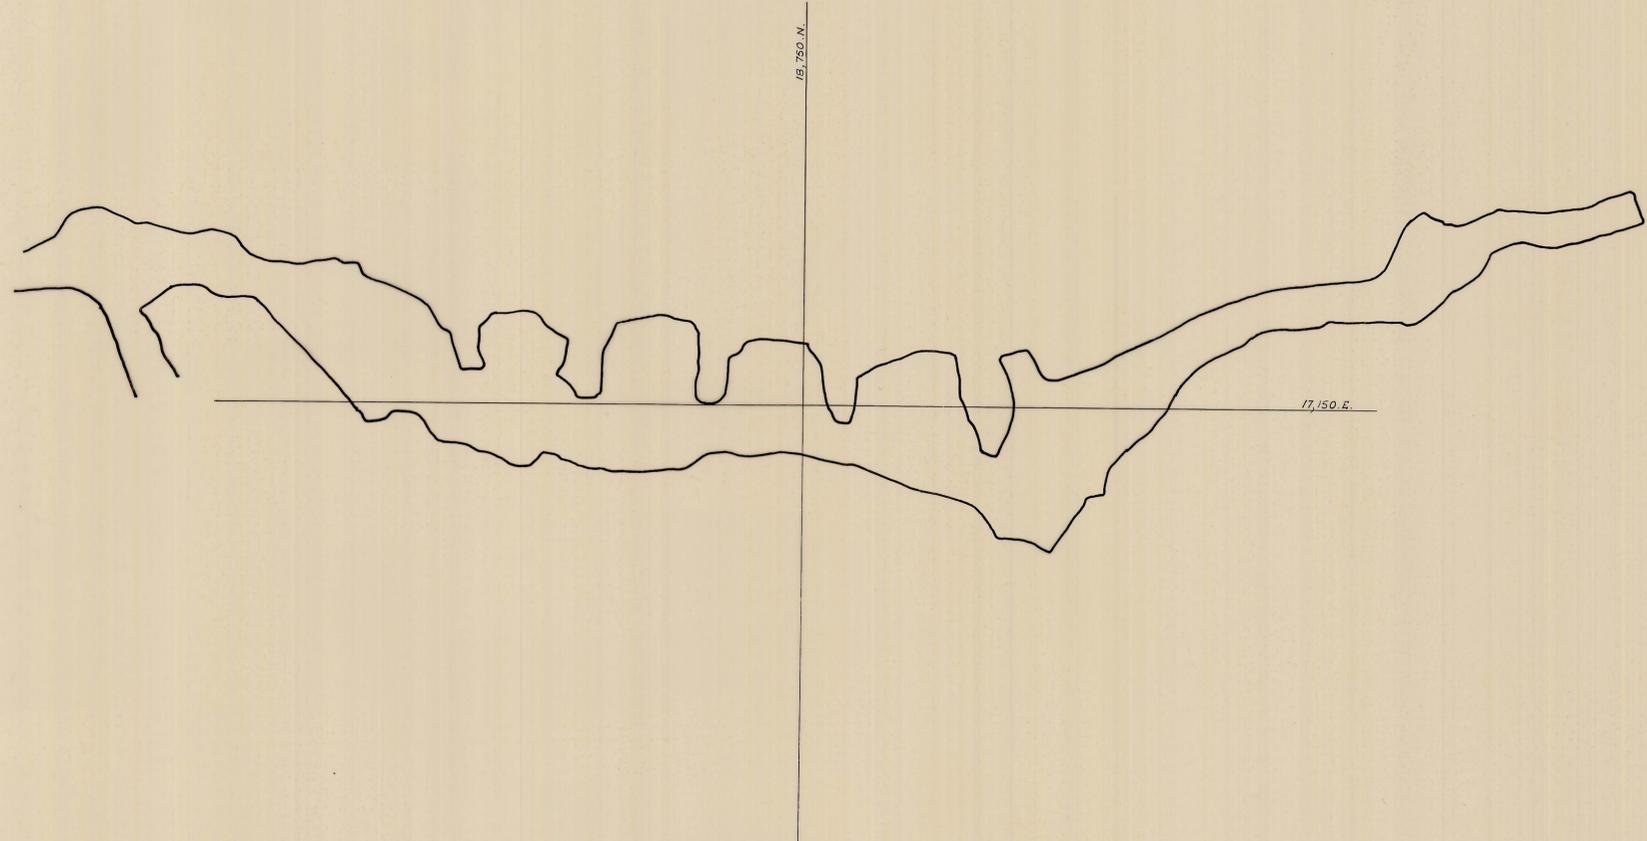

5 cm
0376-325

DATE	MANAGER	SURVEYOR	RENISON LIMITED SURVEY			DRAWING NO.
31-12-82			DRAWN: P.V.K.	DATE: 7-3-74	SCALE: 1:500	73:001.
			1900 NORTH STEBBINS.			
			LEVEL: 1900.0			

83093