


0376-326

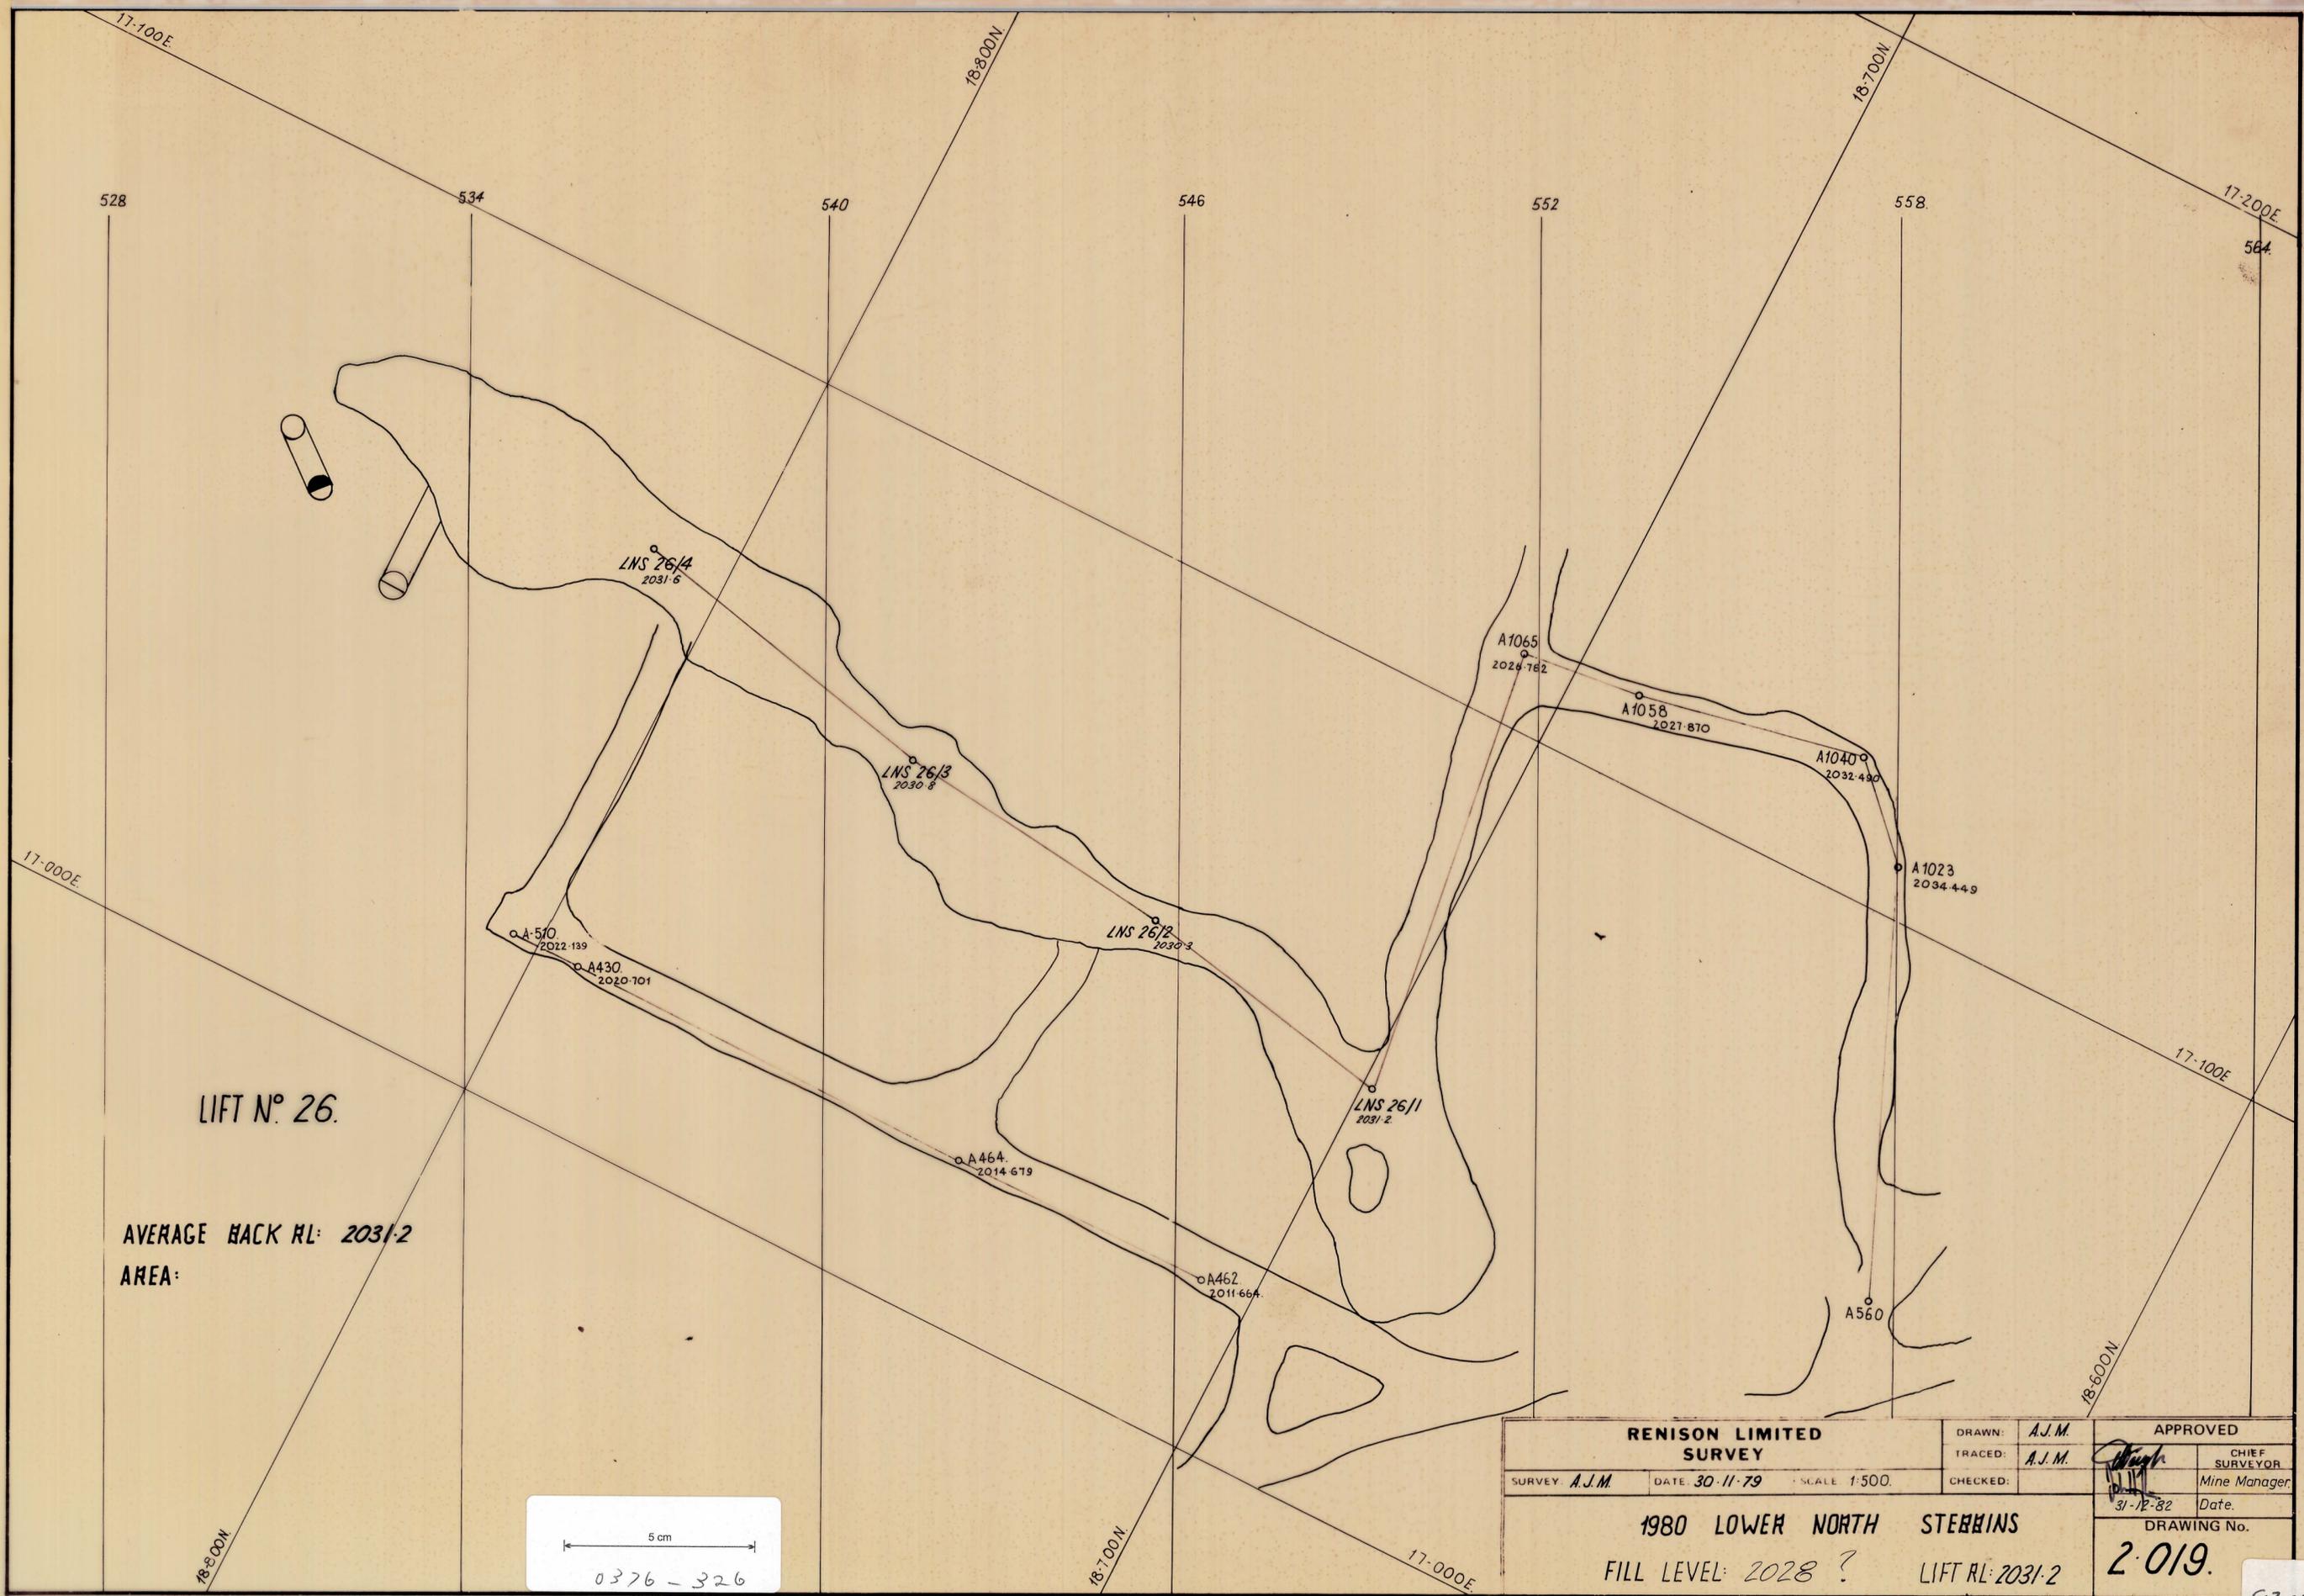

LIFT N° 26.

AVERAGE BACK RL: 2031.2  
AREA:

5 cm  
0376-326

<b>RENISON LIMITED SURVEY</b>		DRAWN: A.J.M.	APPROVED
		TRACED: A.J.M.	CHIEF SURVEYOR
SURVEY: A.J.M.	DATE: 30-11-79	SCALE: 1:500	Checked: <i>[Signature]</i> 31-12-82 Date.
1980 LOWER NORTH STEBBINS			DRAWING No.
FILL LEVEL: 2028 ?			LIFT RL: 2031.2
			2-019.

83092