



0376-327

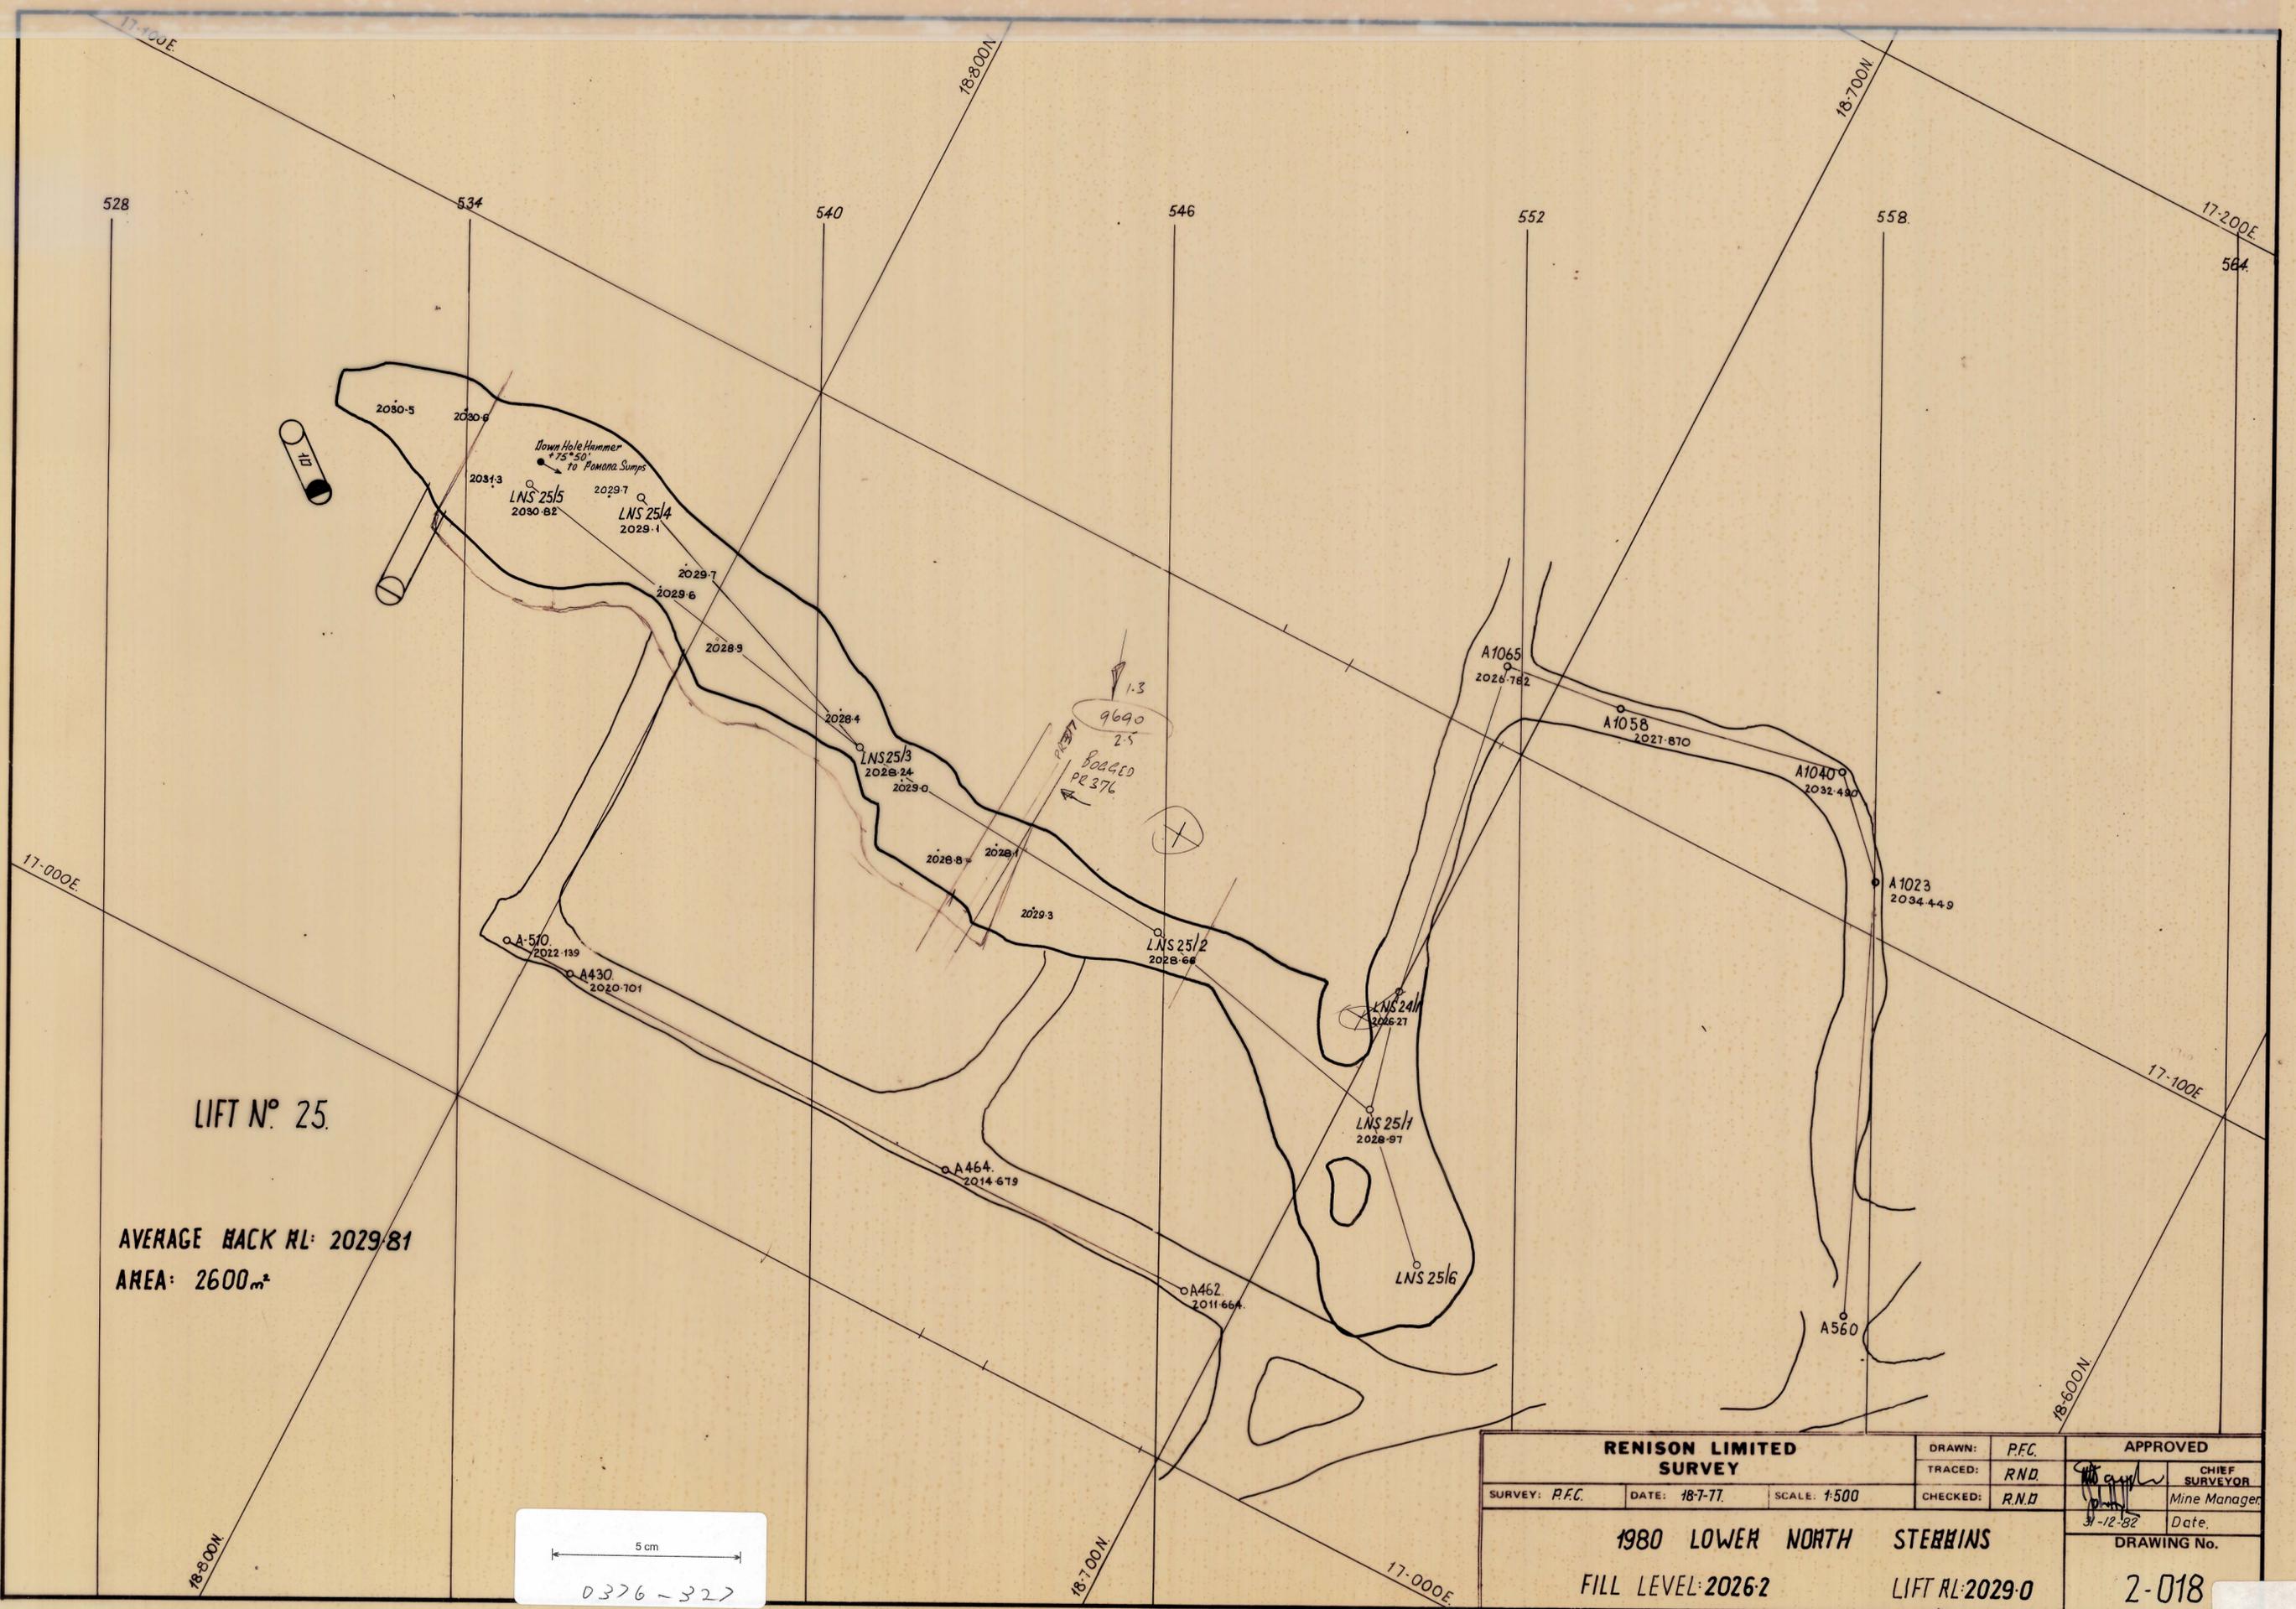

LIFT N° 25.

AVERAGE BACK RL: 2029.81
AREA: 2600 m²

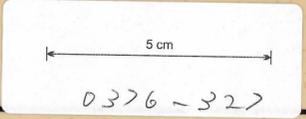

RENISON LIMITED SURVEY			DRAWN: P.F.C.	APPROVED <i>[Signature]</i> CHIEF SURVEYOR
			TRACED: R.N.D.	
SURVEY: P.F.C.	DATE: 18-7-77	SCALE: 1:500	CHECKED: R.N.D.	Date: 31-12-82
1980 LOWER NORTH STEBBINS			DRAWING No.	
FILL LEVEL: 2026.2			LIFT RL: 2029.0	
			2-018	

83091