


0376-329

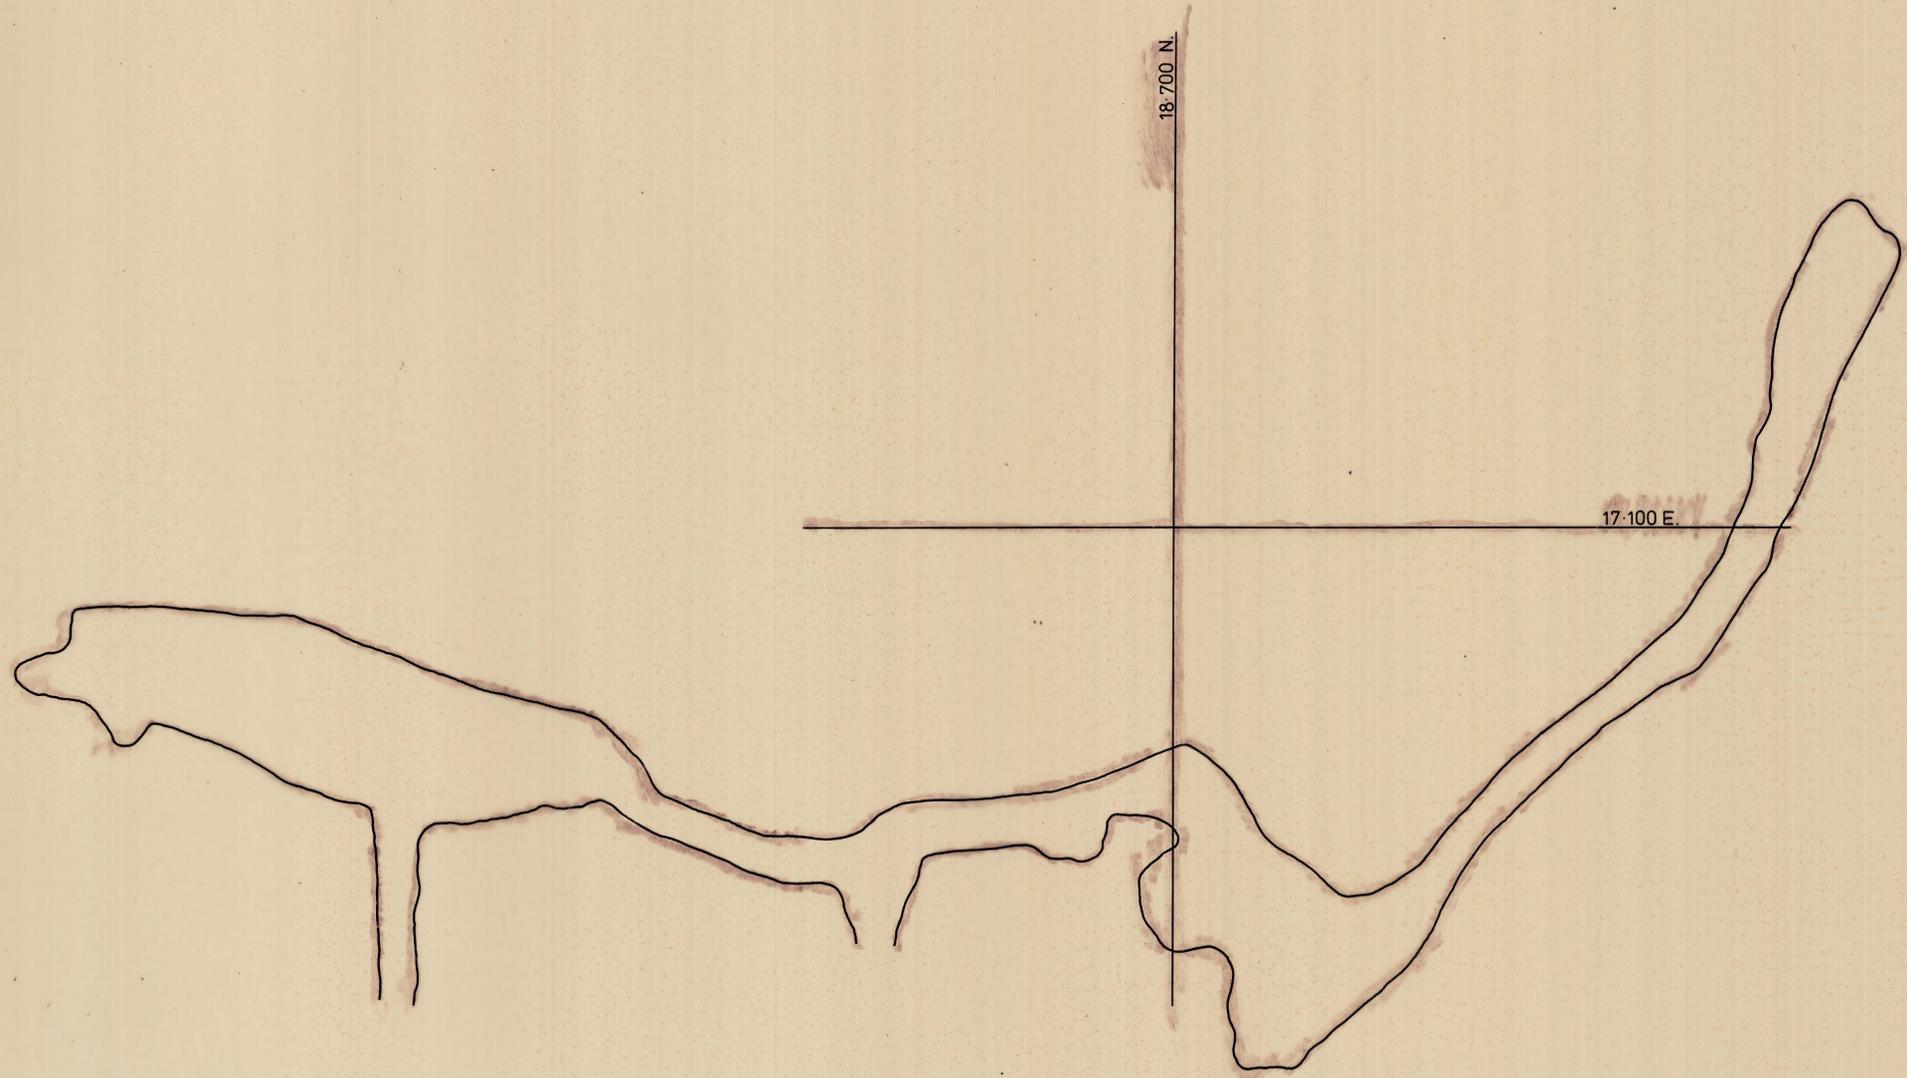

5 cm  
0376-329

DATE	MANAGER	SURVEYOR	RENISON LIMITED. SURVEY.		DRAWING No.
31-12-75					22-079
31-12-82	<i>J.H.H.</i>	<i>M.H.H.</i>	DRAWN: F.M.H.	DATE: 10-12-75 SCALE: 1:500.	
			LOWER NORTH STEBBINS STOPE. FILL LEVEL: 2016-5.		

53087