


0376-330

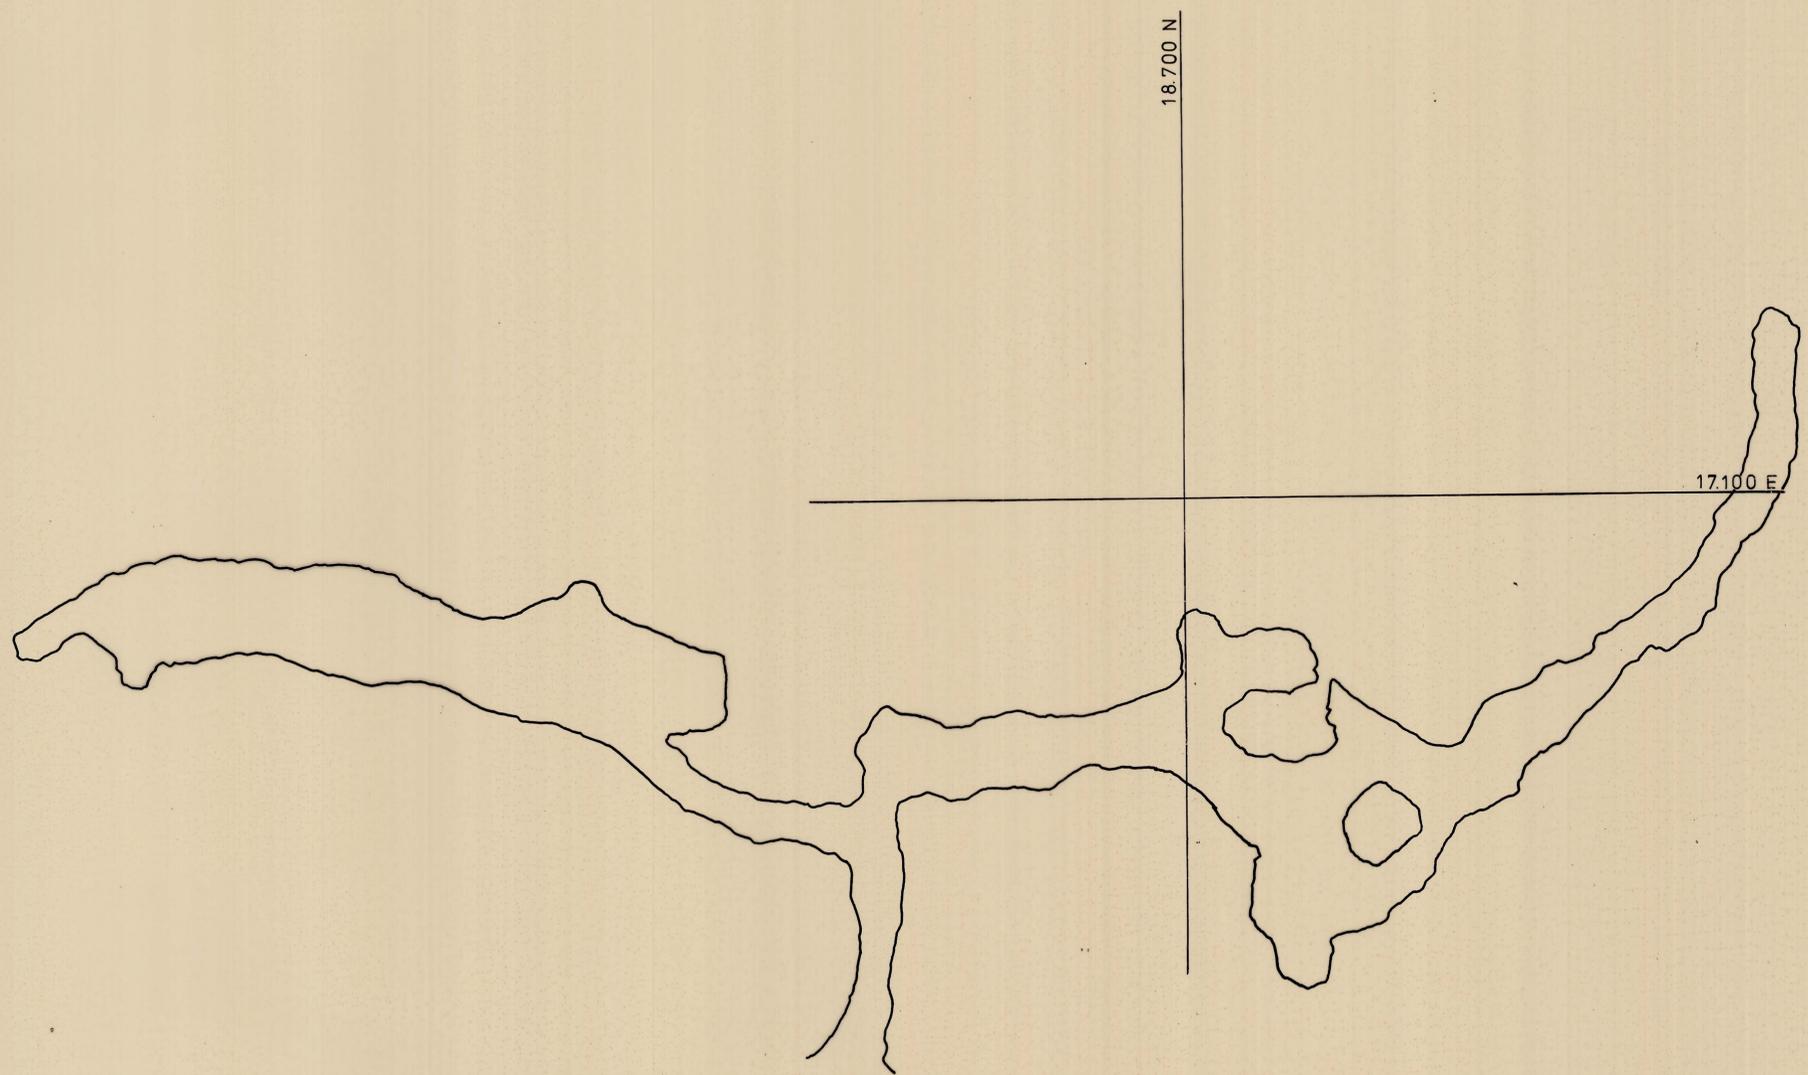

5 cm

0376-330

REINSON LIMITED SURVEY			DRAWING No.	
DATE	MANAGER.	SURVEYOR.	DATE.	SCALE.
31-12-74			3-10-74	1:500
31-12-82	<i>[Signature]</i>	<i>[Signature]</i>		
LOWER NORTH STEBBINS STOPE			22:079	
LEVEL 2009				

83088