


0376-331

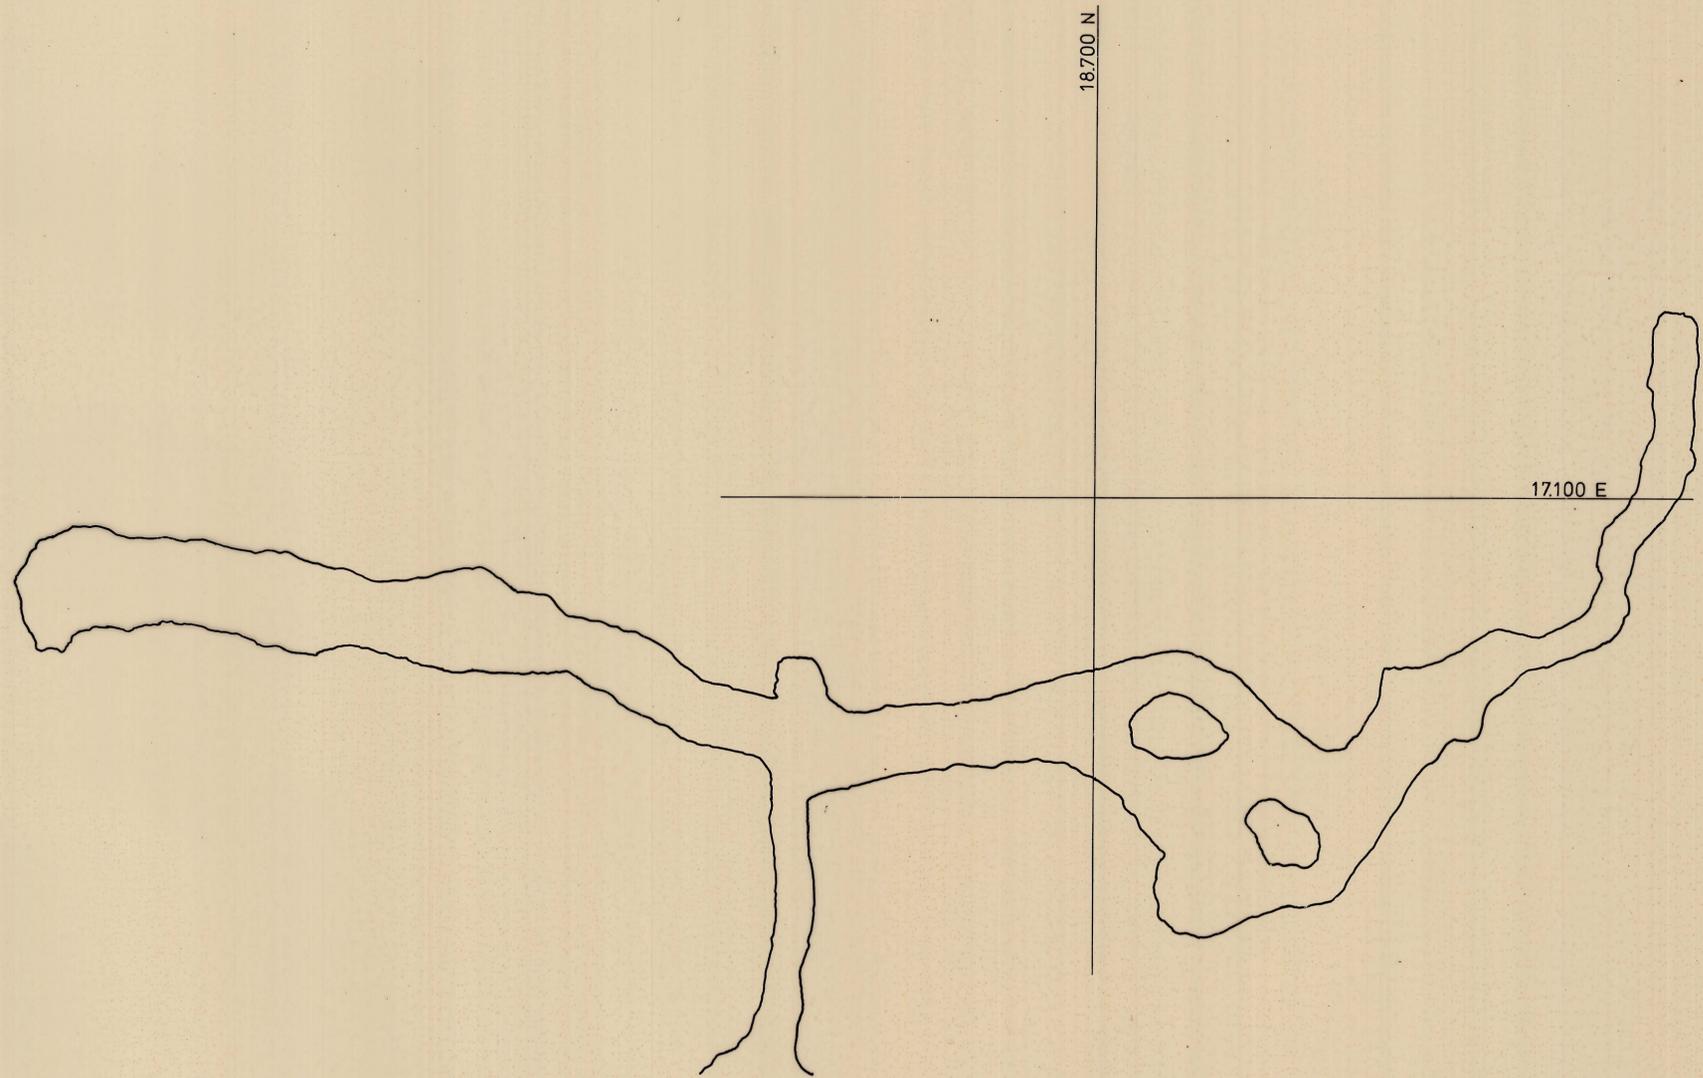

5 cm

0376-331

DATE	MANAGER	SURVEYOR	RENISON LIMITED			DRAWING No.
31-12-74			SURVEY			
31-12-82	<i>[Signature]</i>	<i>[Signature]</i>	DRAWN: A.J.M.	DATE: MARCH '74	SCALE 1:500	22:079
			LOWER NORTH STEBBINS STOPE			
			LEVEL 2005			

83087