


0376-333

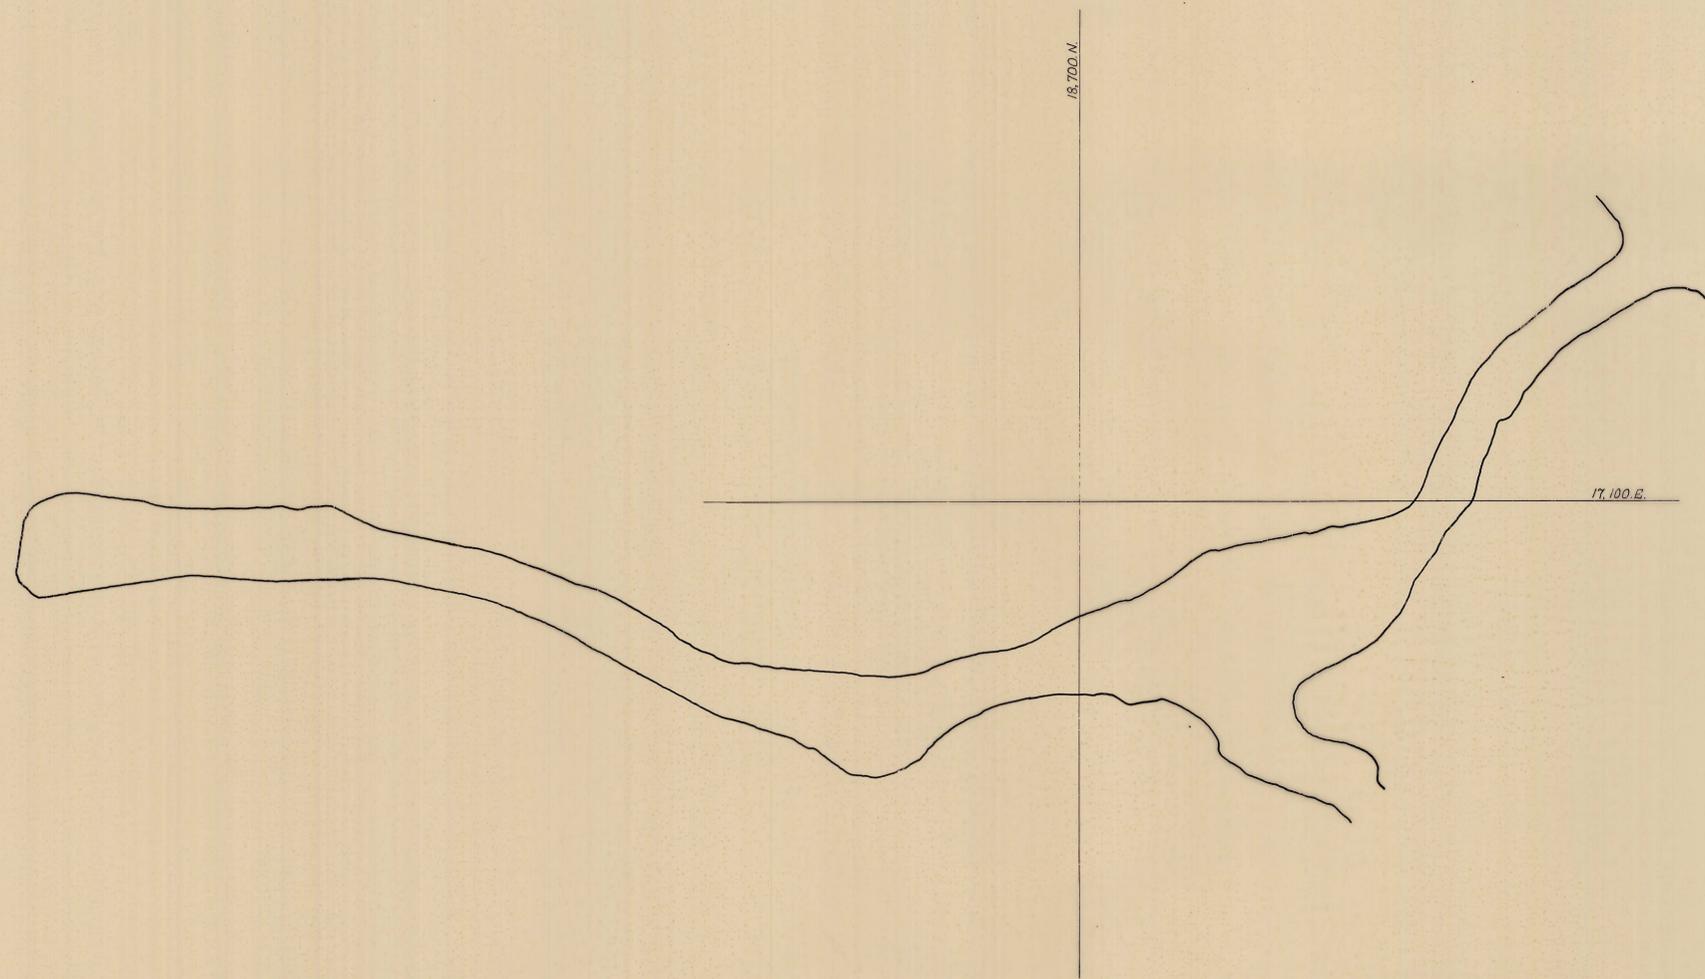

5 cm
0376-333

DATE	MANAGER	SURVEYOR	RENISON LIMITED		DRAWING N°
31-12-82	<i>[Signature]</i>	<i>[Signature]</i>	SURVEY		22:079
			DRAWN: P.W.K.	DATE: 7-3-73	SCALE: 1:500
			LOWER NORTH STEBBINS STOPE		
			LEVEL 1995		

83085