


0376-335

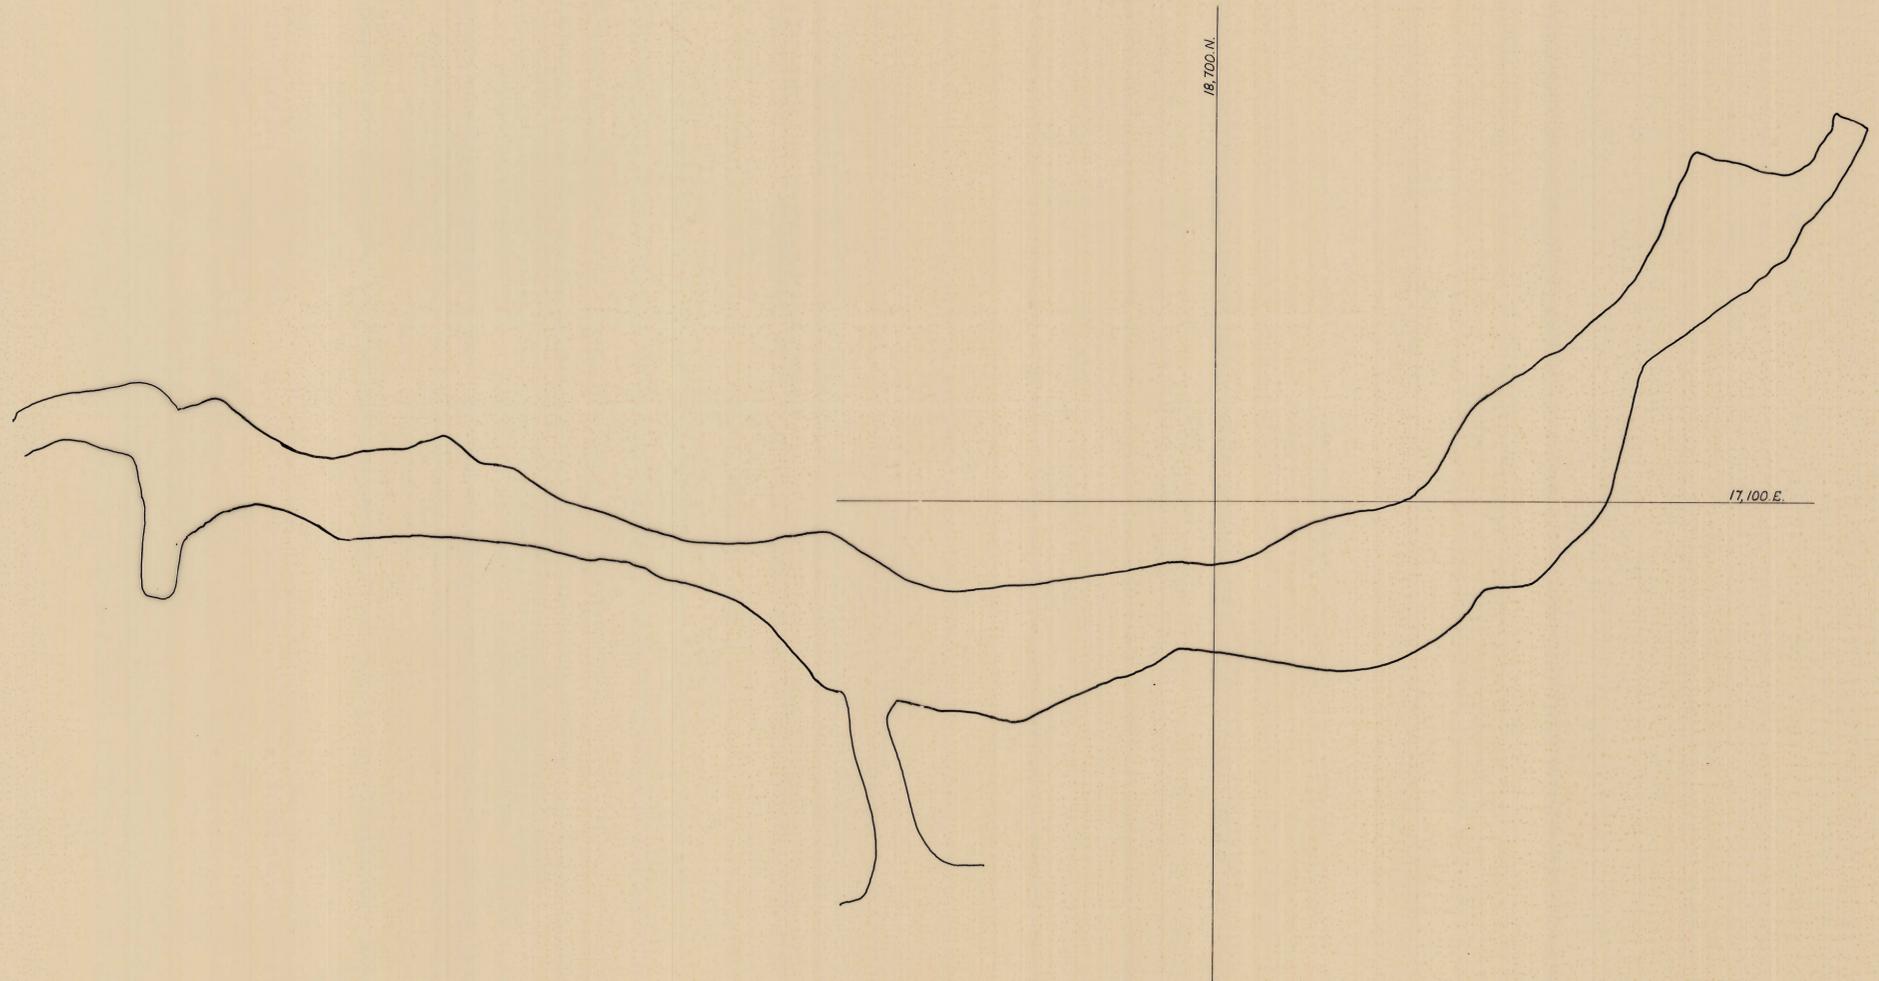

5 cm
0376-335

DATE	MANAGER	SURVEYOR	RENISON LIMITED SURVEY			DRAWING NO.
31-12-82	<i>[Signature]</i>	<i>[Signature]</i>	DRAWN: P.W.K.	DATE: 7-3-73	SCALE: 1:500	22:079
			LOWER NORTH STEBBINS STOPE LEVEL 1980			

83083