


0376-336

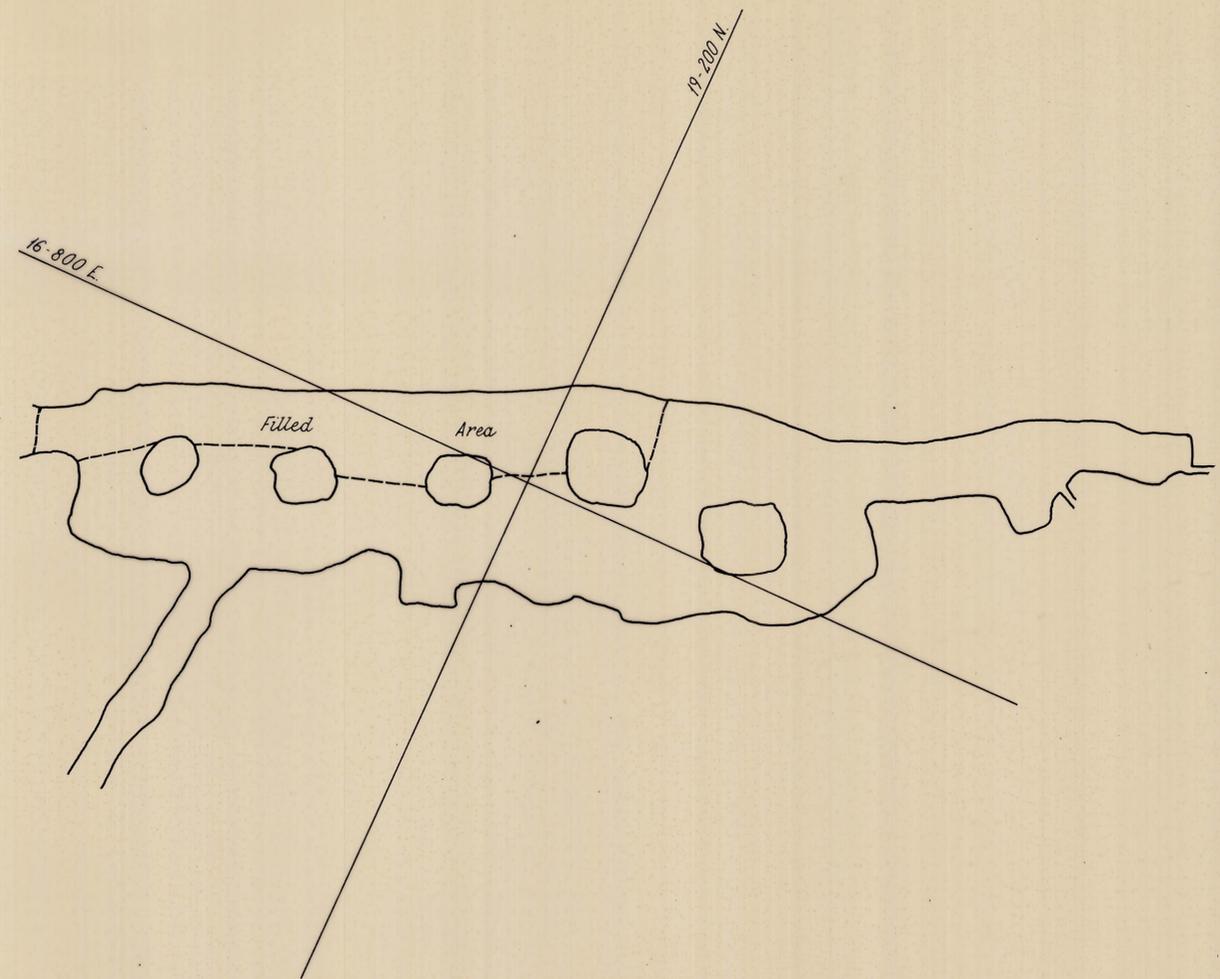

5 cm
0376-336

DATE	MANAGER	SURVEYOR	RENISON LIMITED SURVEY.			DRAWING No.
31-12-76	<i>[Signature]</i>	<i>[Signature]</i>				68:014
31-12-82	<i>[Signature]</i>	<i>[Signature]</i>	DRAWN	F.M.H.	DATE 17-2-77 SCALE 1:500	
			2075 MURCHISON STOPE. LEVEL: 2076.			

83149