


0376-337

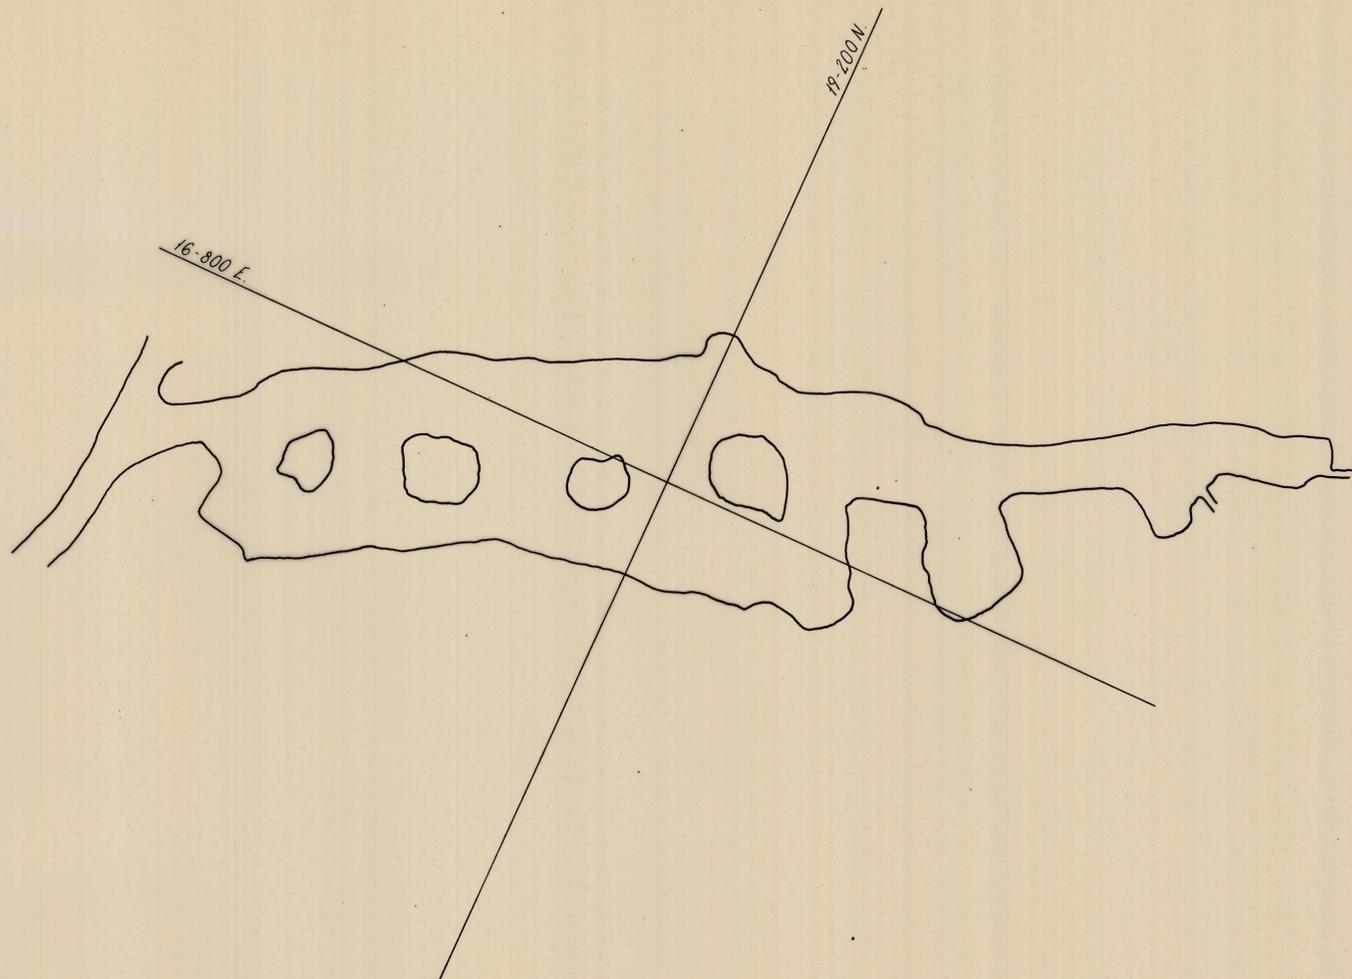

5 cm
 0376-337

DATE	MANAGER	SURVEYOR	RENISON LIMITED SURVEY.		DRAWING No.
31-12-76	<i>[Signature]</i>	<i>[Signature]</i>			68:014.
31-12-82	<i>[Signature]</i>	<i>[Signature]</i>	DRAWN F.M.H.	DATE 17-2-77 SCALE: 1:500.	
			2075 MURCHISON STOPE.		
			LEVEL: SILL DEVELOPMENT		

83148