


0376-338

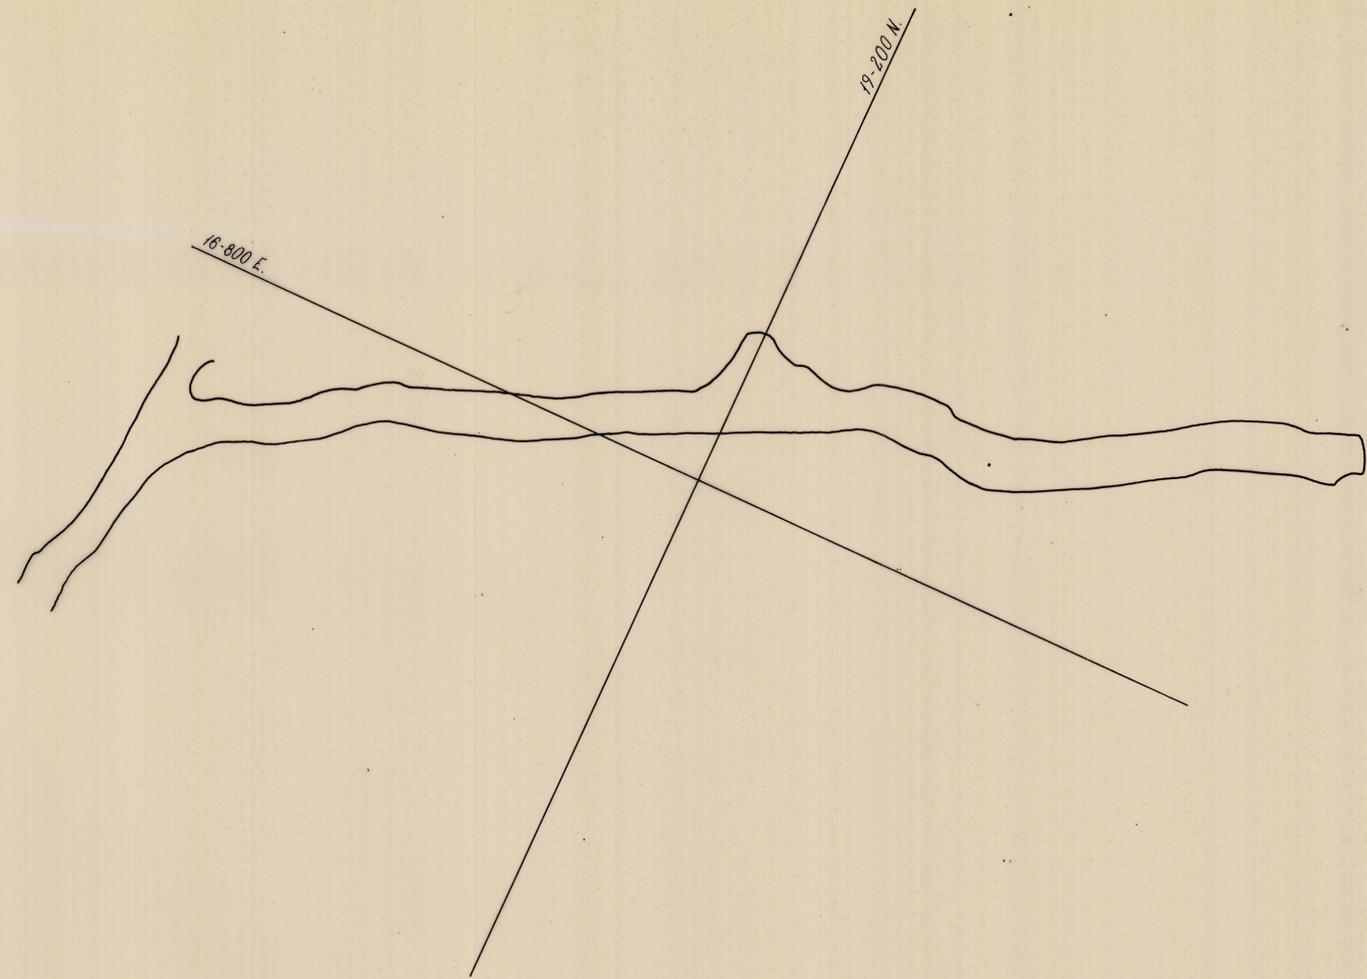

5 cm

0376-338

DATE	MANAGER	SURVEYOR	RENISON LIMITED SURVEY.		DRAWING No.
31-12-76	<i>[Signature]</i>	<i>[Signature]</i>			68:014.
31-12-82	<i>[Signature]</i>	<i>[Signature]</i>	DRAWN F.M.H.	DATE 17-2-77 SCALE 1:500.	
			2075 MURCHISON STOPE LEVEL: SILL. (2072)		

83147