
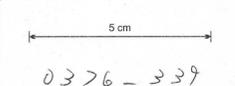


0376-339

16-800 E.

19-200 N.

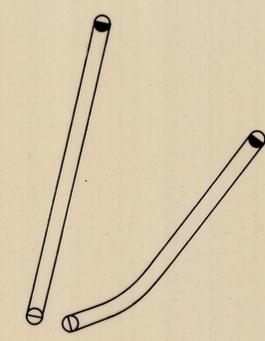

0376-339

DATE	MANAGER	SURVEYOR	RENISON LIMITED SURVEY.			DRAWING No.
31-12-76	<i>[Signature]</i>	<i>[Signature]</i>				68:014.
31-12-82	<i>[Signature]</i>	<i>[Signature]</i>	DRAWN F.M.H.	DATE 17-2-77	SCALE 1:500.	
			2075 MURCHISON STOPE RISES.			

83446