


0376-340

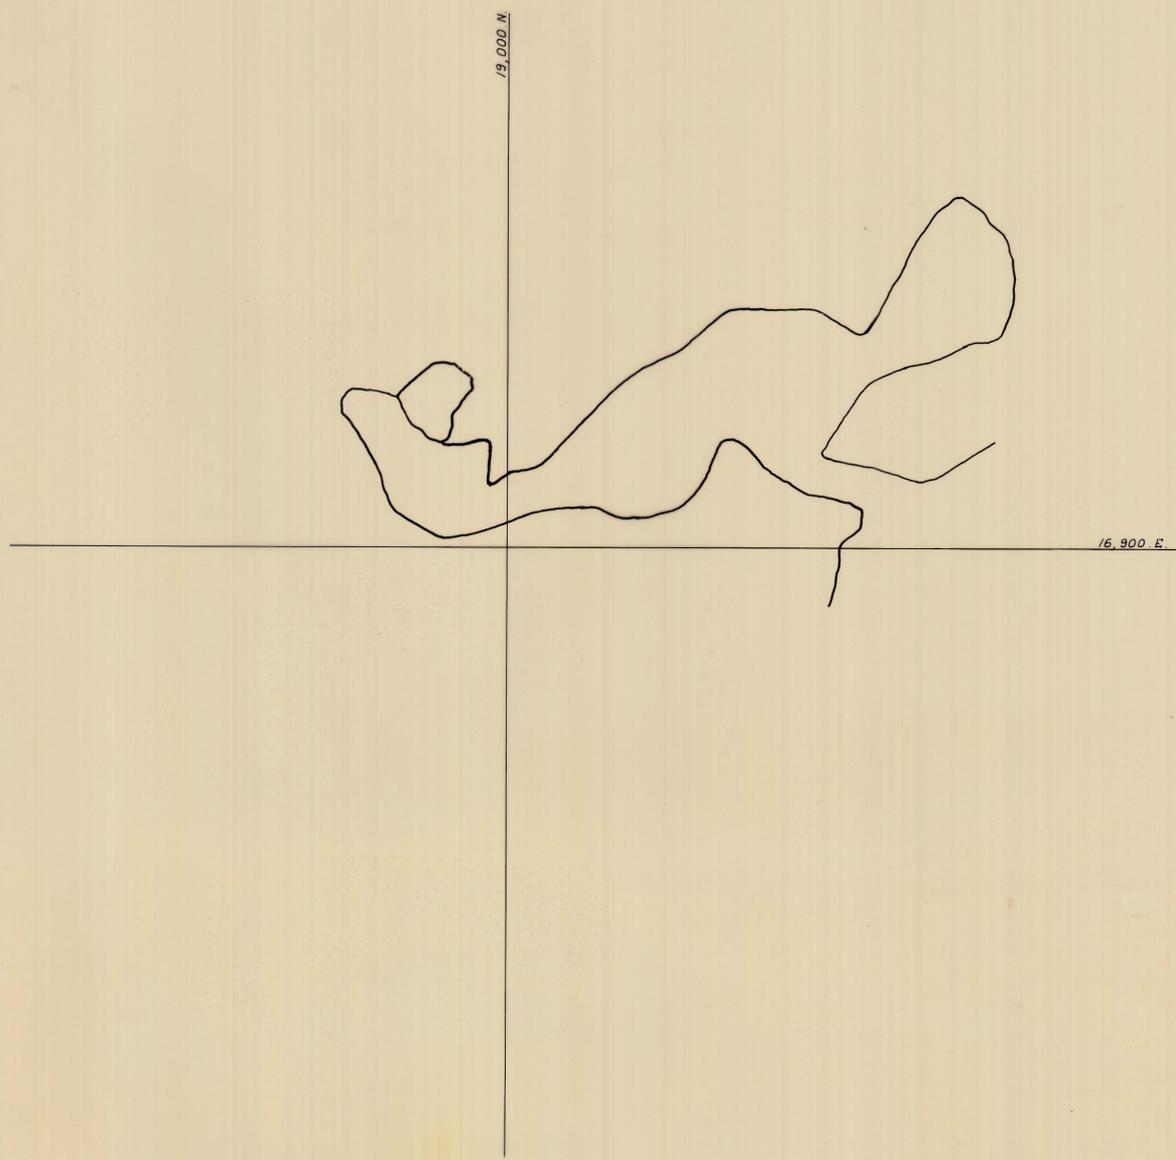

5 cm

0376-340

DATE	MANAGER	SURVEYOR	RENISON LIMITED SURVEY			DRAWING NO
31-12-82			DRAWN: P.W.K.	DATE: 22-3-73	SCALE: 1:500	17:001
			LOWER DREADNOUGHT STOPE LEVEL 2080			