


0326-341

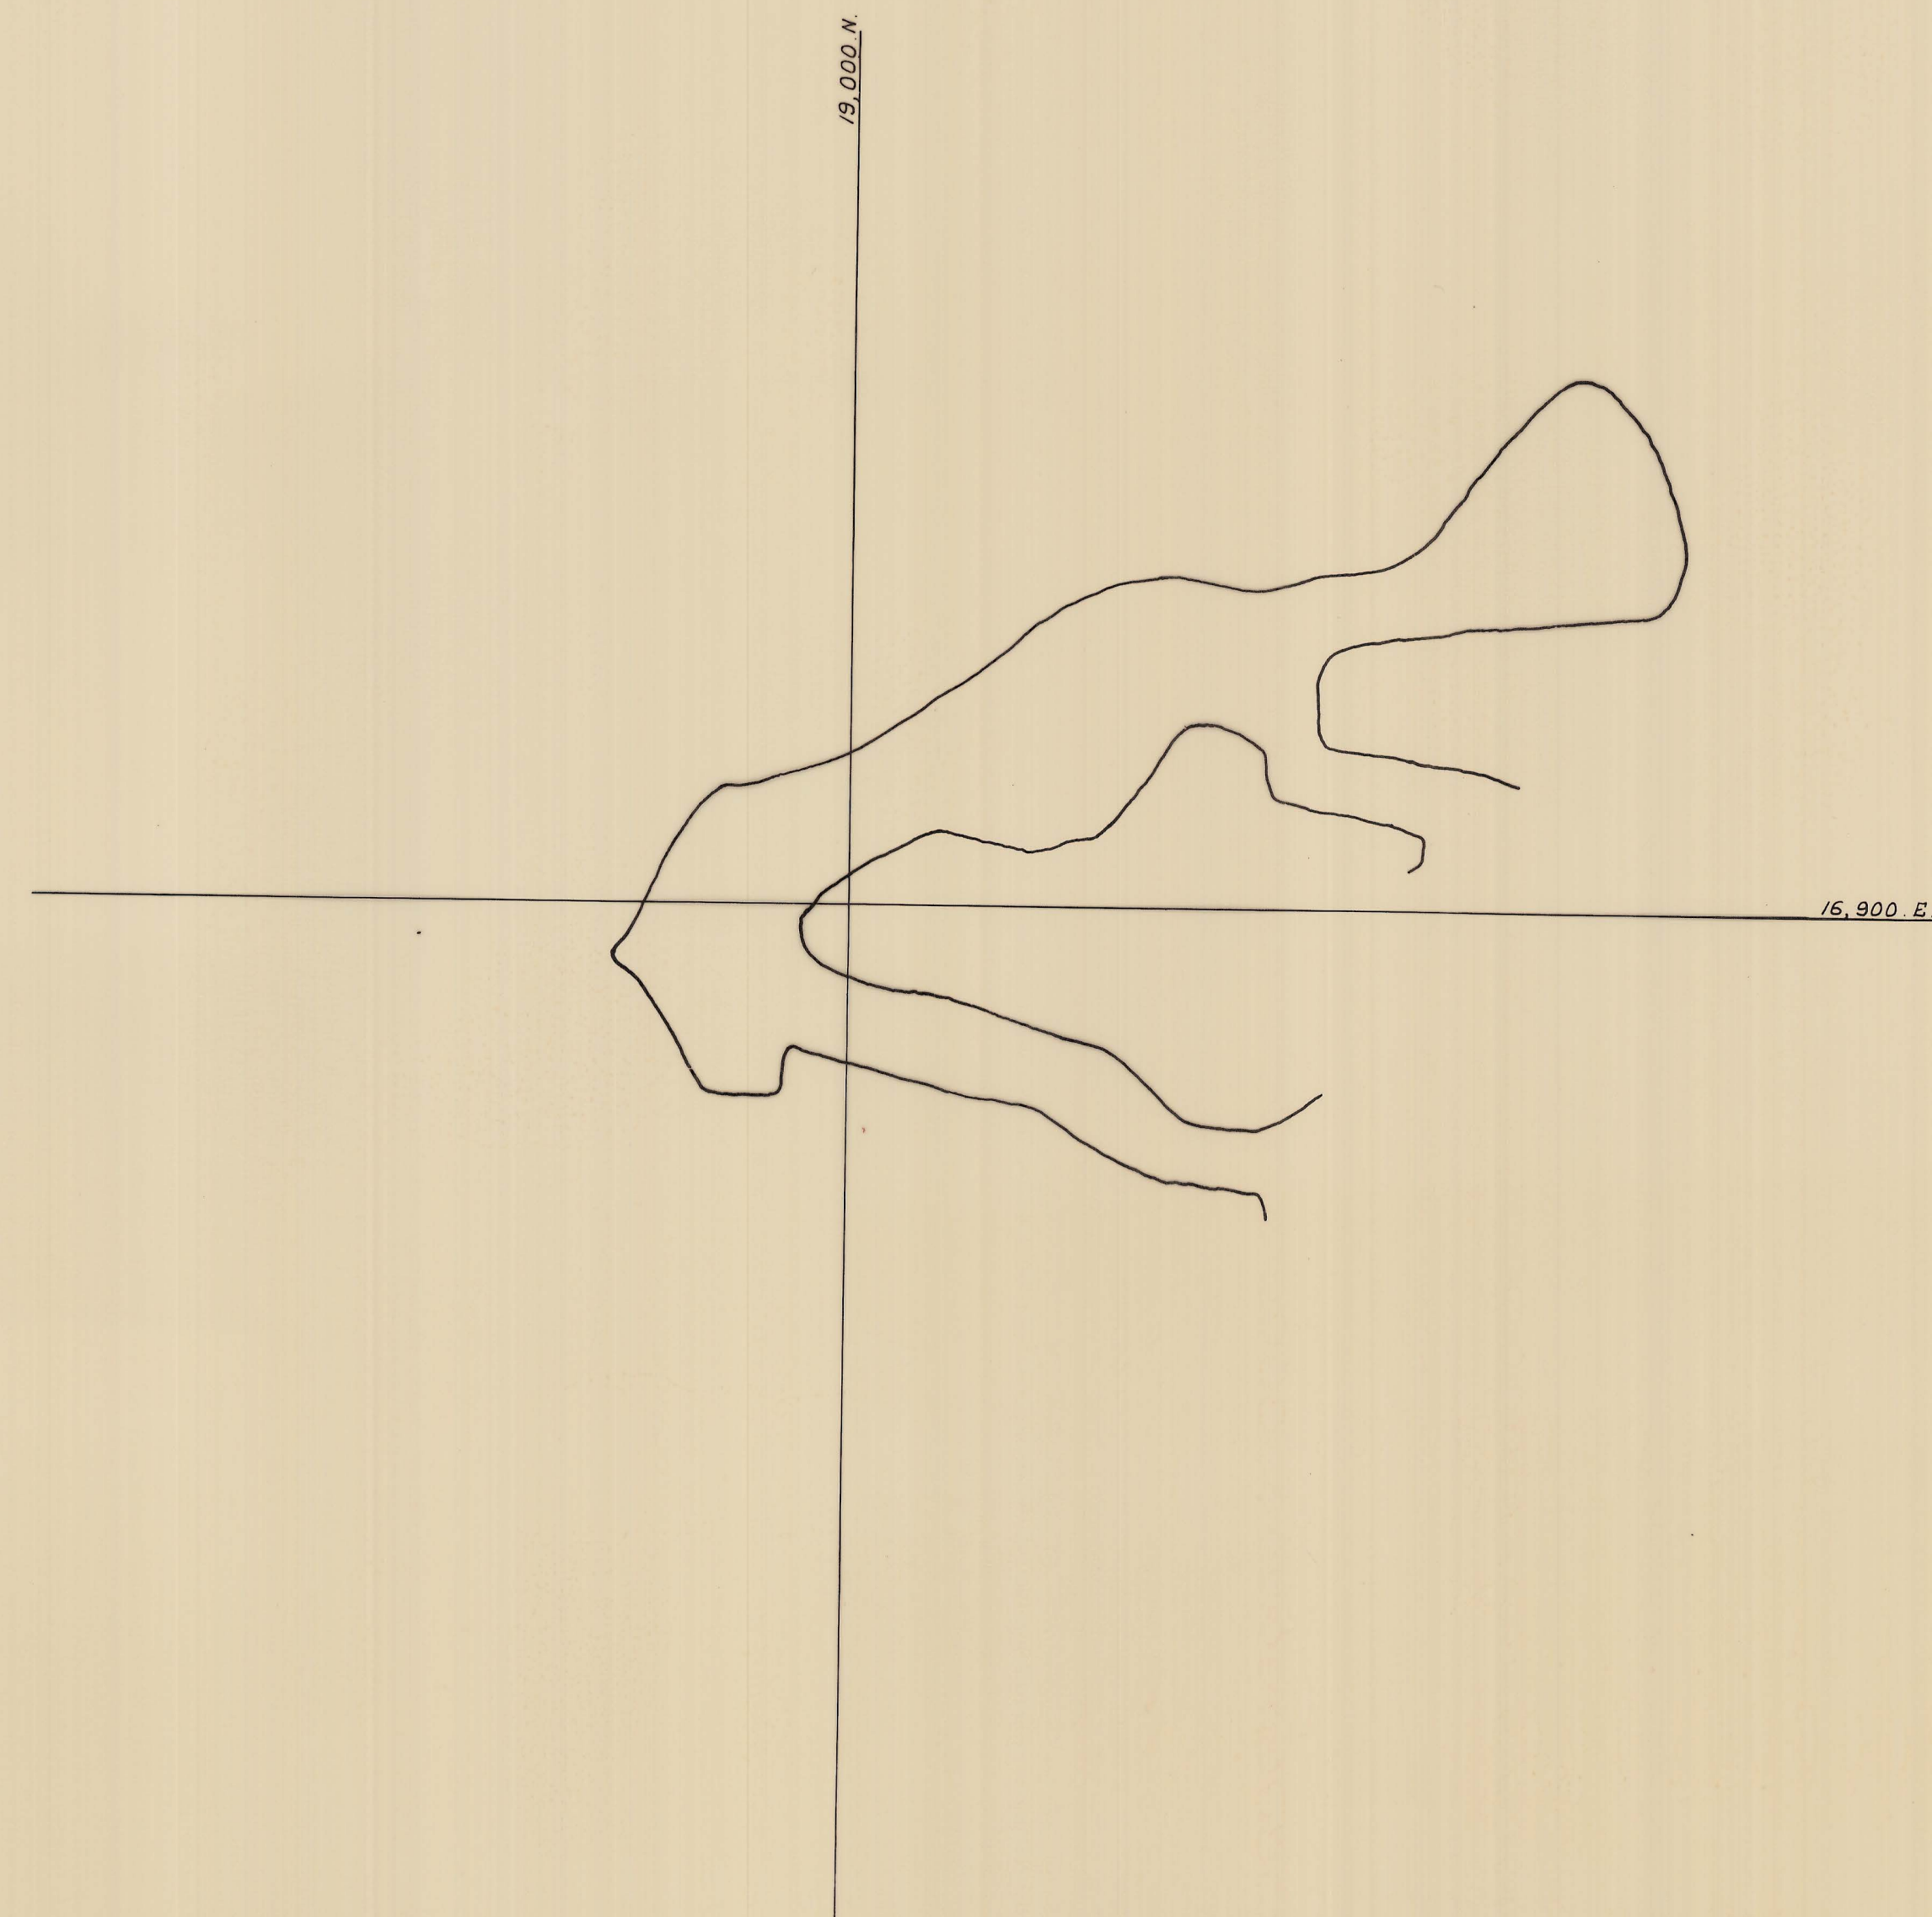

5 cm

0326-341

DATE	MANAGER	SURVEYOR	RENISON LIMITED SURVEY		DRAWING N°
31-12-82	<i>[Signature]</i>				
			DRAWN: P.W.K.	DATE: 22-3-13	SCALE: 1:500
			LOWER DREADNOUGHT STOPE LEVEL 2083		
			17:001		