


0376-342

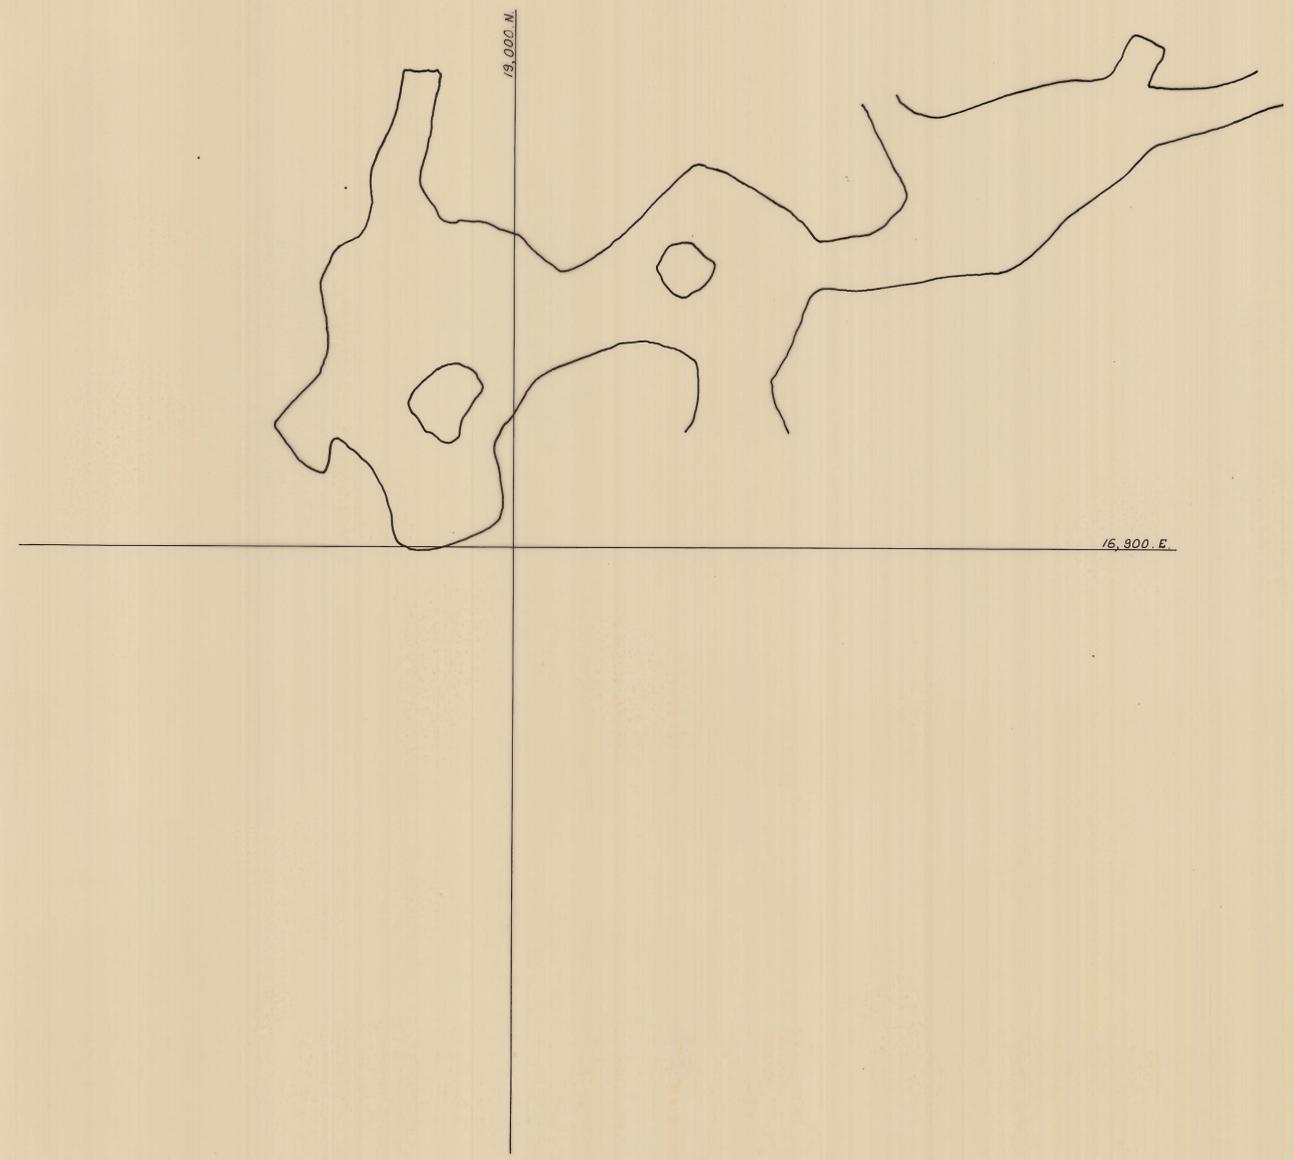

5 cm
0376-342

DATE	MANAGER	SURVEYOR	RENISON LIMITED SURVEY		DRAWING N°	
31-12-82	<i>[Signature]</i>				17:001	
			DRAWN: P.W.K.	DATE: 22-3-73		SCALE: 1:500
			LOWER DREADNOUGHT STOPE			
			LEVEL 2070			