


0376-346

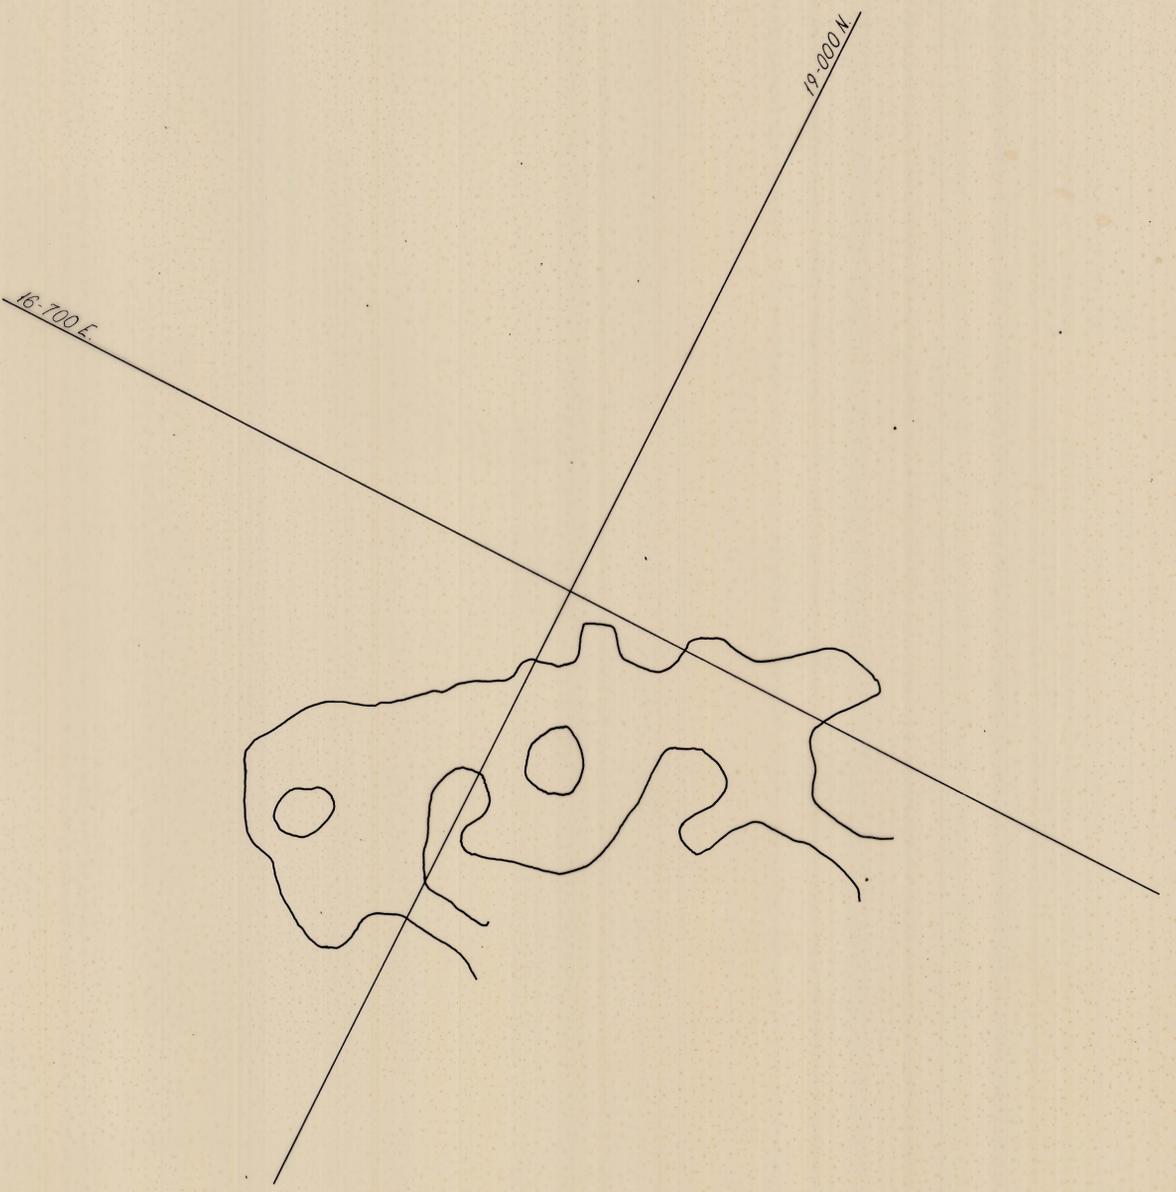

5 cm  
 0376-346

DATE	MANAGER	SURVEYOR	RENISON LIMITED SURVEY.		DRAWING No.
31-12-76	<i>[Signature]</i>	<i>[Signature]</i>	DRAWN. FMH	DATE 21-2-77	17:001
31-12-82	<i>[Signature]</i>	<i>[Signature]</i>	SCALE 1:500		
			UPPER DREADNOUGHT STOPE.		
			LEVEL: 2169.		

83132