


0376-347

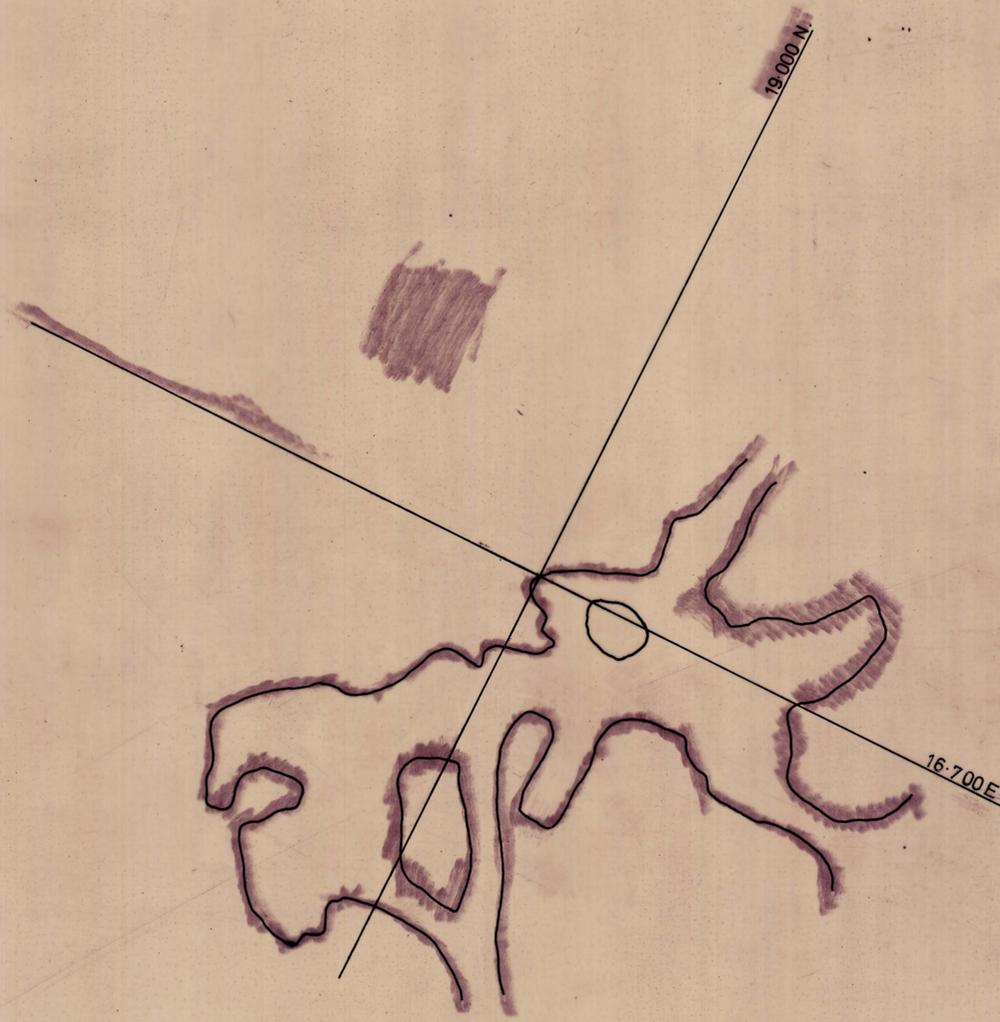

5 cm

0376-347

| DATE | MANAGER | SURVEYOR | RENISON LIMITED. | | DRAWING No. |
|----------|--------------------|--------------------|-------------------------|----------------|---------------|
| 31-12-75 | | | SURVEY. | | |
| 31-12-82 | <i>[Signature]</i> | <i>[Signature]</i> | DRAWN: F.M.H. | DATE: 10-12-75 | SCALE: 1:500. |
| | | | UPPER DREADNOUGHT STOPE | | 17-001 |
| | | | FILL LEVEL : 2166. | | |

83131