


0376-348

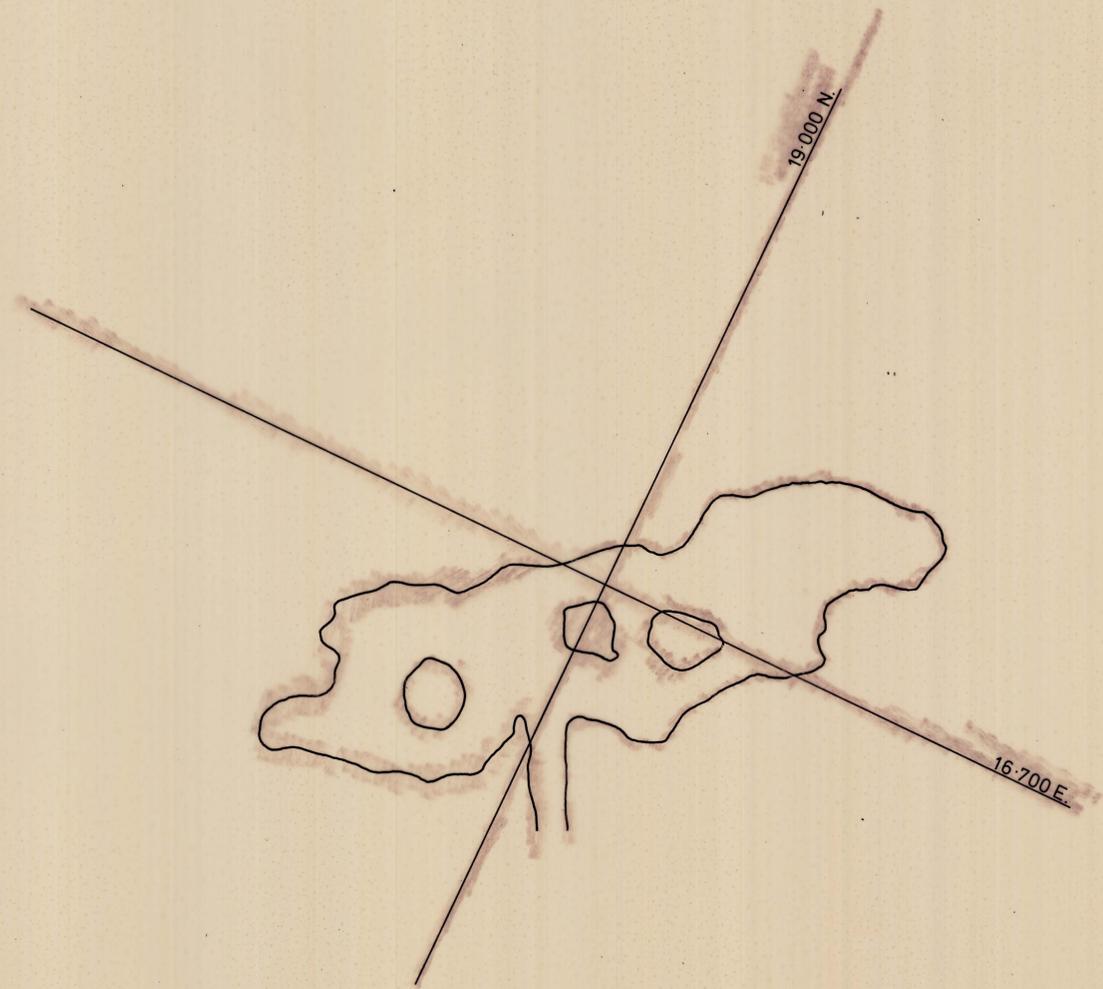

5 cm
0376-348

DATE	MANAGER	SURVEYOR	RENISON LIMITED SURVEY.		DRAWING No.
31-12-75					17-001
31-12-82			DRAWN: F.M.H.	DATE: 10-12-75 SCALE: 1-500.	
			UPPER DREADNOUGHT STOPE.		
			FILL LEVEL : 2160.		

83130