


0376-349

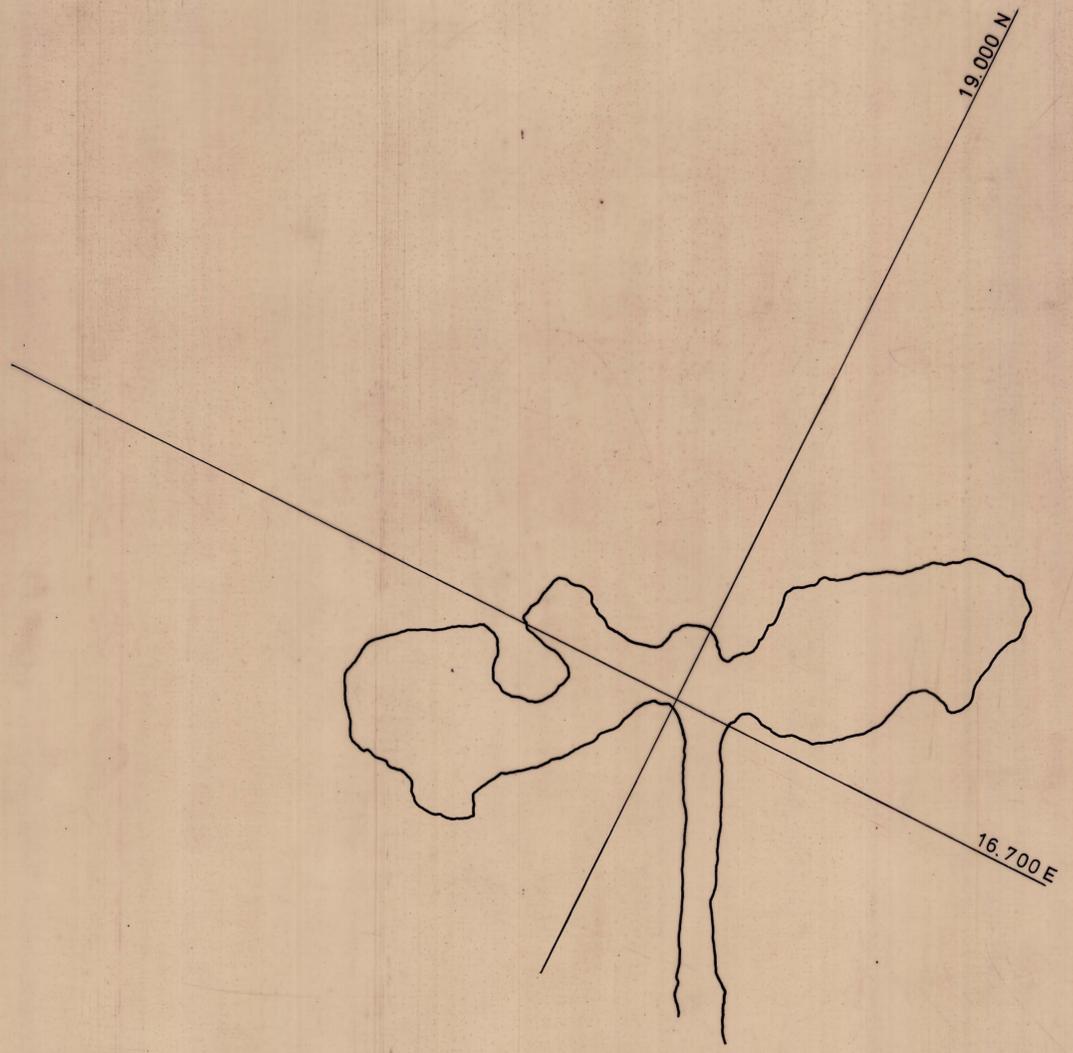

5 cm
0376-349

DATE	MANAGER	SURVEYOR	RENISON LIMITED		DRAWING No.
31-12-74			SURVEY		
31-12-82	<i>[Signature]</i>	<i>[Signature]</i>	DRAWN. A.J.M.	DATE. OCT. '74.	17:001
			SCALE. 1:500		
			UPPER DREADNOUGHT STOPES.		
			LEVEL. 2155		

83129