


0376-350

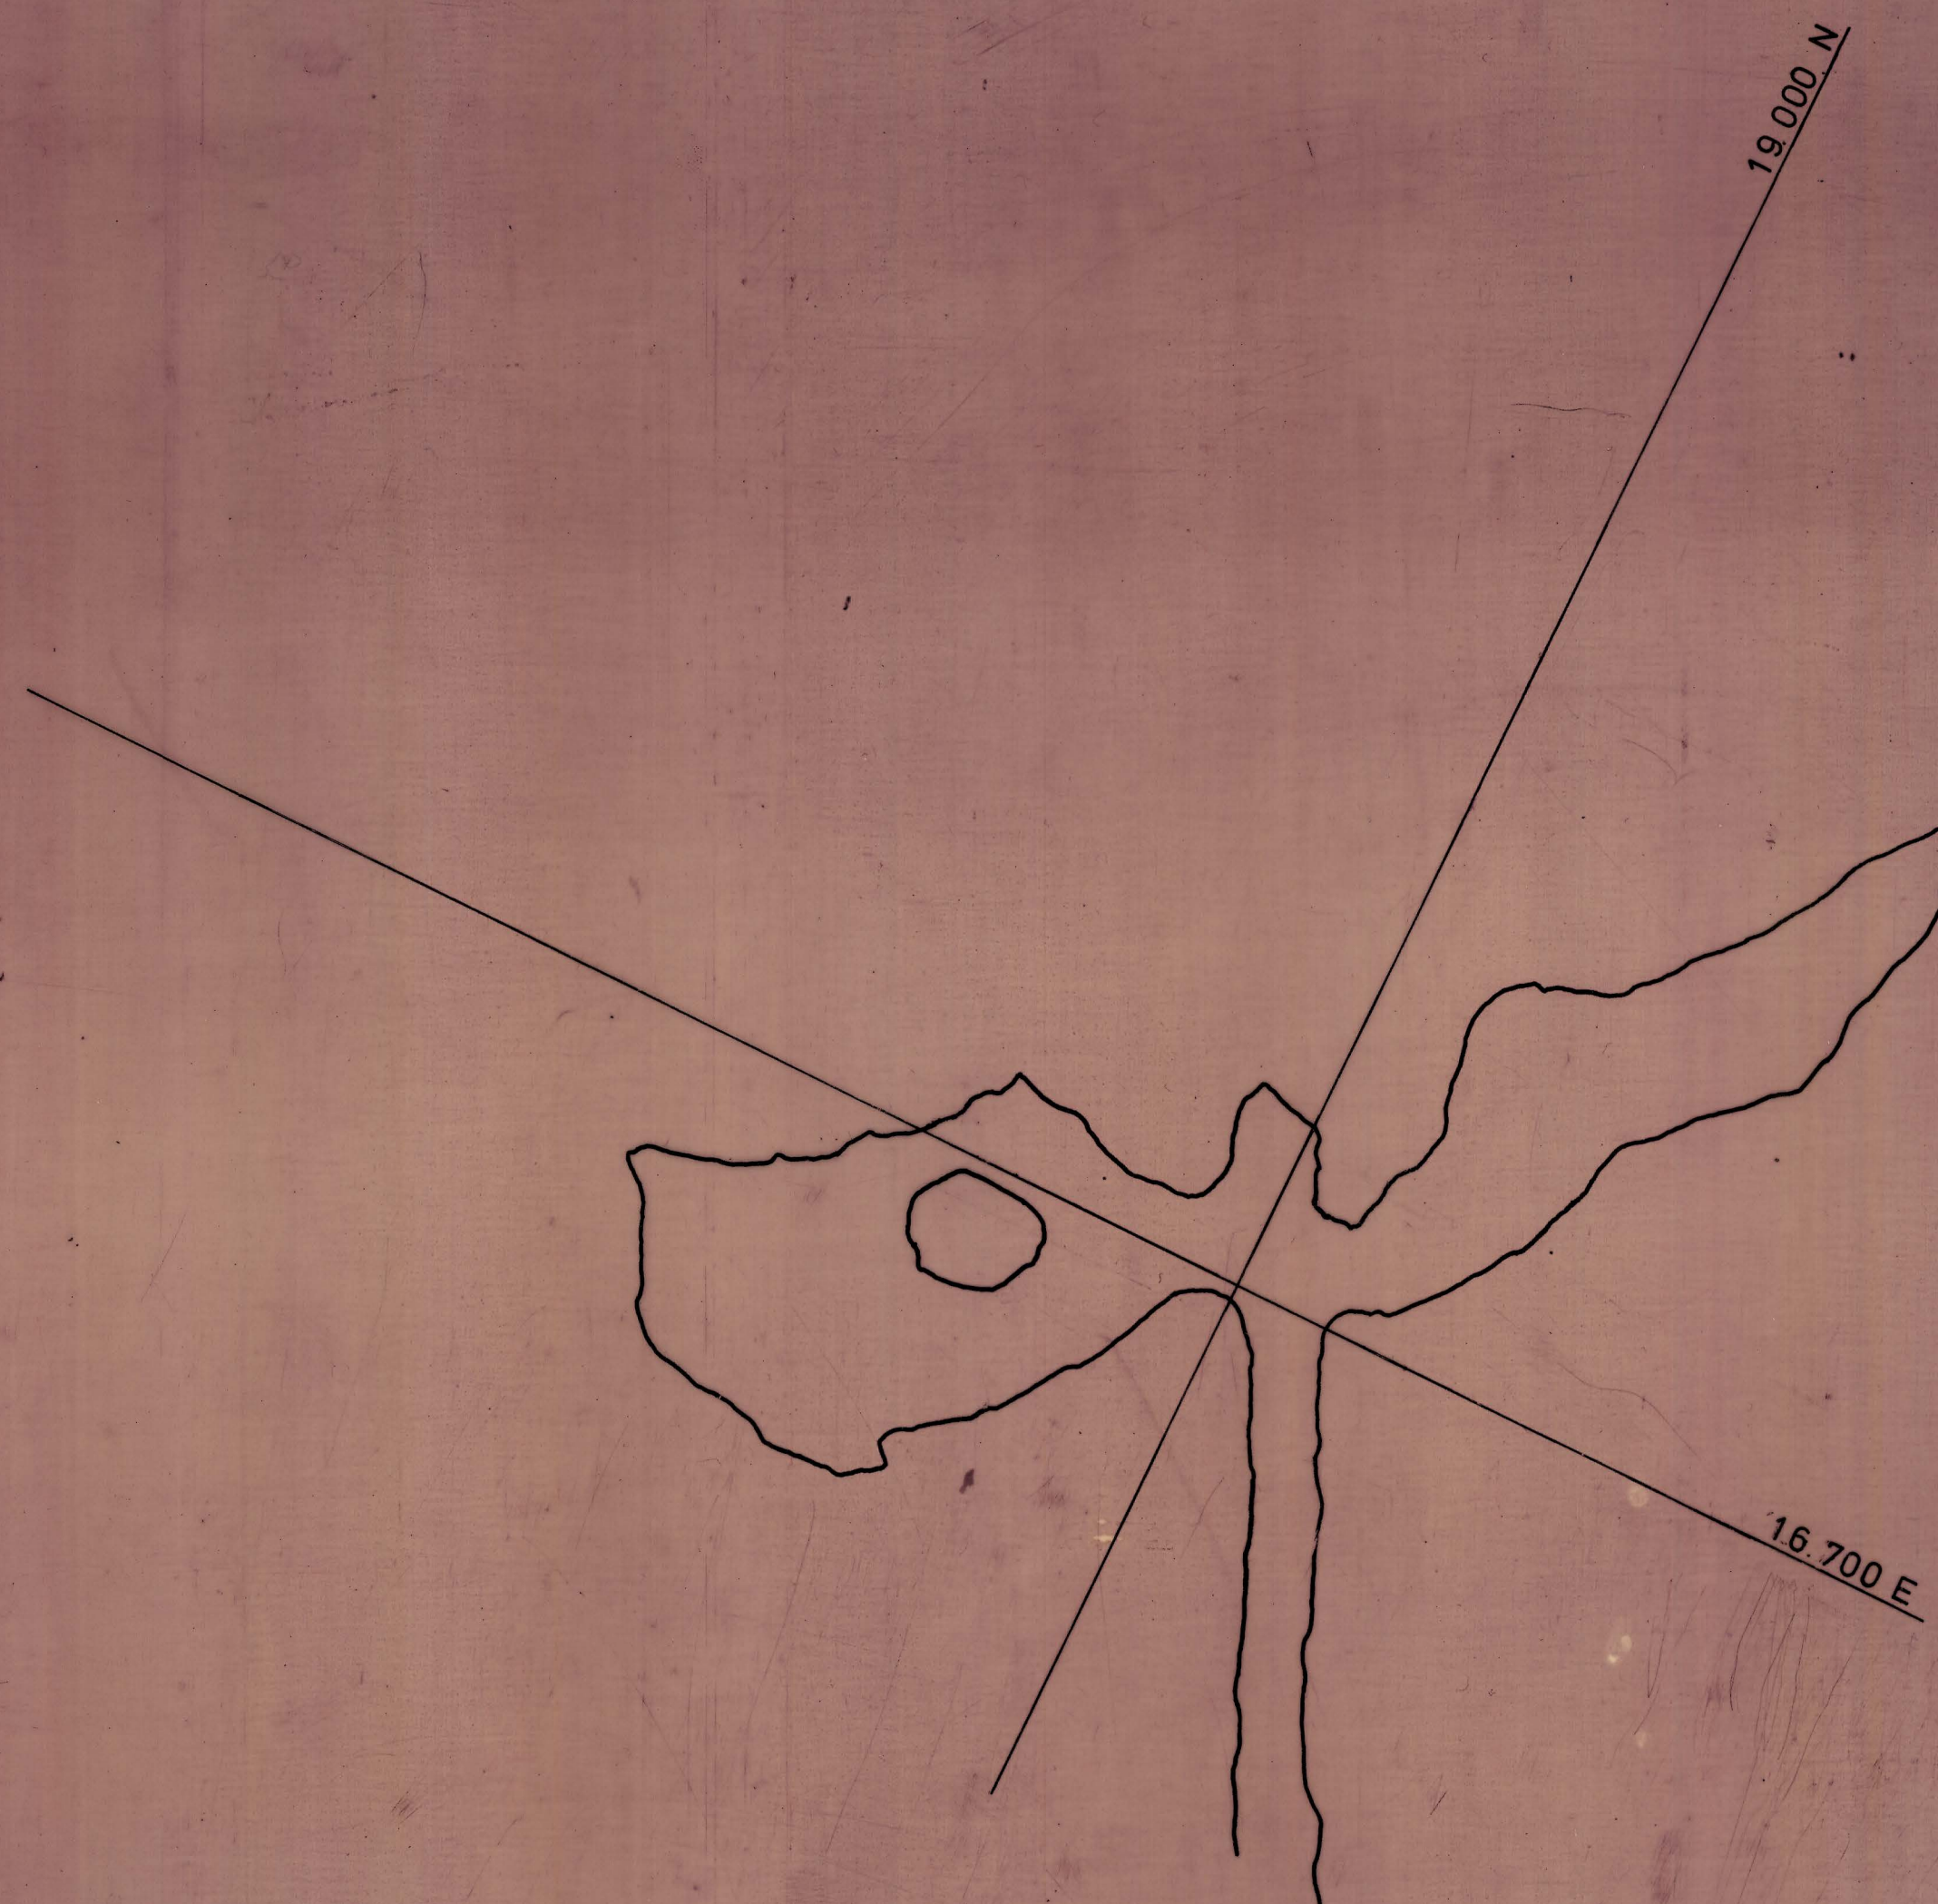

5 cm

0376-350

DATE	MANAGER	SURVEYOR	RENISON LIMITED			DRAWING No.
31-12-76			SURVEY			
31-12-82			DRAWN. A.J.M.	DATE. APRIL 74	SCALE. 1:500	17:001
			UPPER DREADNOUGHT STOPE			
			LEVEL 2152			

83128