


0376-351

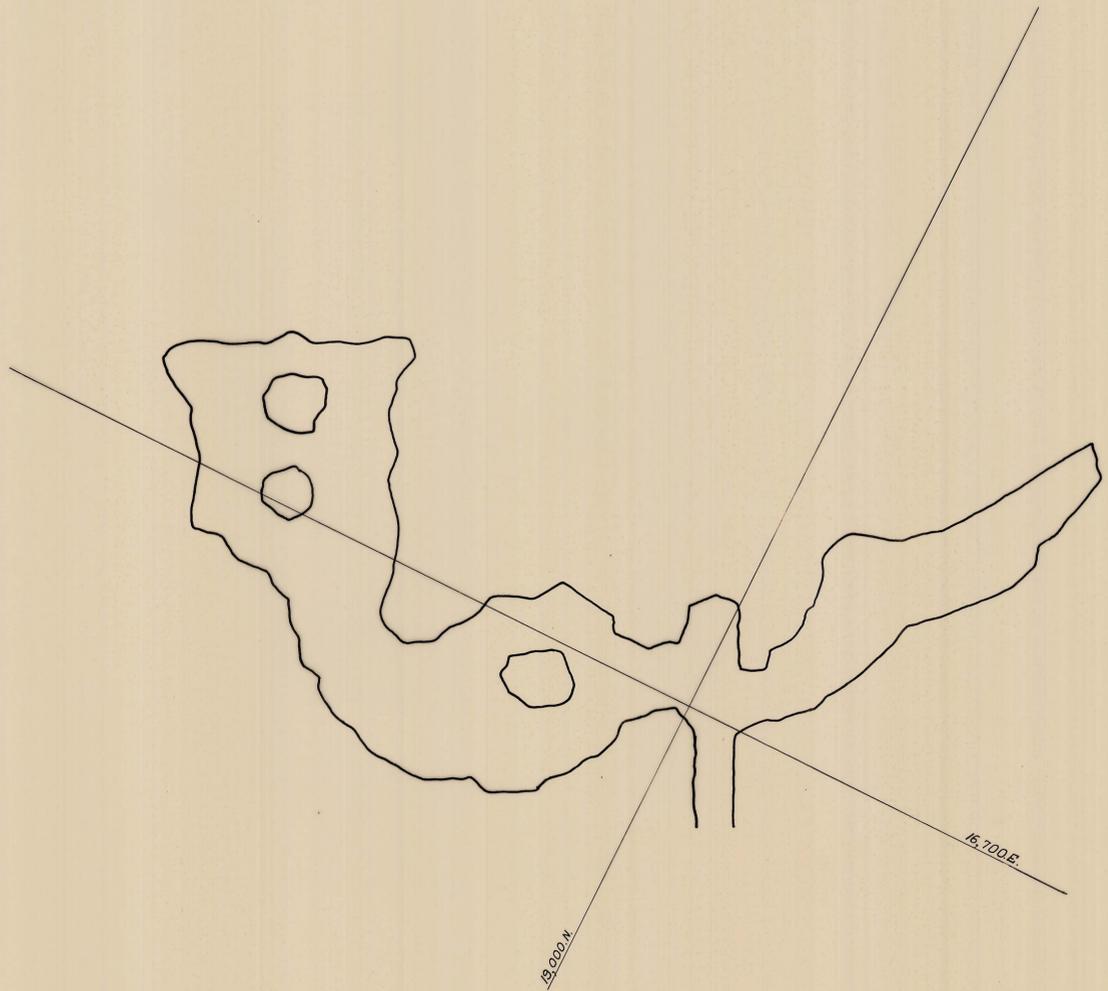

5 cm

0376-351

DATE	MANAGER	SURVEYOR	RENISON LIMITED SURVEY		DRAWING NO.
31-12-82	<i>[Signature]</i>	<i>[Signature]</i>	DRAWN: P.W.K.	DATE: 7-3-74	SCALE: 1:500
			UPPER DREADNOUGHT STOPE		17:001
			LEVEL: 2150-00		

83127