


0376-352

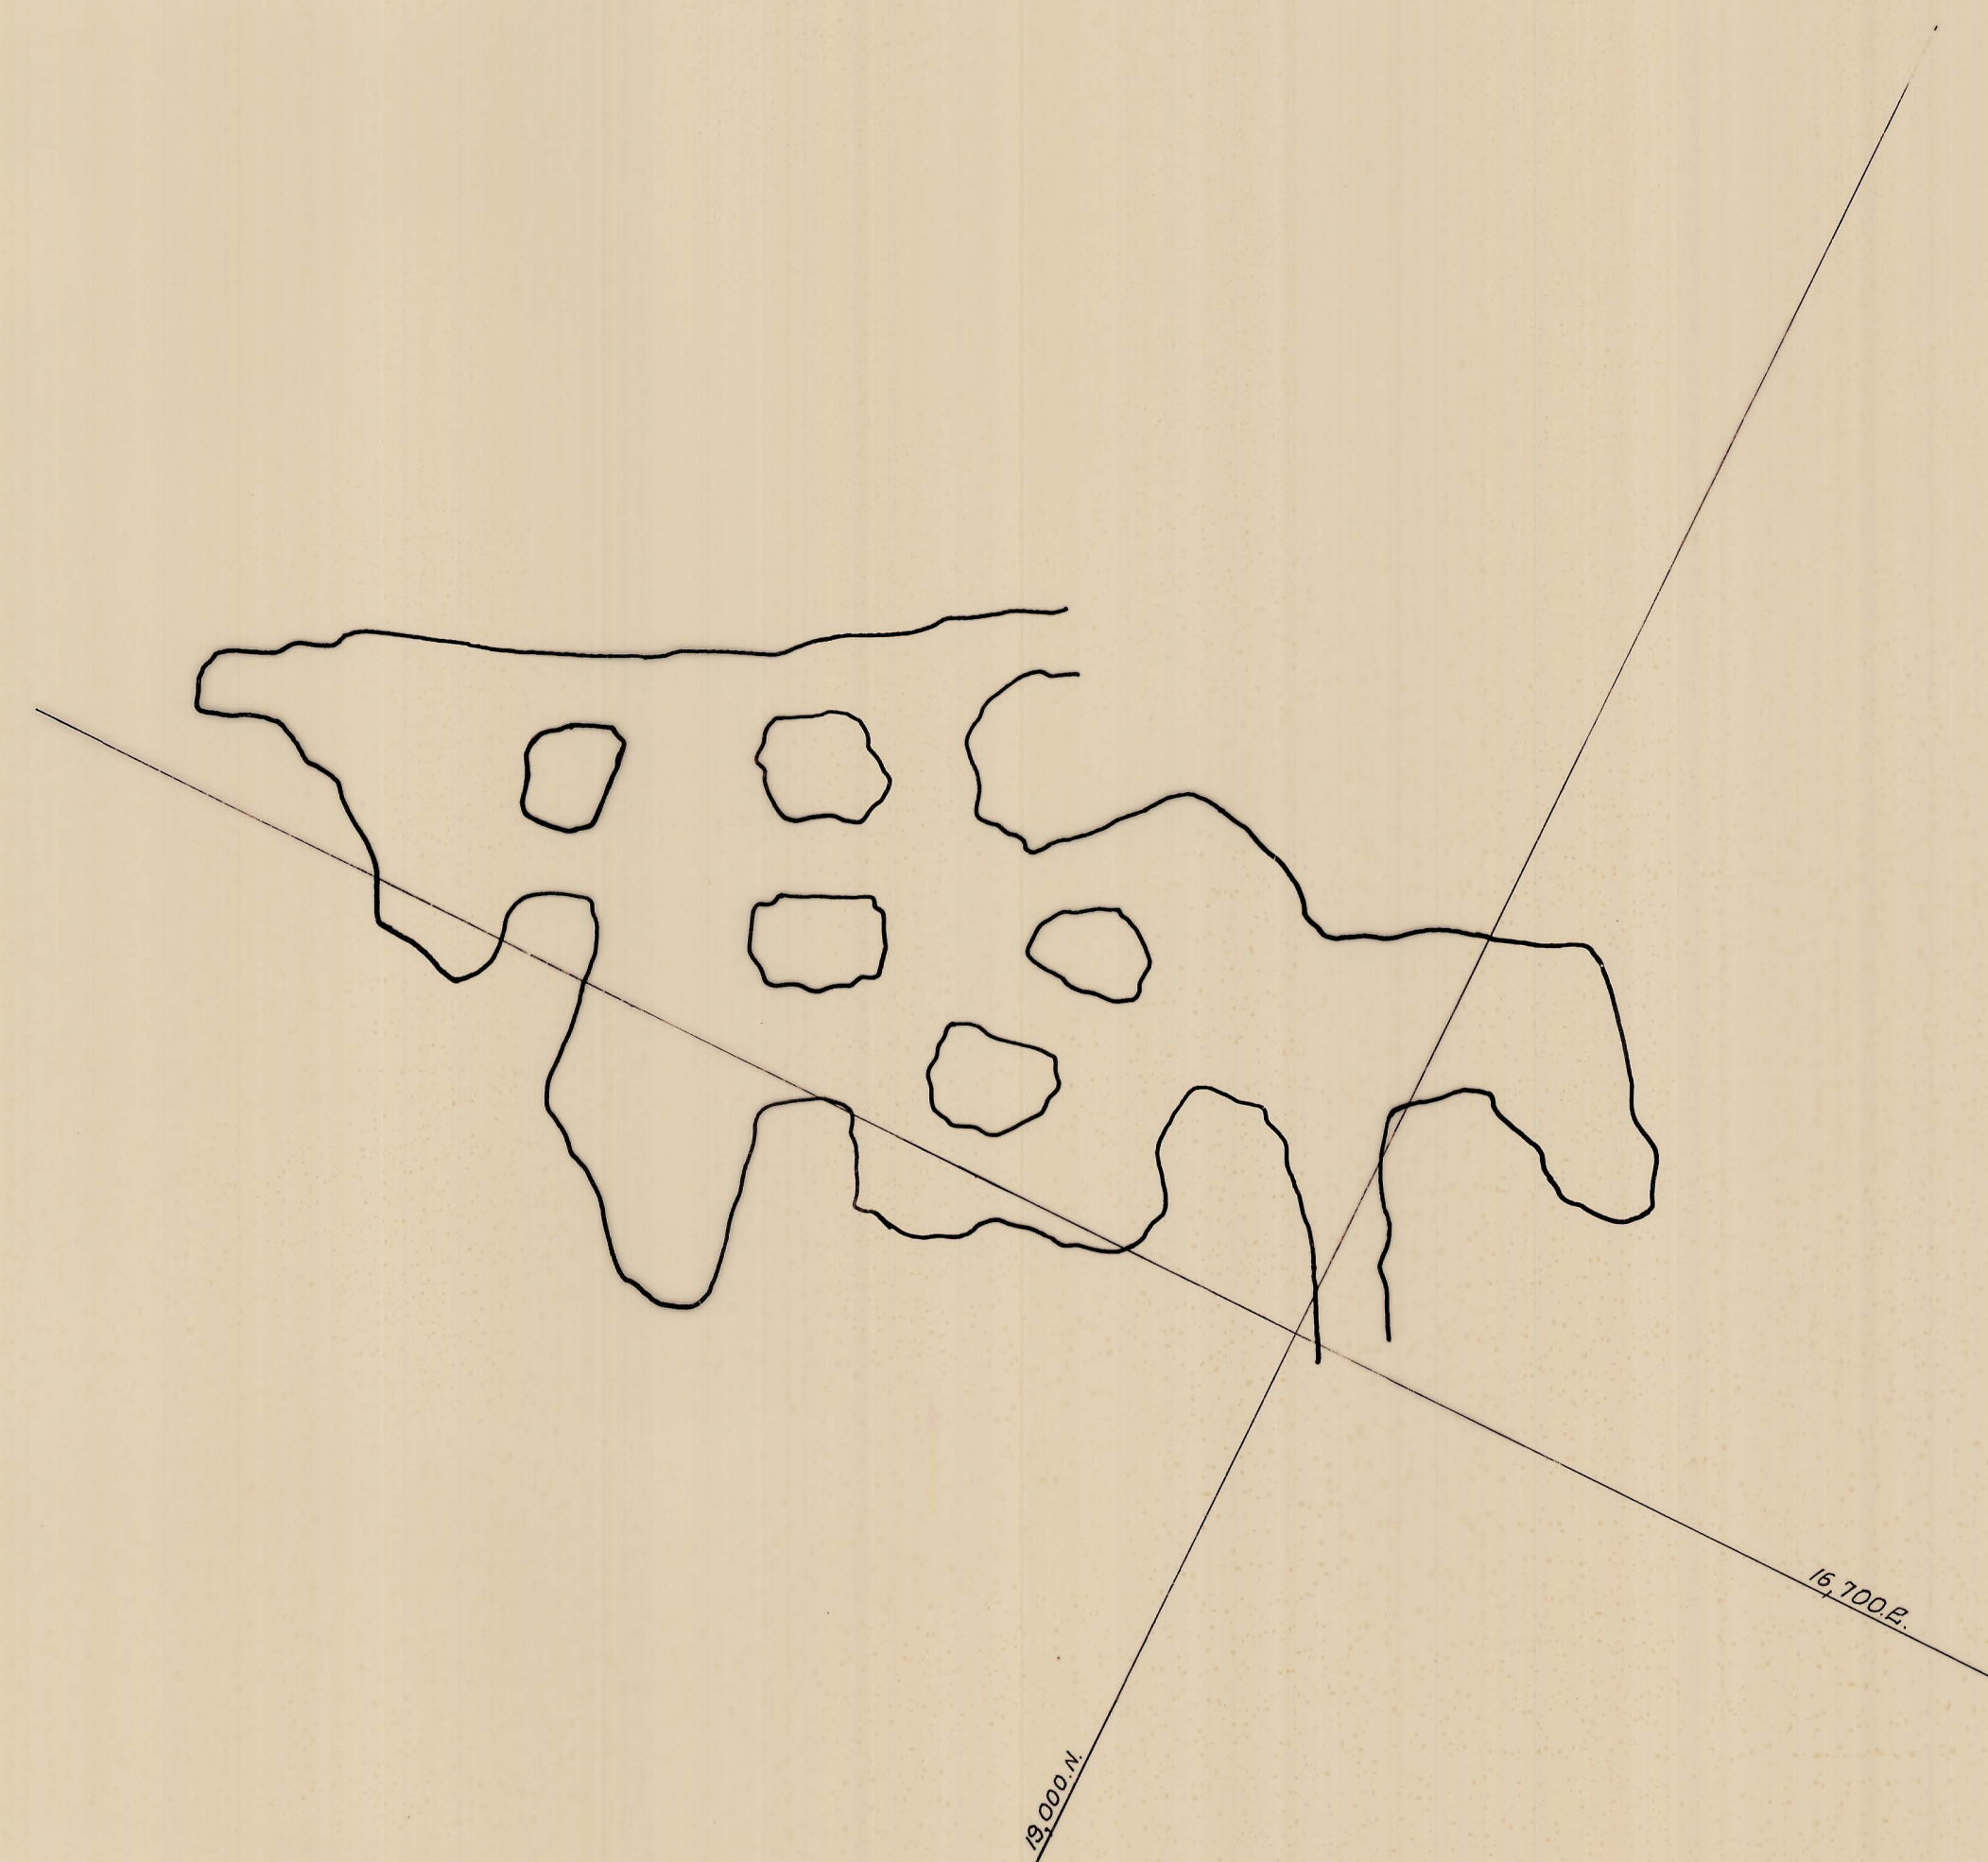

5 cm

0376-352

DATE	MANAGER	SURVEYOR	RENISON LIMITED SURVEY			DRAWING N°
31-12-82	<i>[Signature]</i>	<i>[Signature]</i>				17:001
			DRAWN: P.W.K.	DATE: 9-7-73	SCALE: 1:500	
			UPPER DREADNOUGHT STOPE			
			LEVEL: 2145.00			

83126