


0376-353

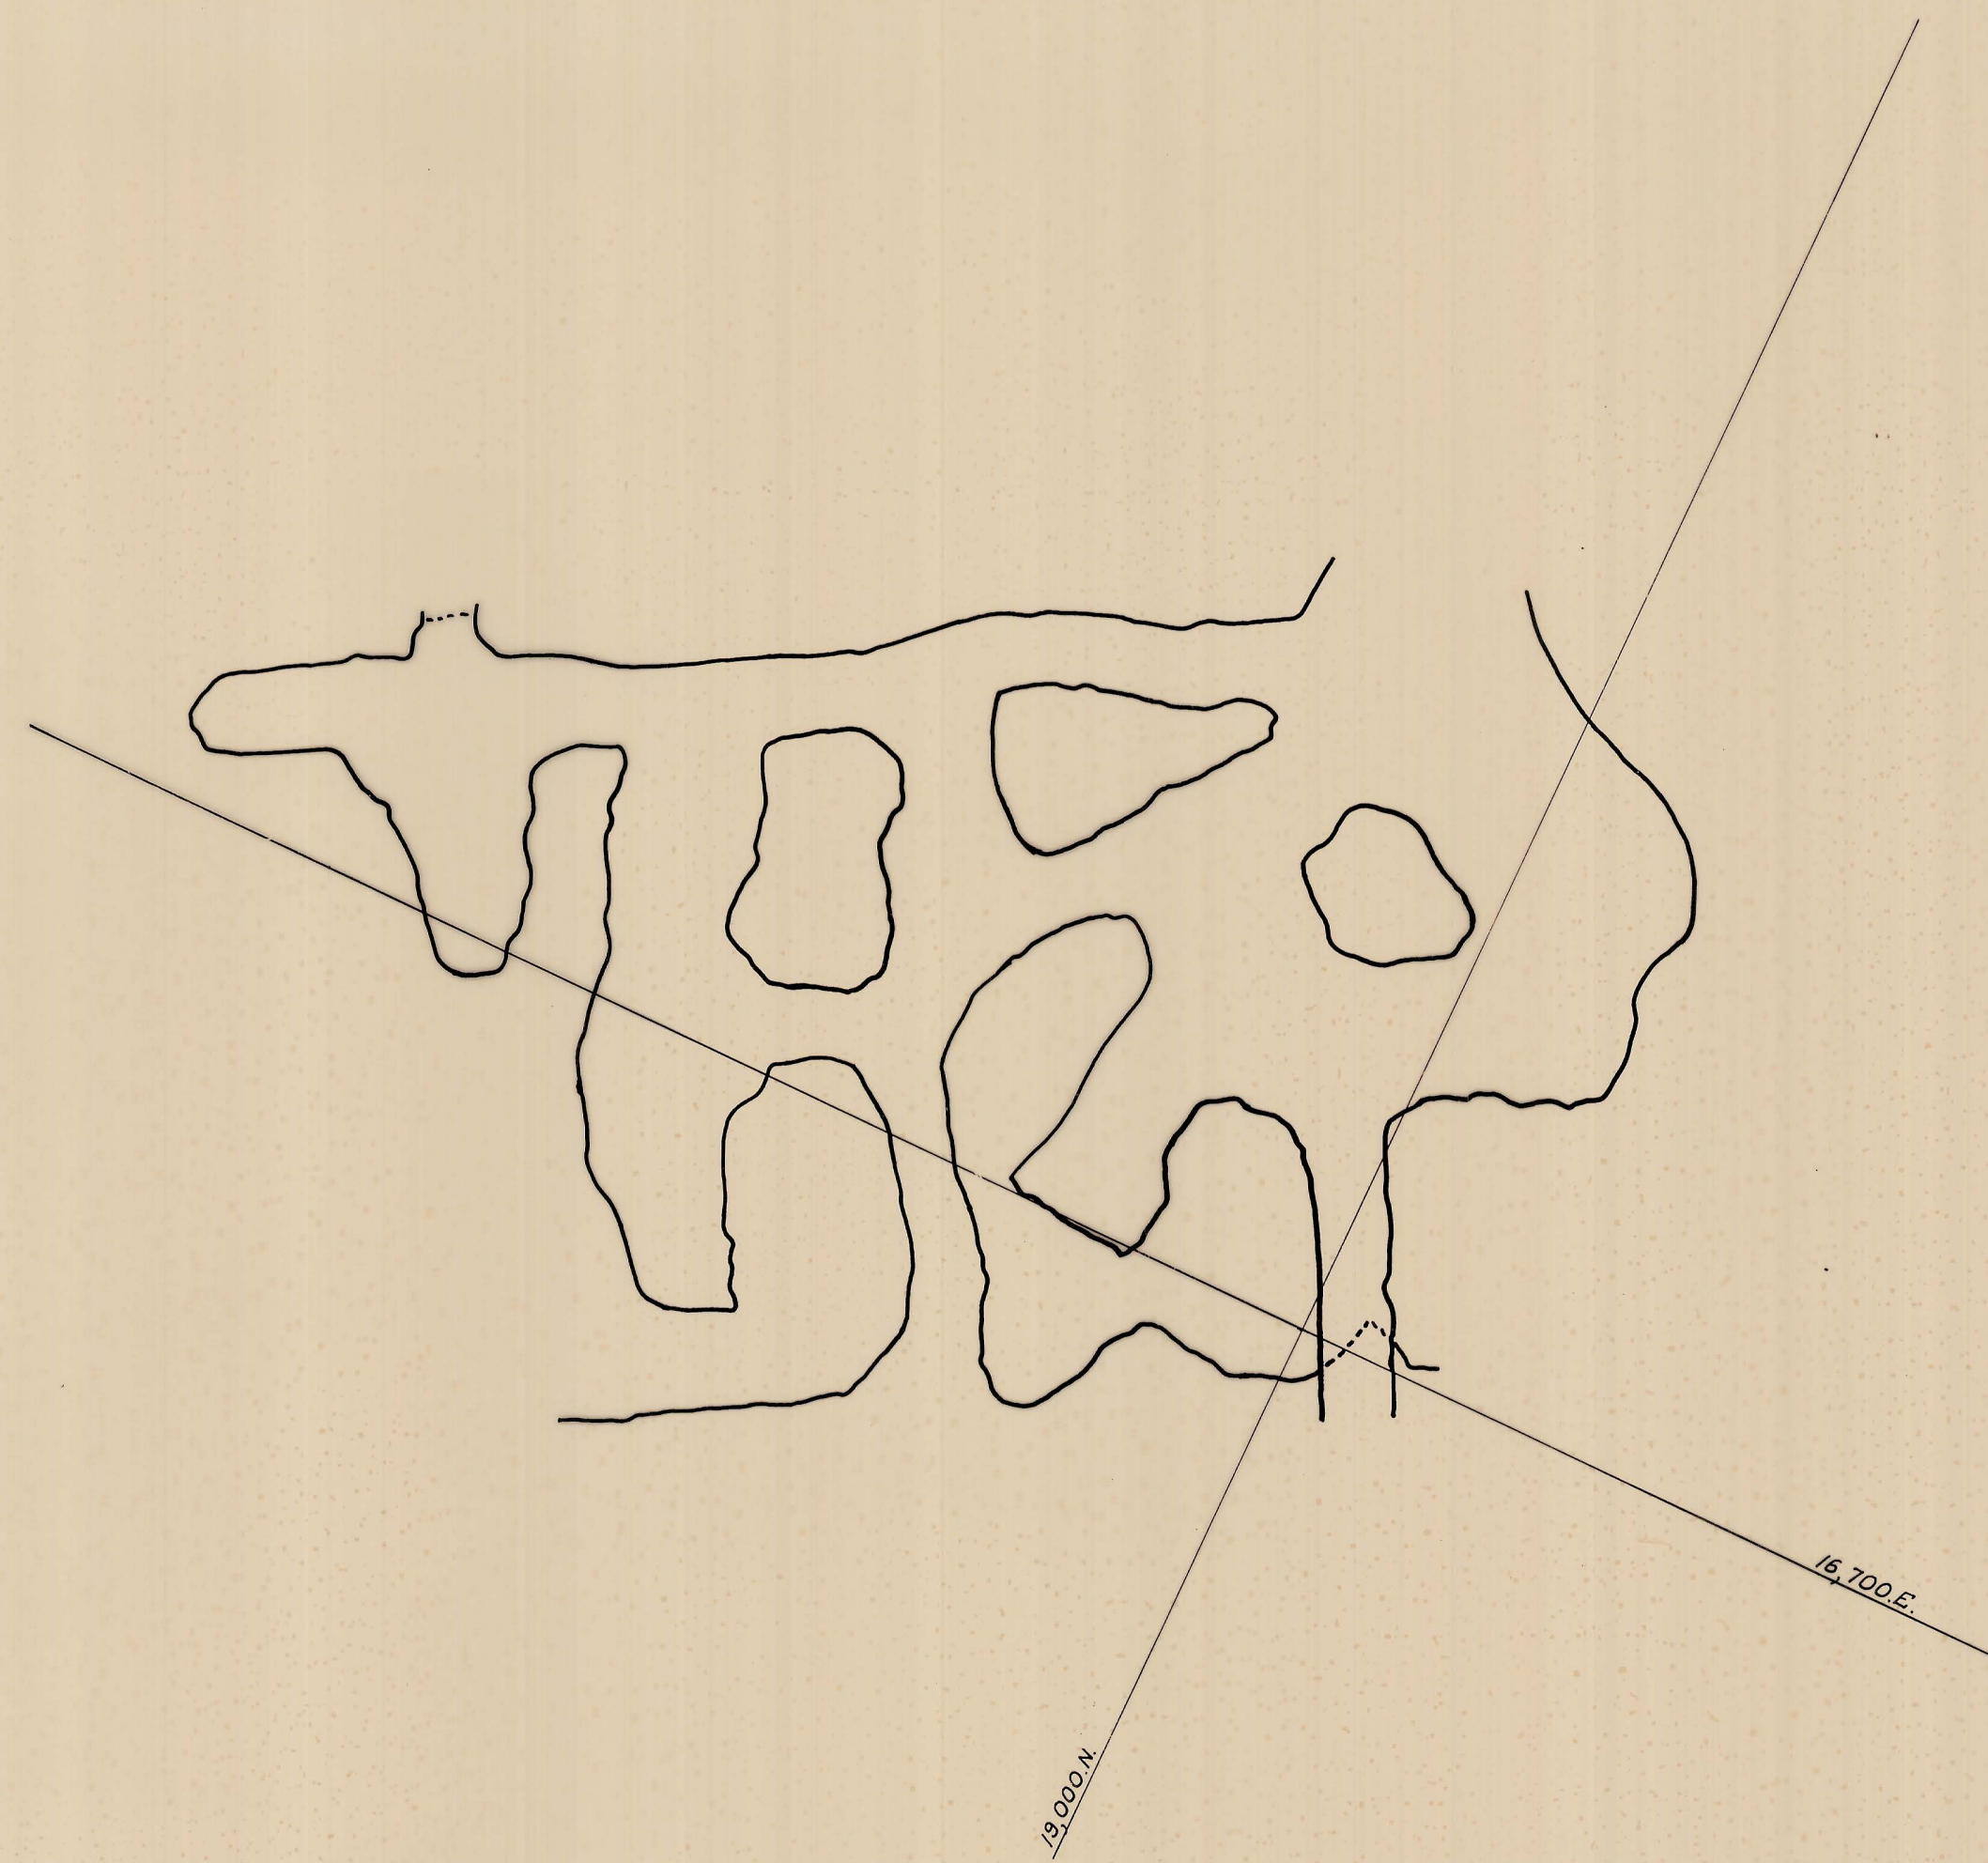

5 cm
0376-353

DATE	MANAGER	SURVEYOR	RENISON LIMITED SURVEY			DRAWING N°
31-12-82	<i>[Signature]</i>	<i>[Signature]</i>	DRAWN: P.W.K.	DATE: 23-2-73	SCALE: 1:500	17:001
			UPPER DREADNOUGHT STOPE			
			LEVEL: 2142.00			

83125