


0376-354

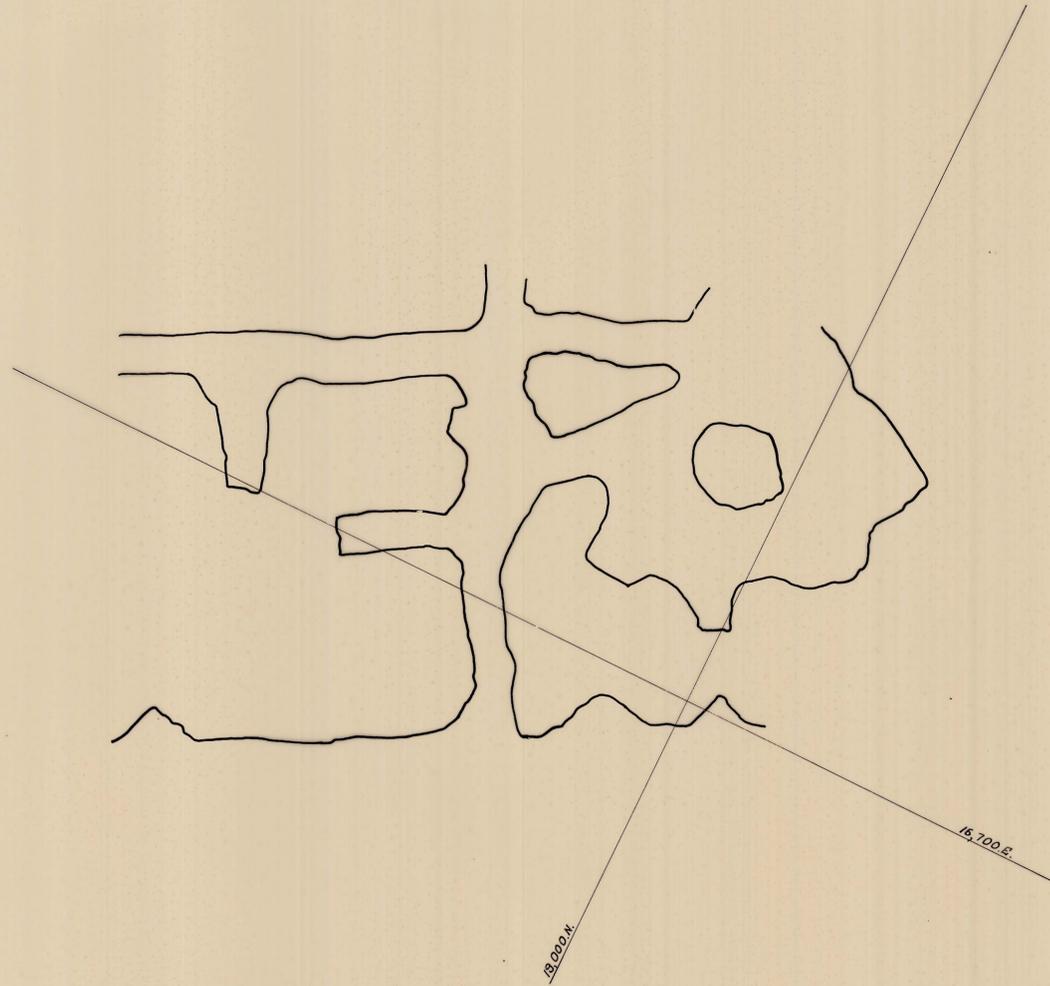

5 cm  
 0376-354

DATE	MANAGER	SURVEYOR	RENISON LIMITED SURVEY		DRAWING N°
31-12-82	<i>[Signature]</i>	<i>[Signature]</i>	DRAWN: P.W.K.	DATE: 23-2-73	SCALE: 1:500
			UPPER DREADNOUGHT STOPE		17:001
			LEVEL: 2140.00		

83124