


0376-356

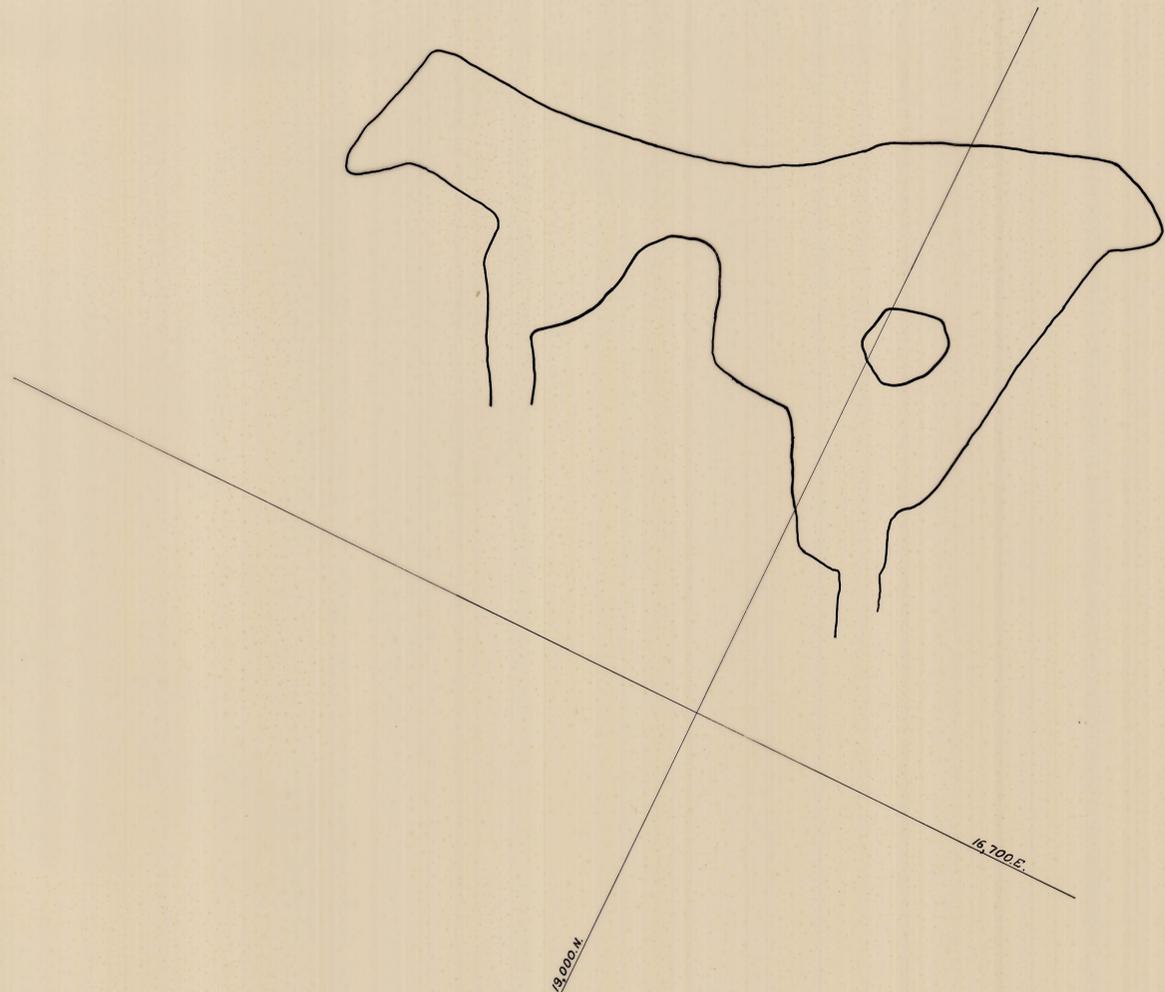

5 cm
0376-356

DATE	MANAGER	SURVEYOR	RENISON LIMITED SURVEY			DRAWING N°
31-12-82	<i>[Signature]</i>	<i>[Signature]</i>	DRAWN: P.M.K.	DATE: 23-2-73	SCALE: 1:500	17-001
			UPPER DREADNOUGHT STOPE LEVEL: 2133.00			

83122