


0376-366

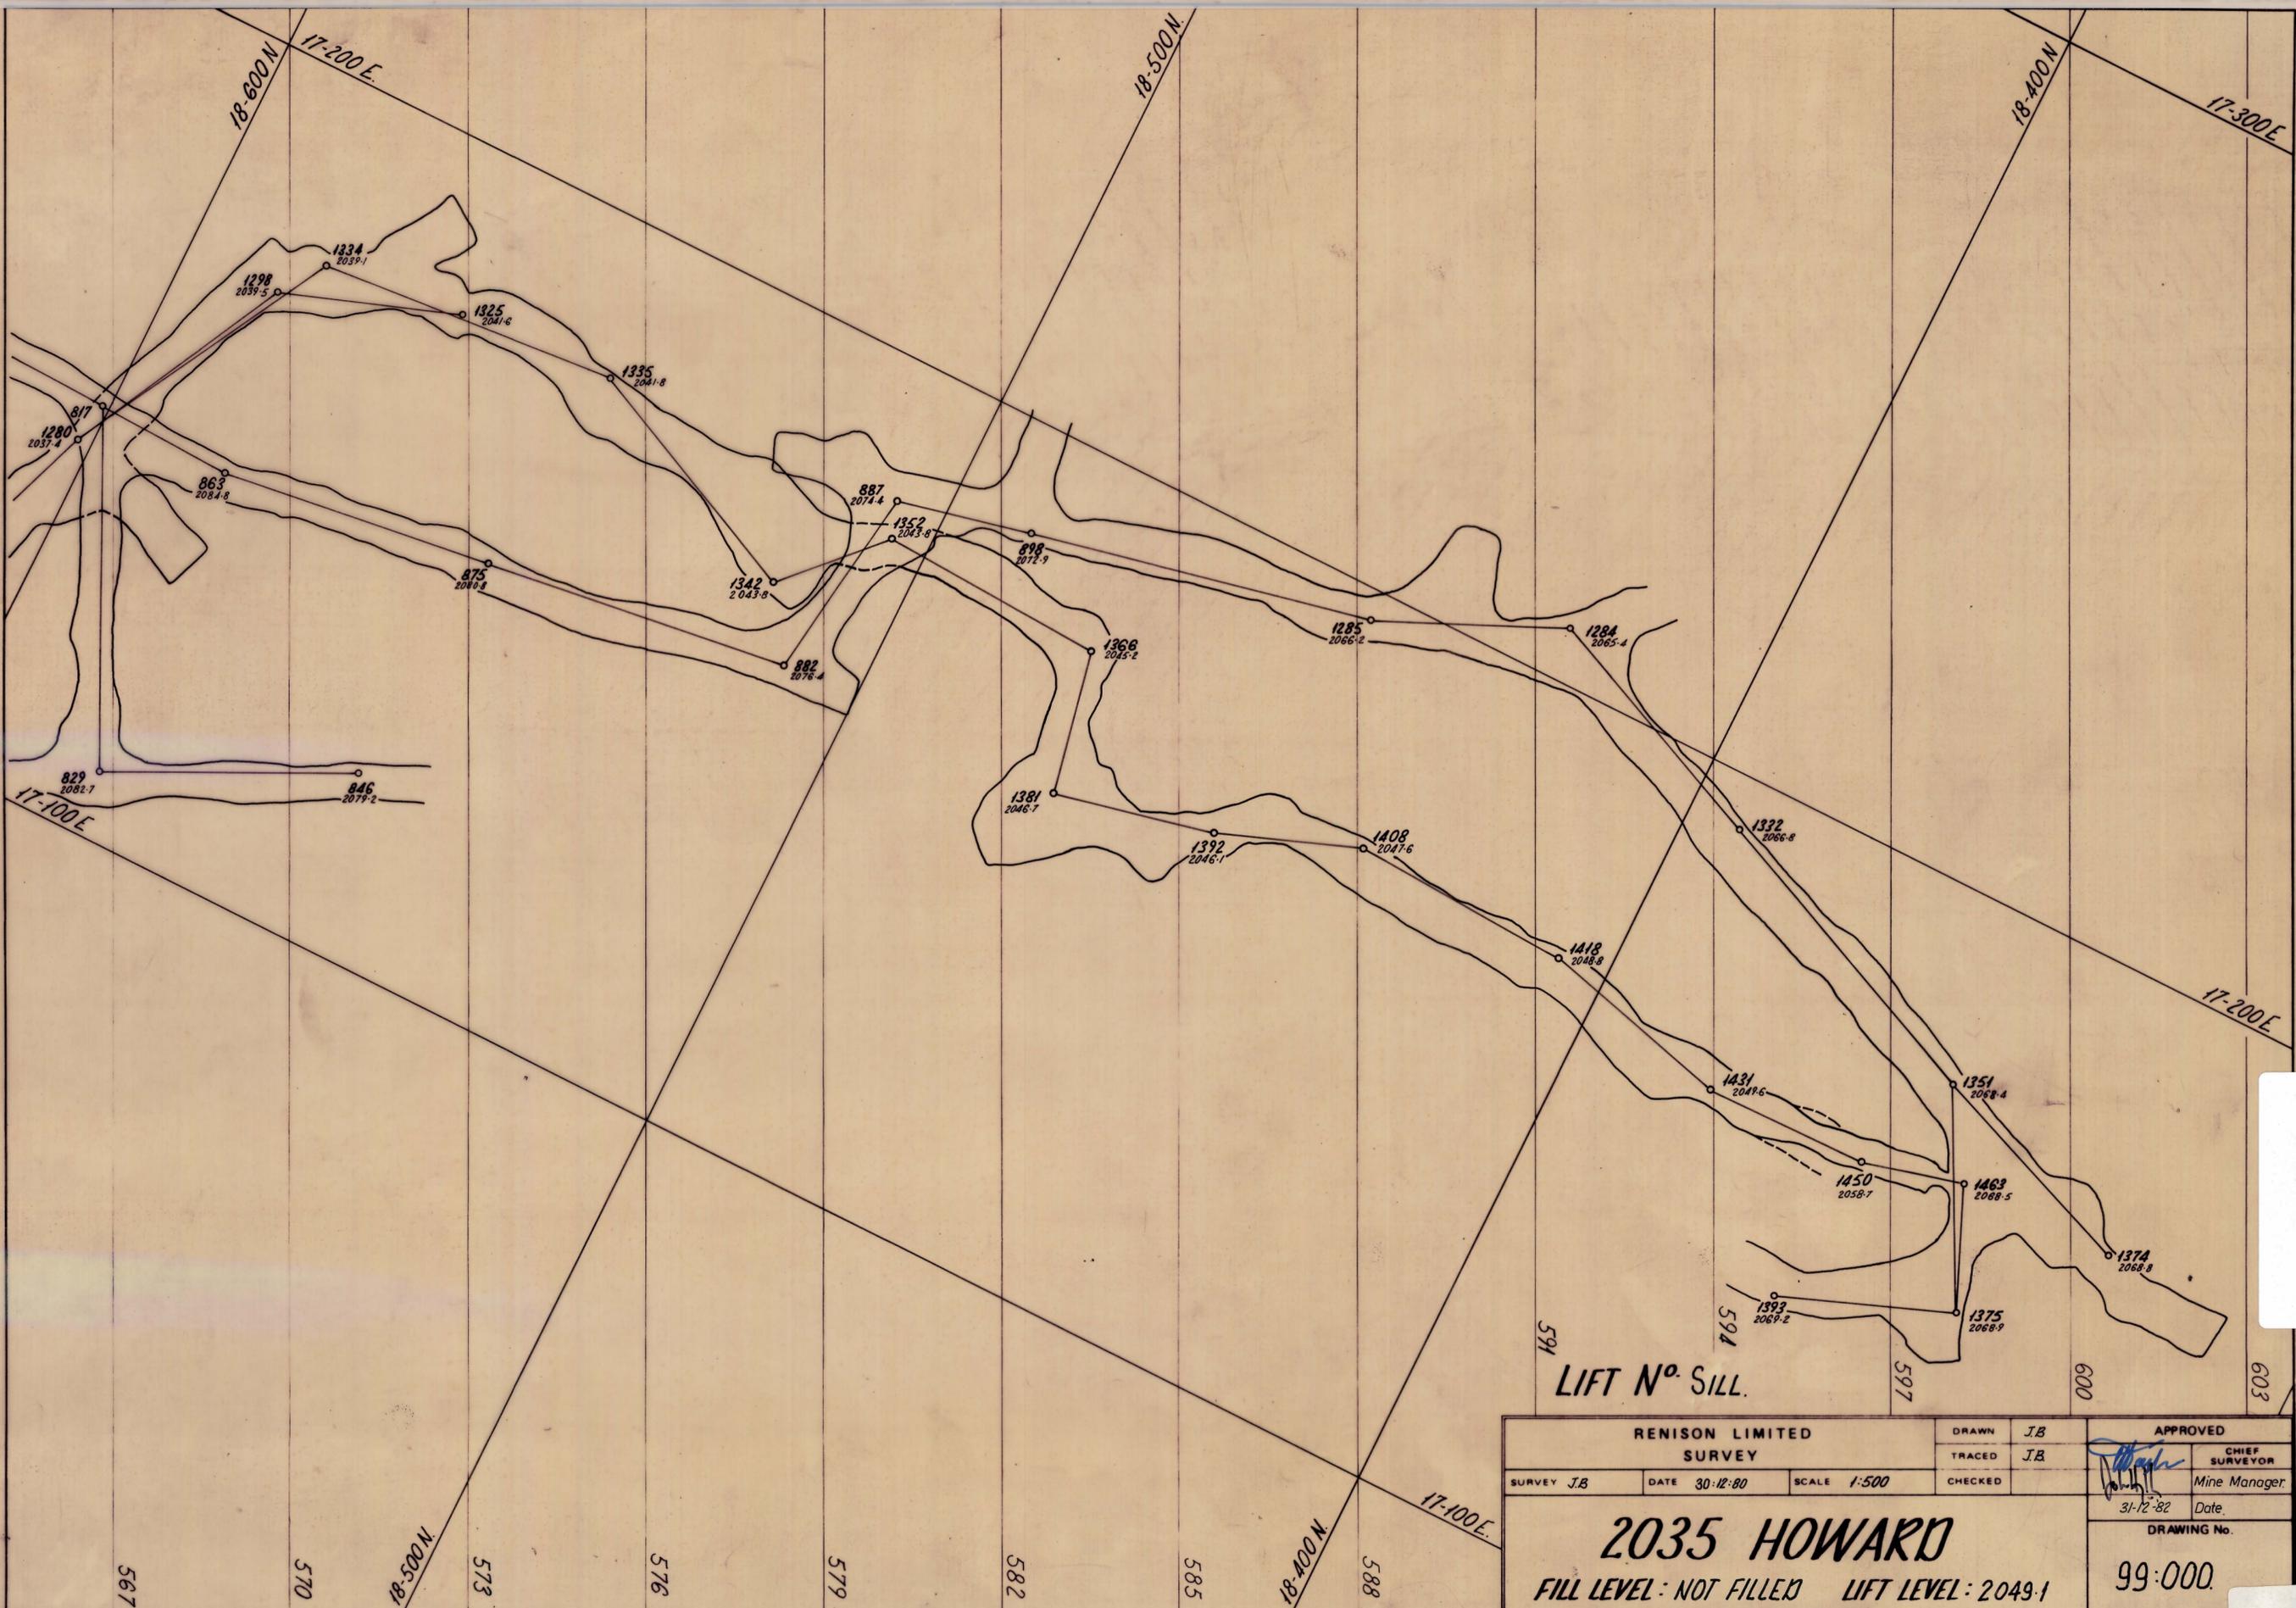

5 cm  
0376-366

RENISON LIMITED			DRAWN	J.B.	APPROVED	
SURVEY			TRACED	J.B.	CHIEF SURVEYOR	
SURVEY	DATE	SCALE	CHECKED	Mine Manager		
J.B.	30-12-80	1:500		31-12-82 Date		
2035 HOWARD						DRAWING No.
FILL LEVEL: NOT FILLED LIFT LEVEL: 2049.1						99:000

83239