


0376-367

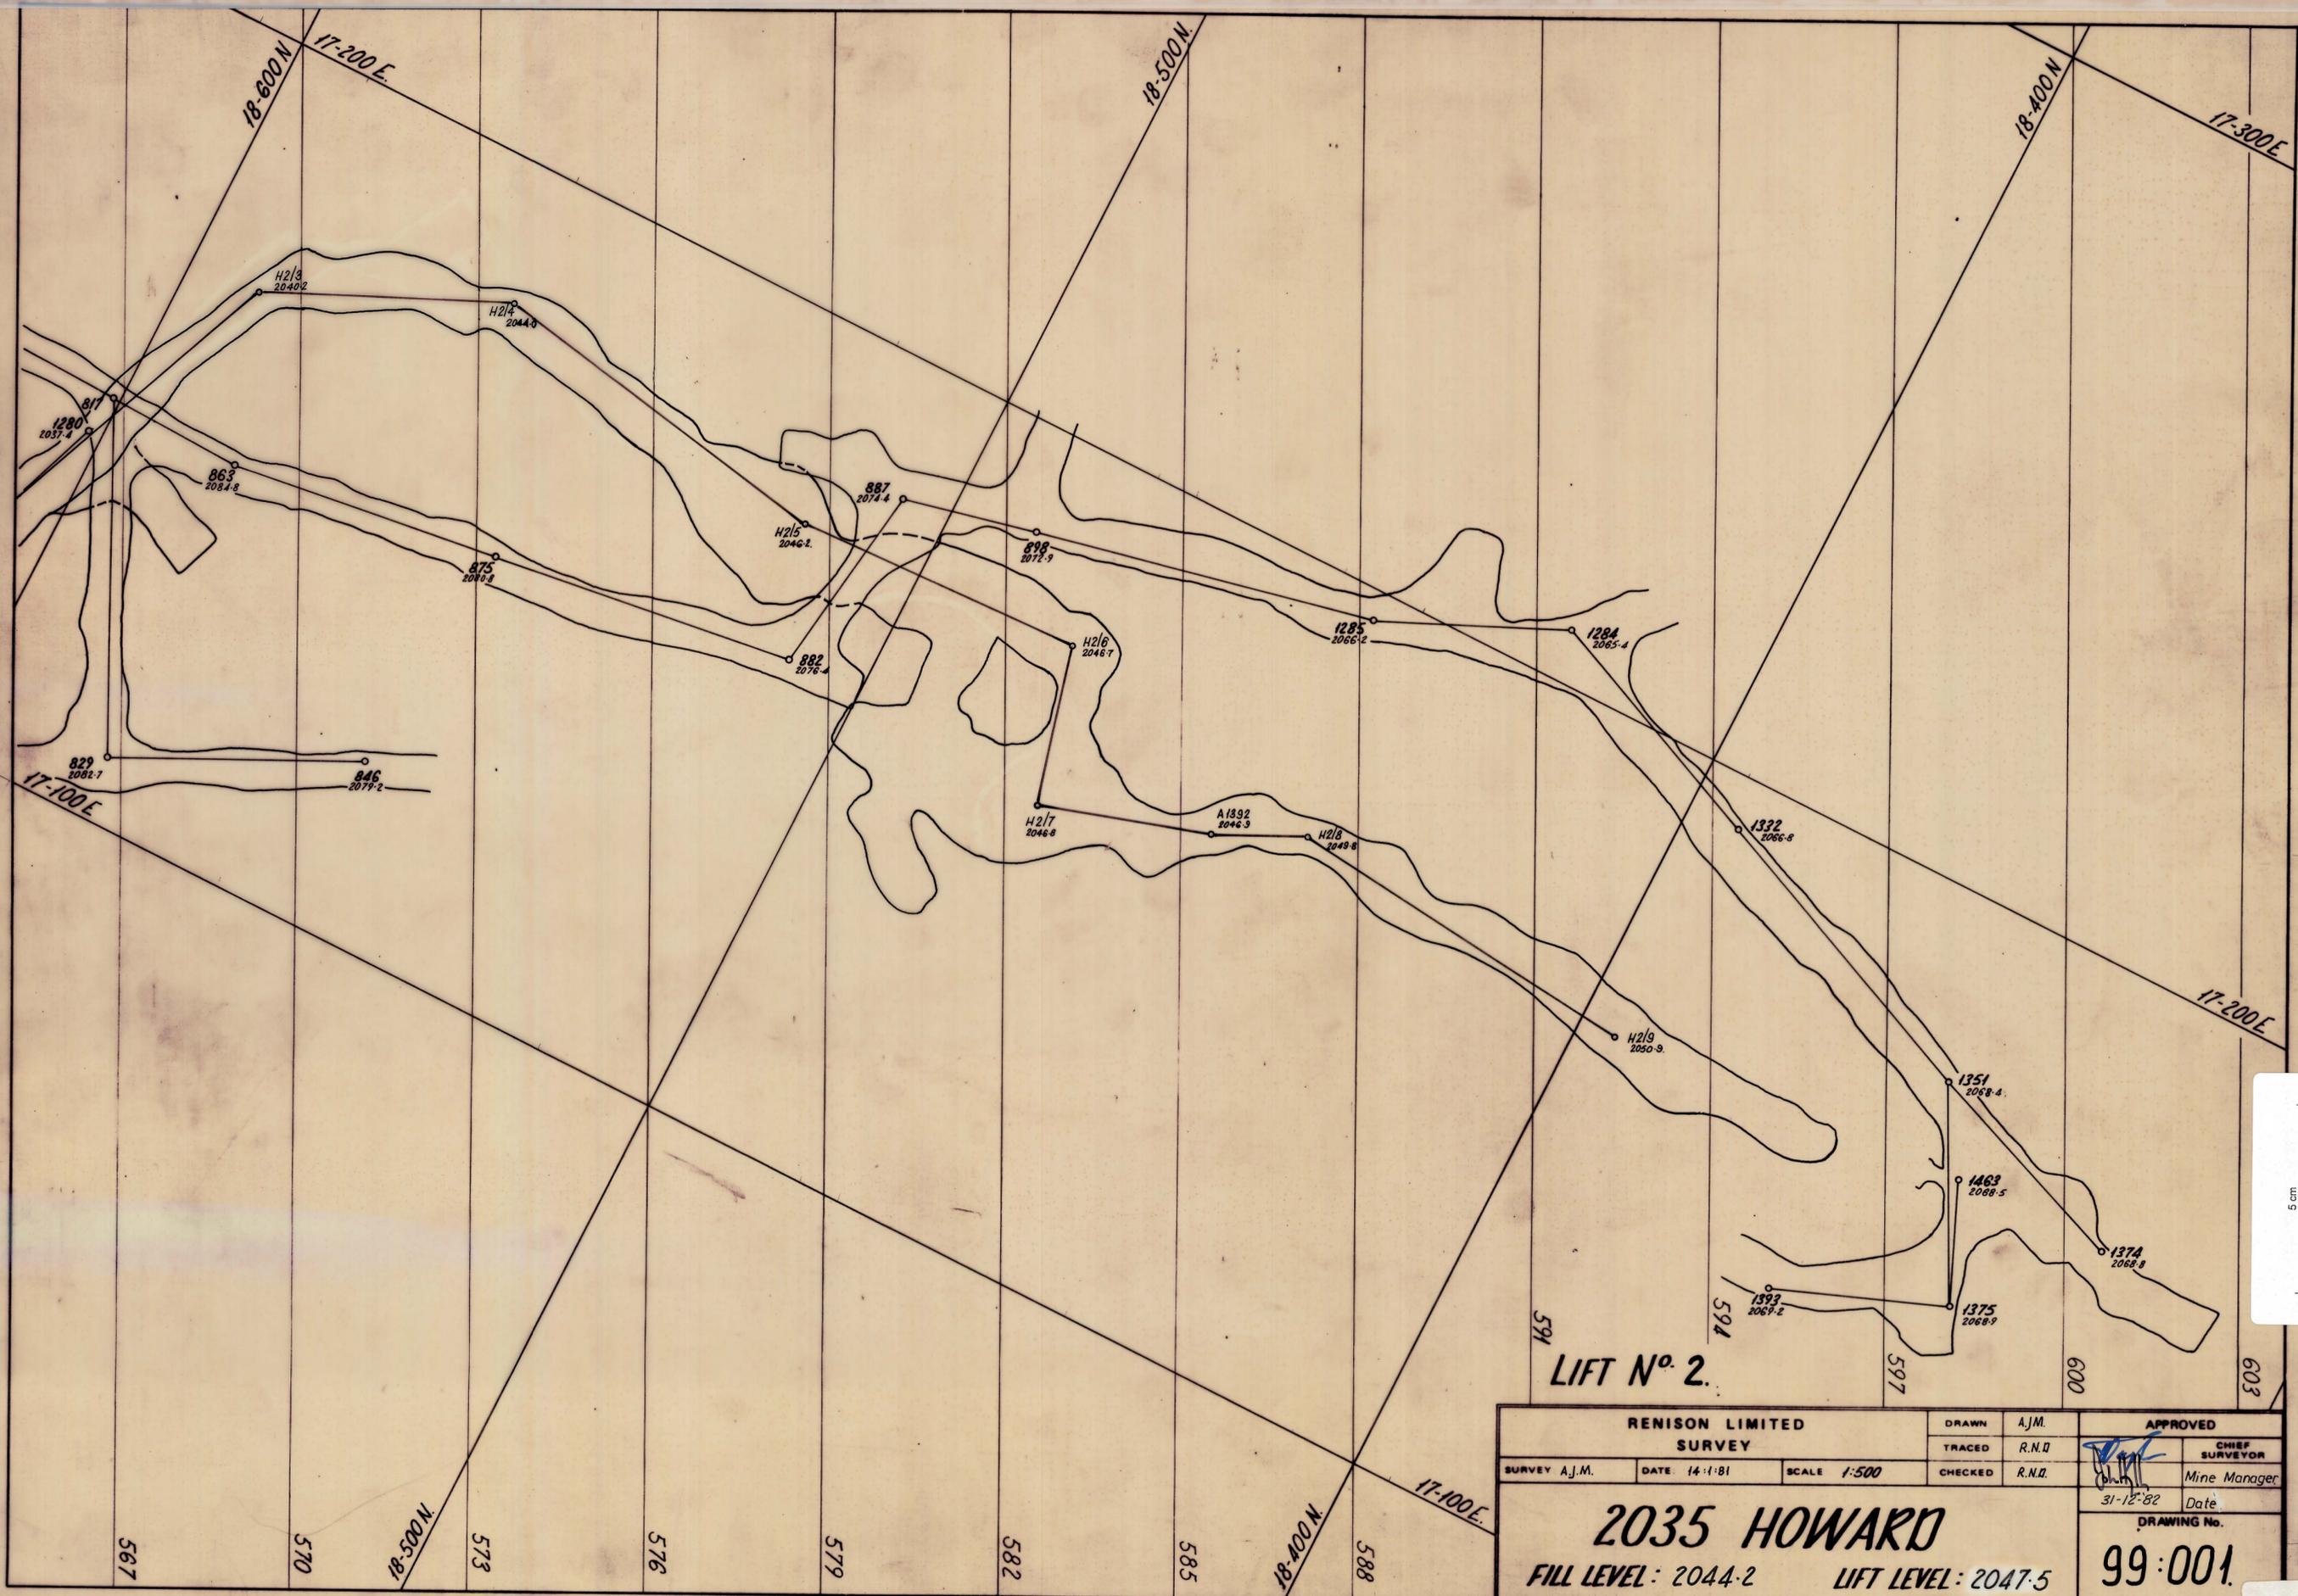

0376-367
5 cm

LIFT N° 2.

RENISON LIMITED SURVEY			DRAWN A.J.M.	APPROVED	
			TRACED R.N.D.	CHIEF SURVEYOR	
SURVEY A.J.M.	DATE 14-1-81	SCALE 1:500	CHECKED R.N.D.	Mine Manager	
2035 HOWARD			31-12-82 Date		DRAWING No.
FILL LEVEL: 2044.2			LIFT LEVEL: 2047.5		99:001

83240