


0376-368

0376-368  
5 cm

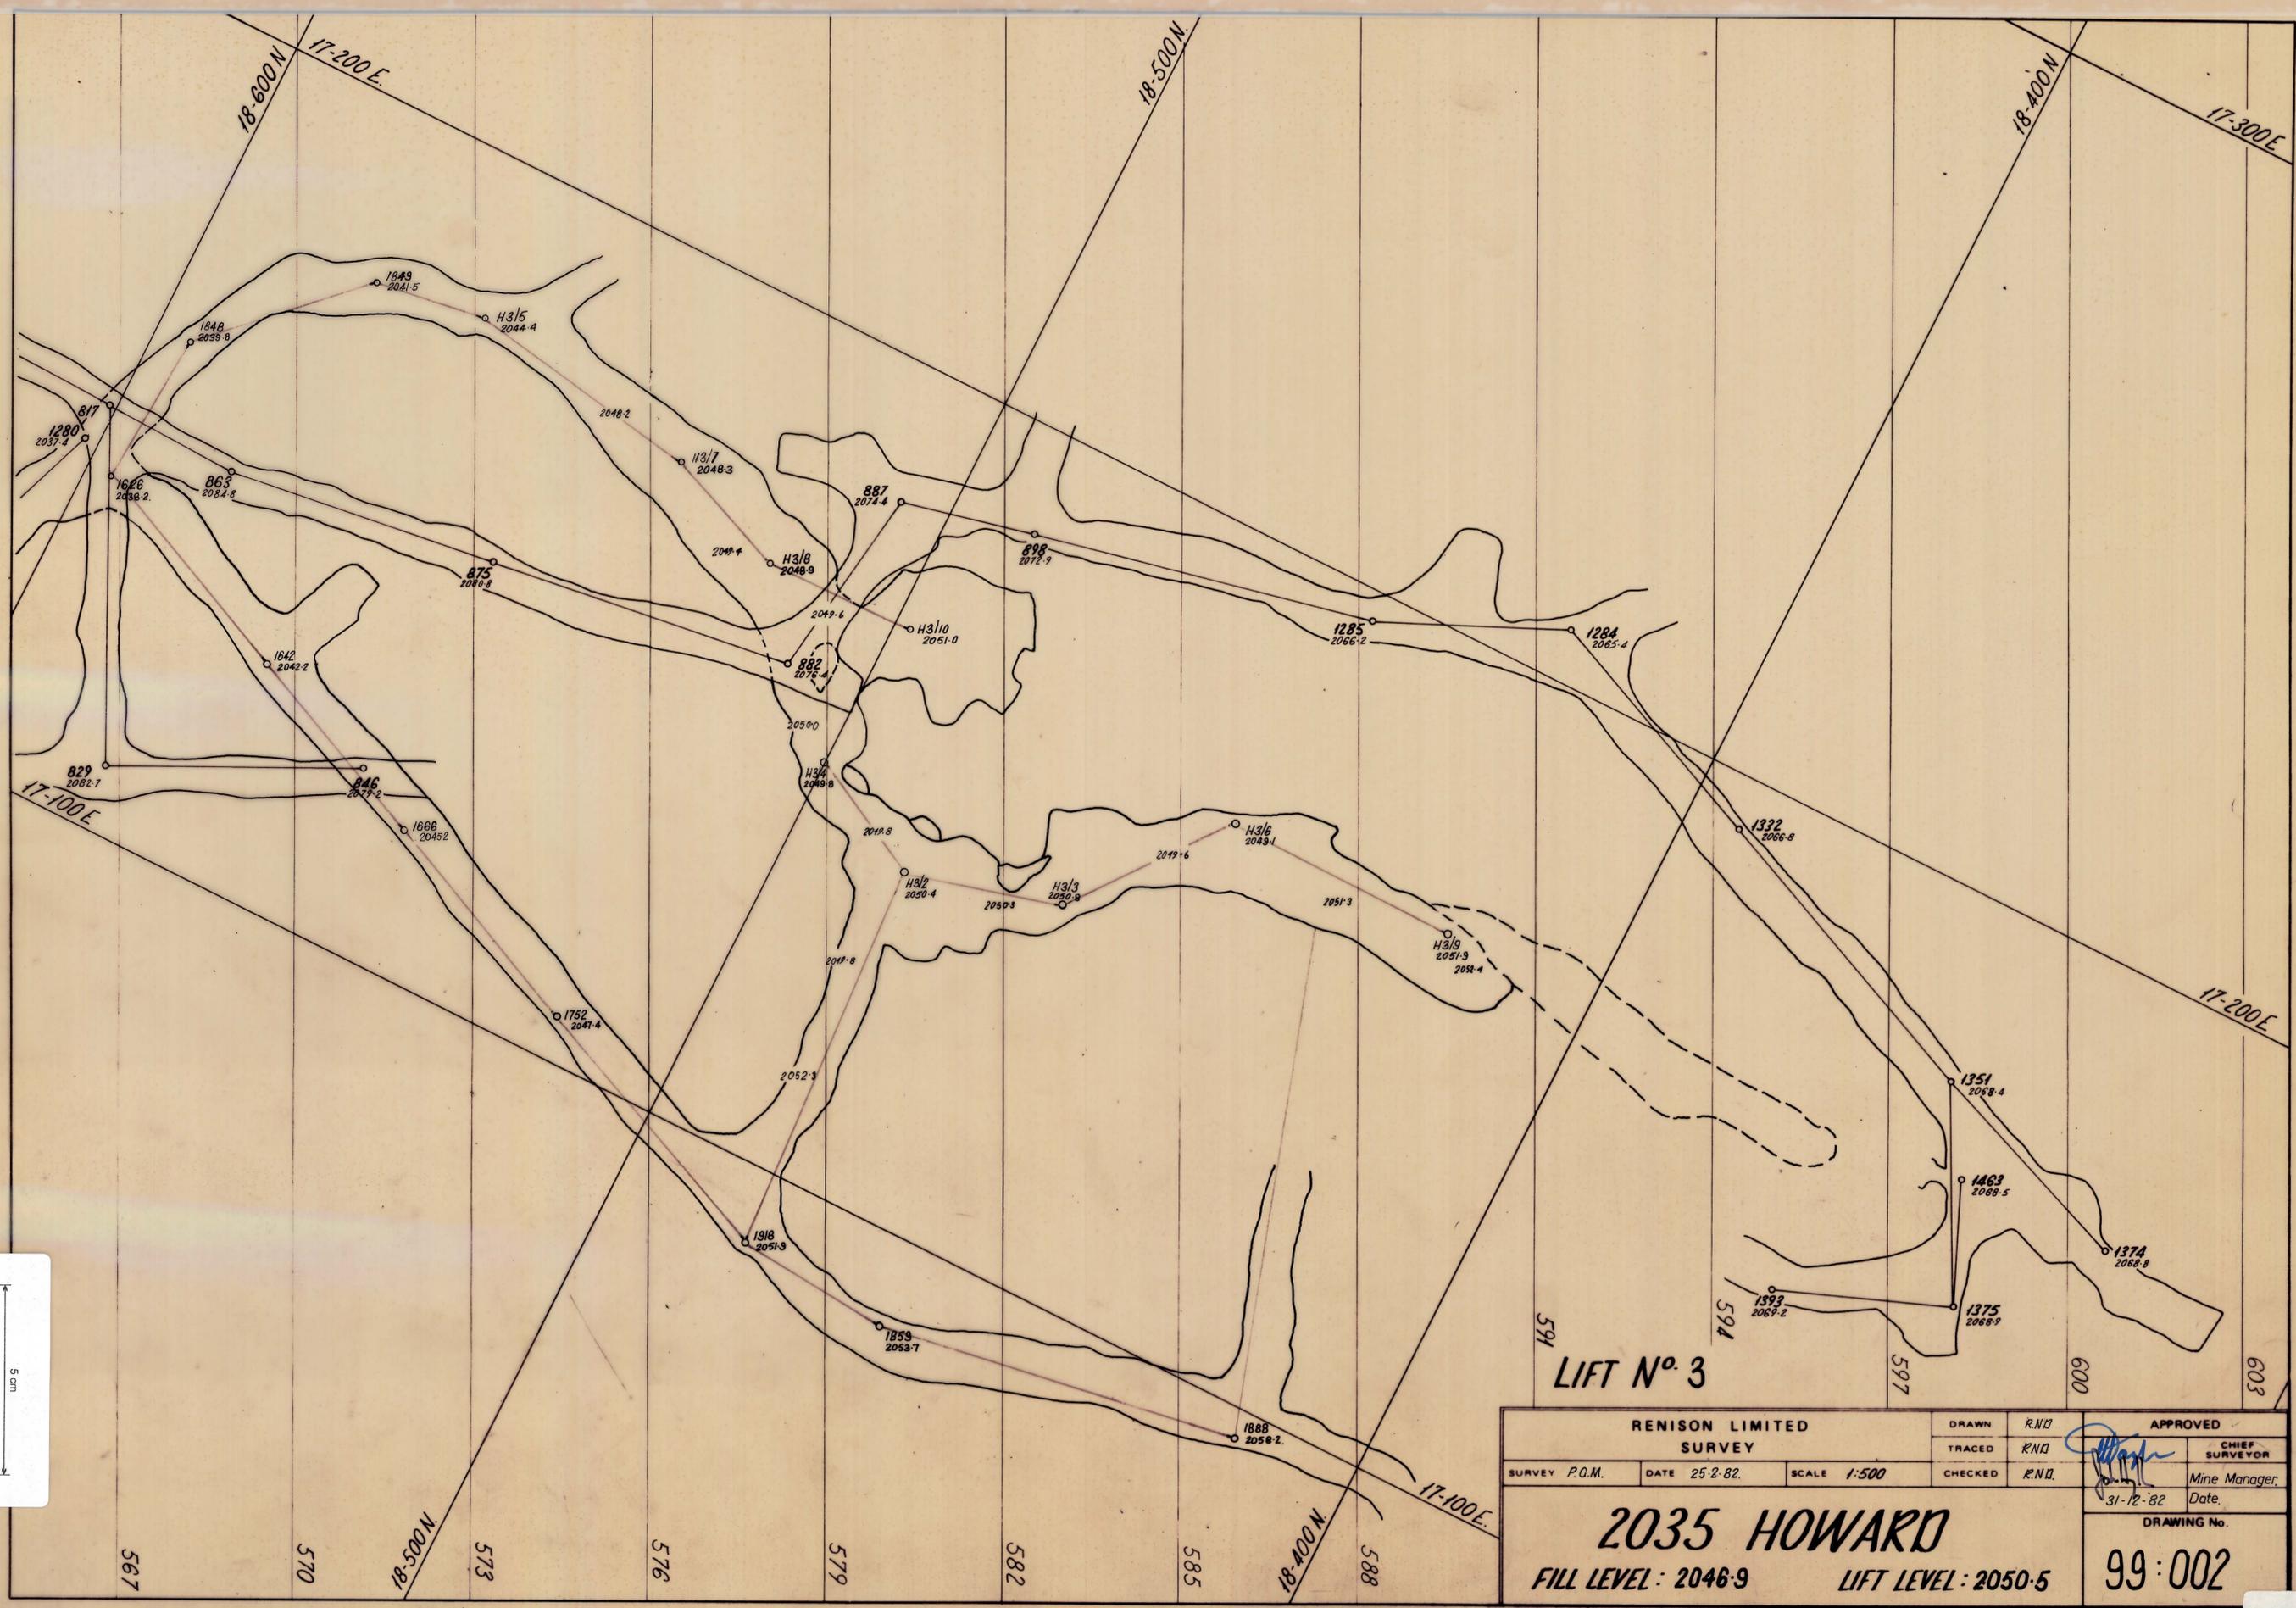

RENISON LIMITED SURVEY			DRAWN R.N.D.	APPROVED
			TRACED R.N.D.	CHIEF SURVEYOR
SURVEY P.C.M.	DATE 25-2-82.	SCALE 1:500	CHECKED R.N.D.	Mine Manager
<b>2035 HOWARD</b> FILL LEVEL : 2046.9      LIFT LEVEL : 2050.5				31-12-82 Date DRAWING No. <b>99:002</b>

83241