


0376-369

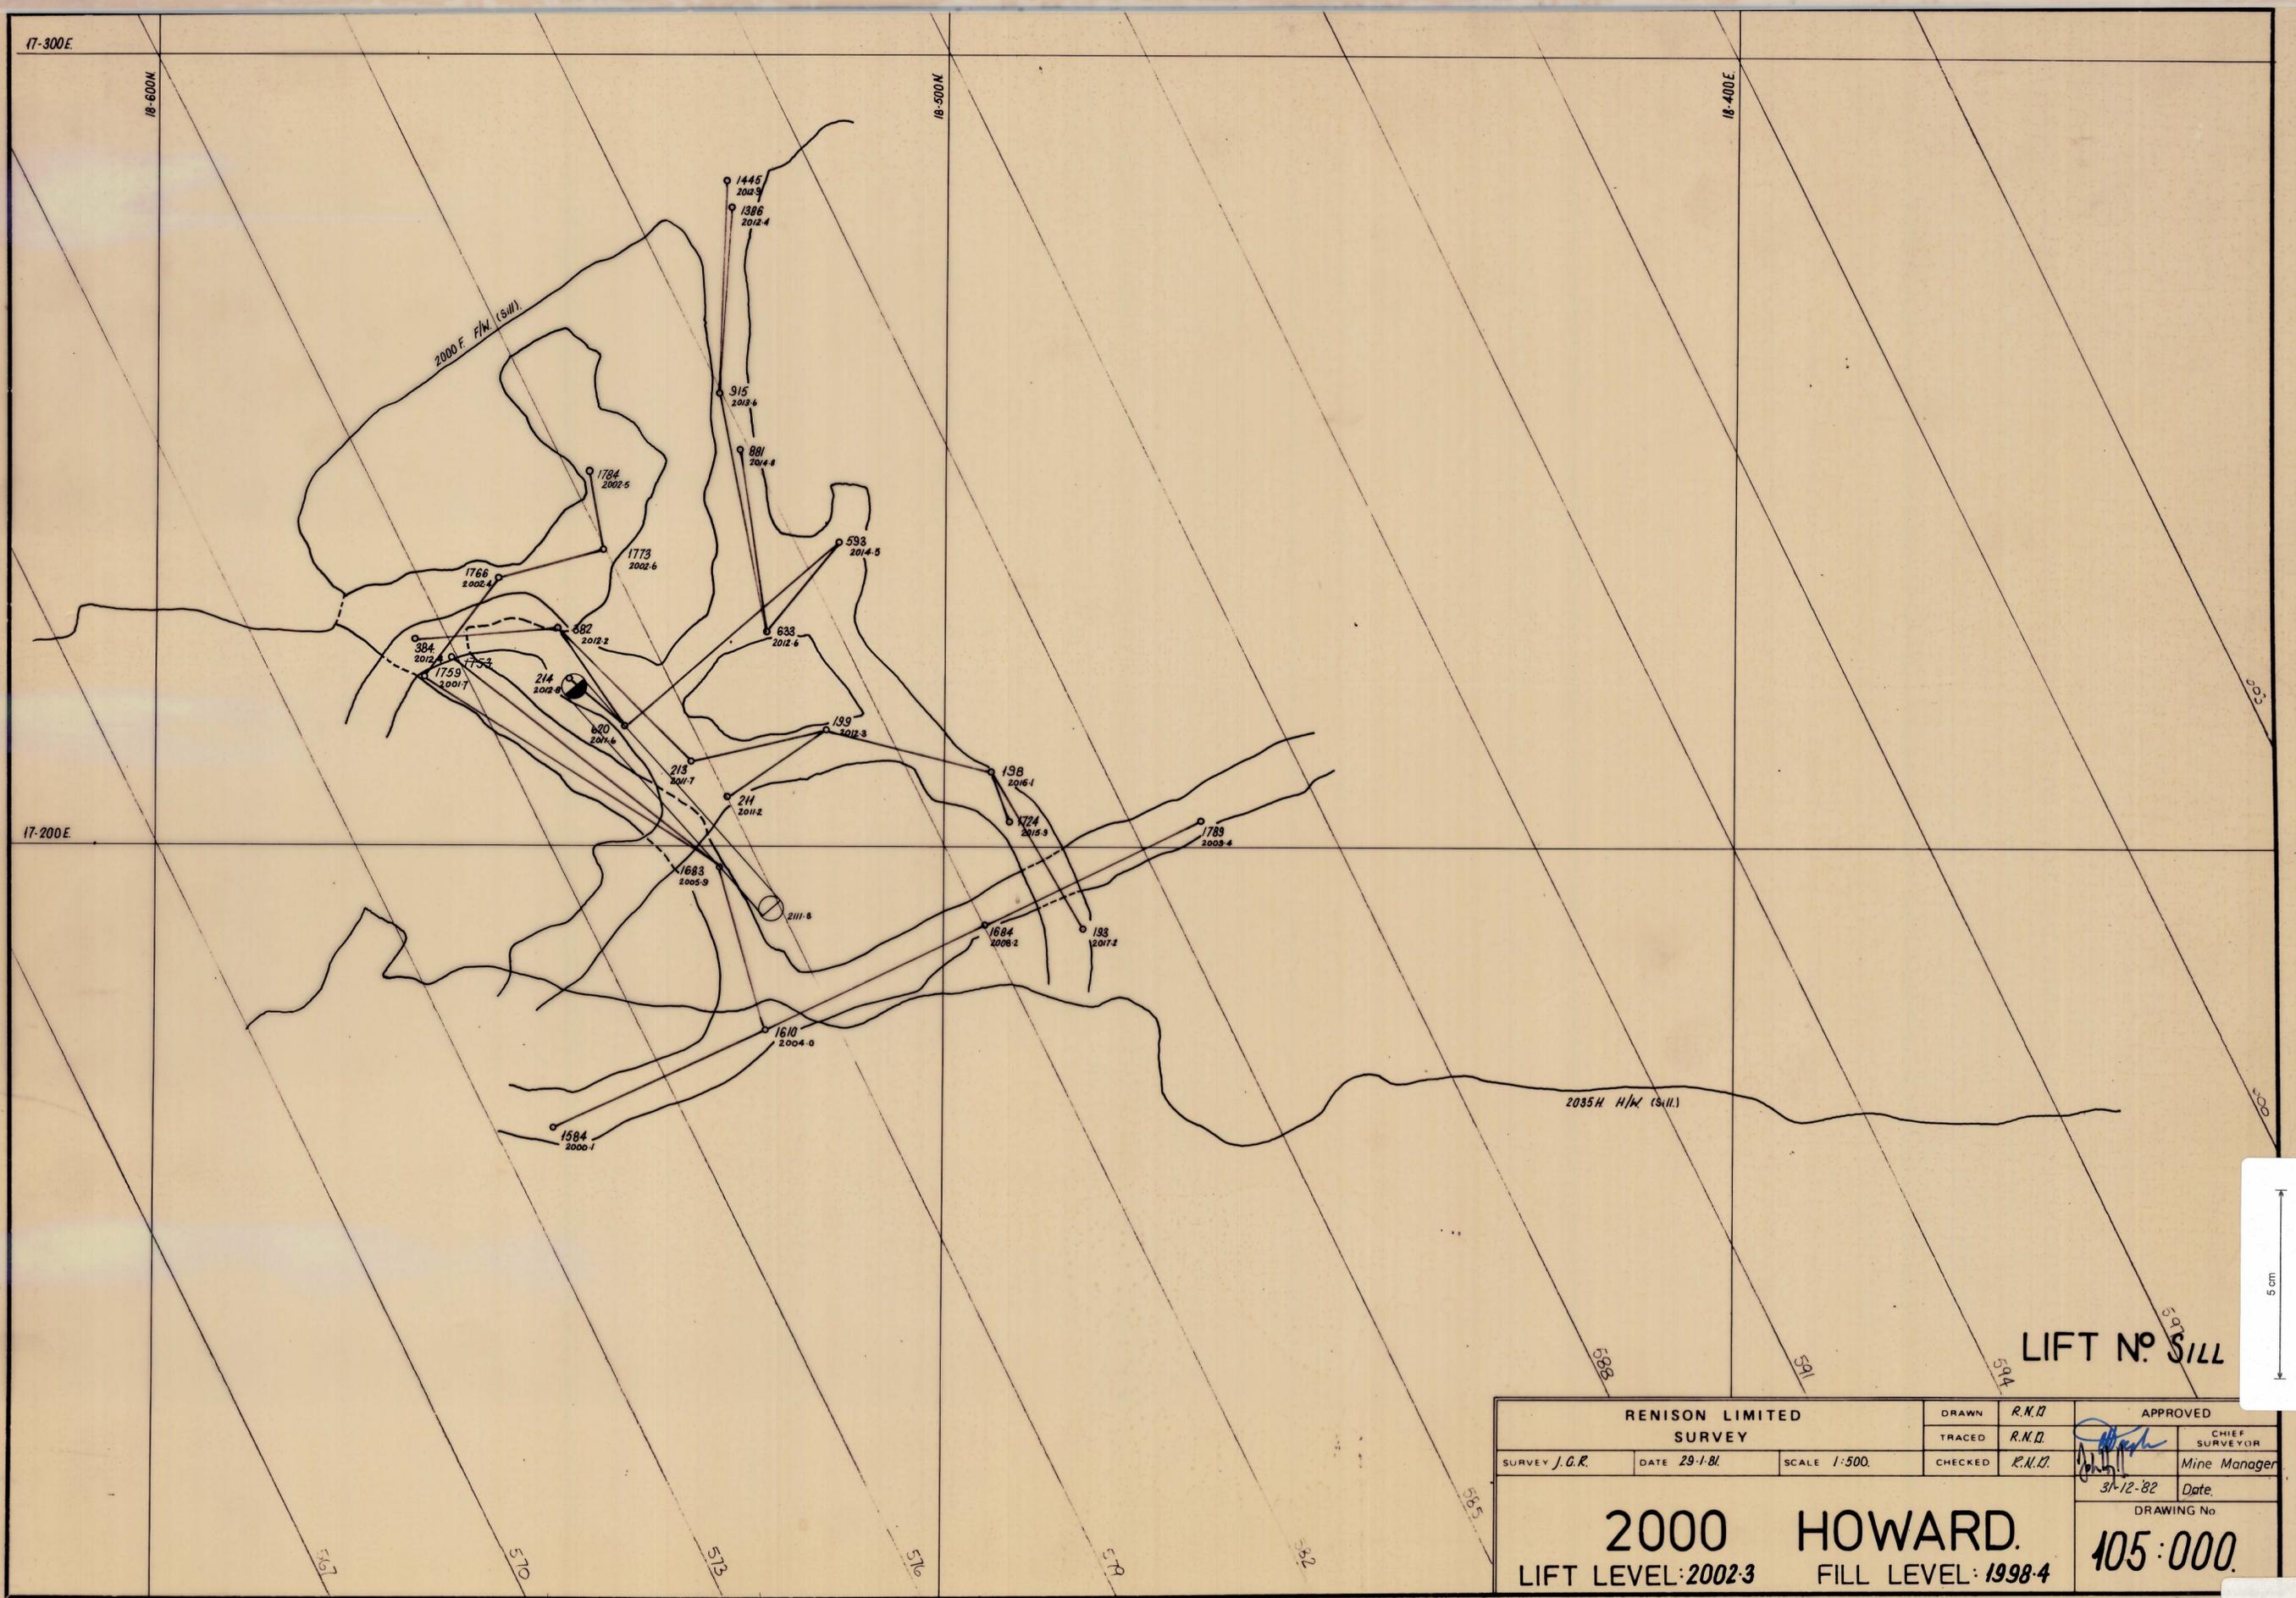

RENISON LIMITED SURVEY			DRAWN R.N.D.	APPROVED	
SURVEY J.G.R.			TRACED R.N.D.	CHIEF SURVEYOR	
DATE 29-1-81	SCALE 1:500	CHECKED R.N.D.	Date 31-12-82		Mine Manager
2000 HOWARD.			DRAWING No		105:000
LIFT LEVEL: 2002-3			FILL LEVEL: 1998-4		

5 cm
0376-369

83242