


0376-371

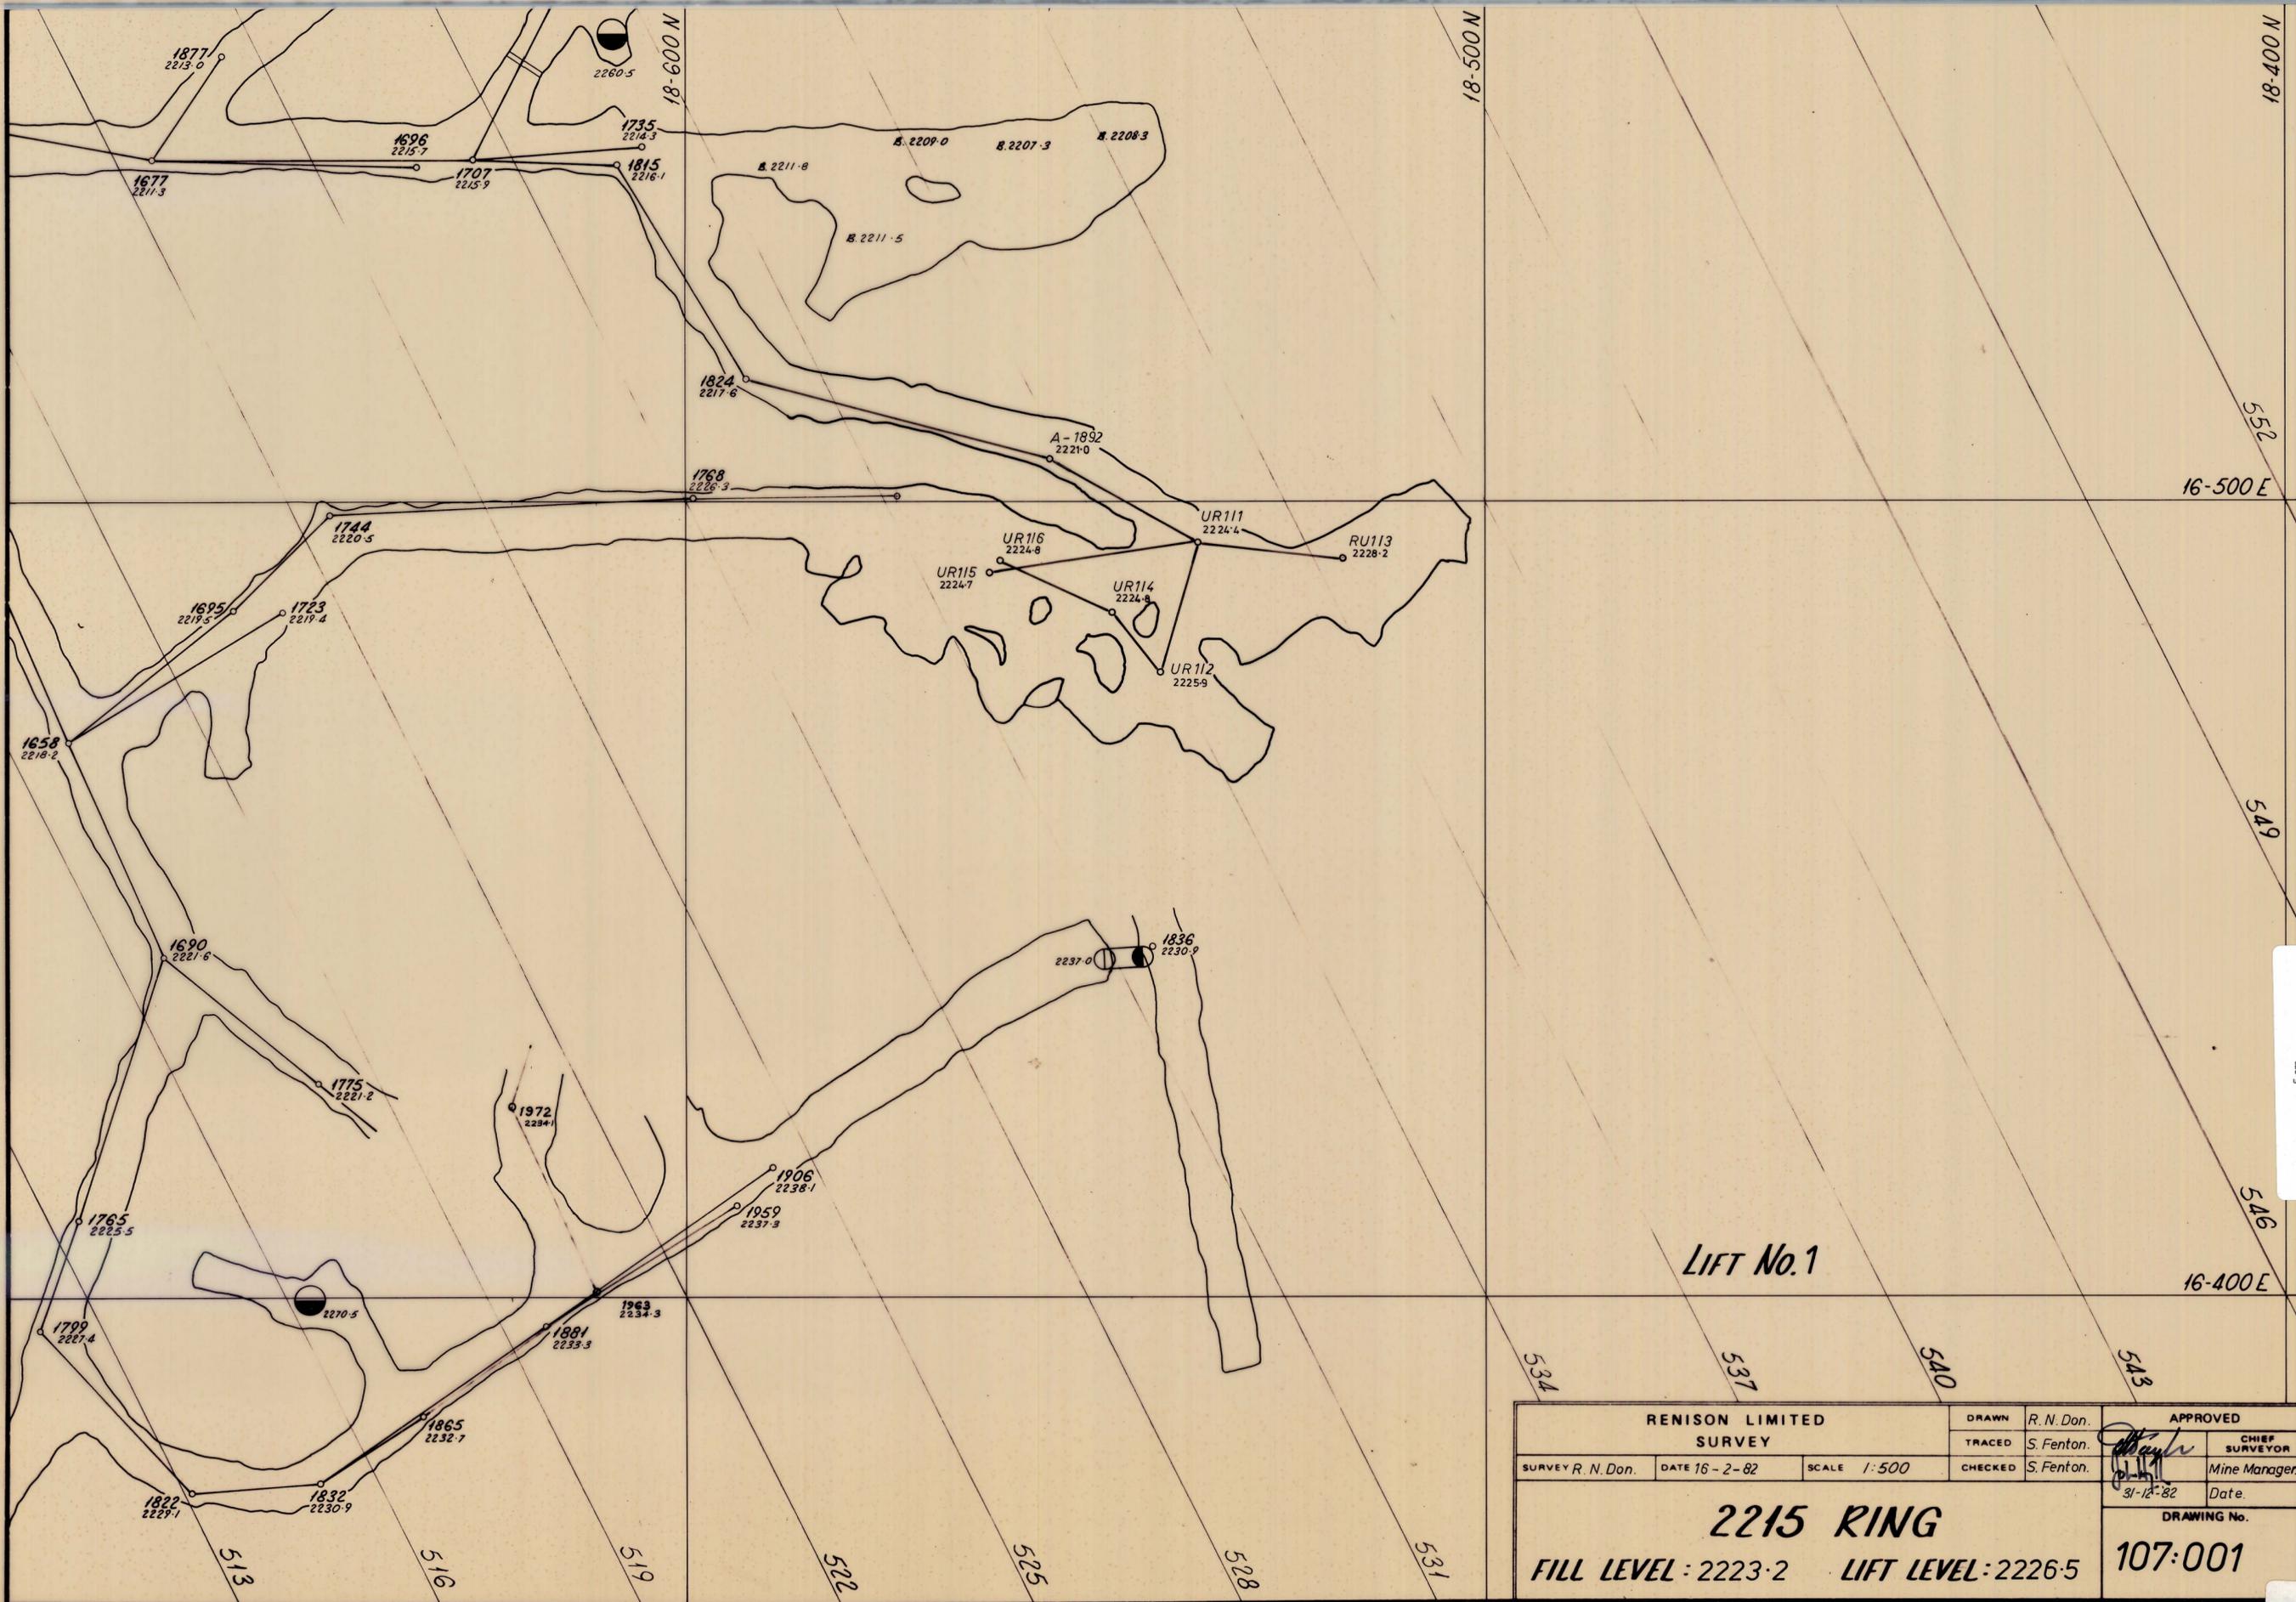

5 cm
0376-371

RENISON LIMITED SURVEY			DRAWN R. N. Don.	APPROVED <i>[Signature]</i> CHIEF SURVEYOR
			TRACED S. Fenton.	
SURVEY R. N. Don.	DATE 16-2-82	SCALE 1:500	CHECKED S. Fenton.	Date 31-12-82
2215 RING FILL LEVEL: 2223.2 LIFT LEVEL: 2226.5			DRAWING No. 107:001	

83244