


0376-374

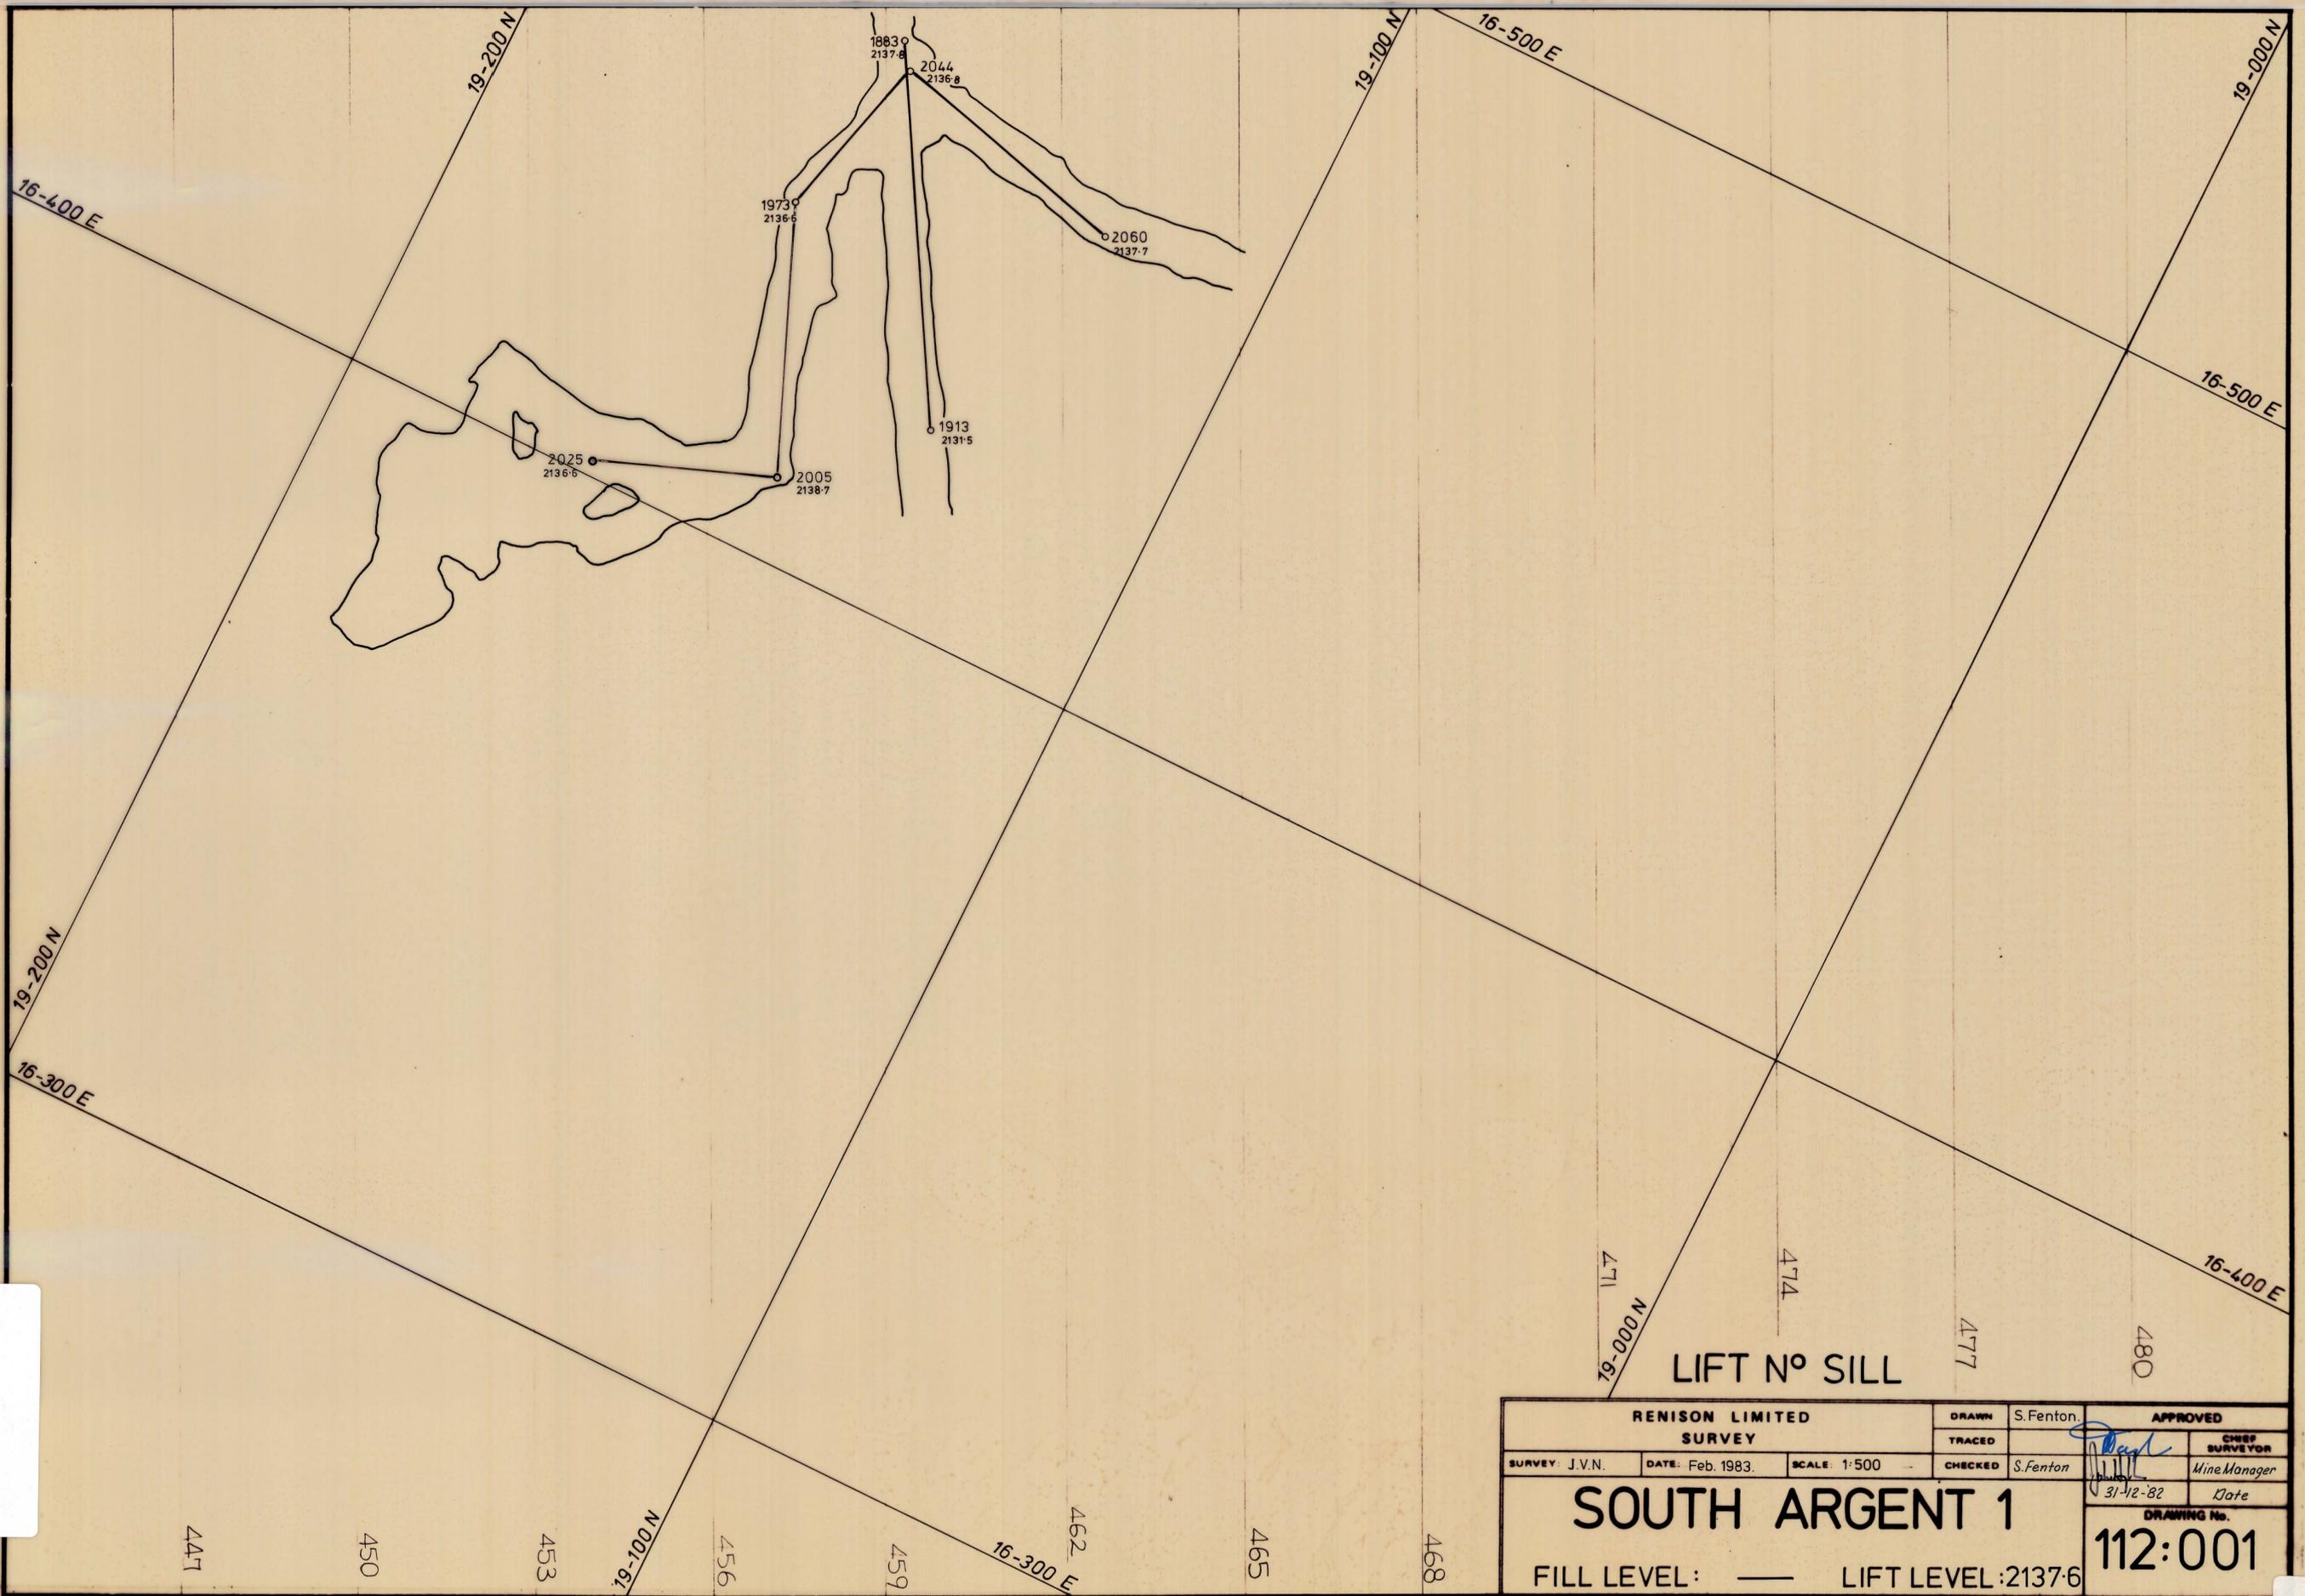

5 cm  
0376-374

RENISON LIMITED SURVEY			DRAWN S.Fenton	APPROVED	
SURVEY: J.V.N.			TRACED	CHIEF SURVEYOR	
DATE: Feb. 1983.	SCALE: 1:500	CHECKED S.Fenton	31-12-82		Mine Manager
<b>SOUTH ARGENT 1</b>				Date	
FILL LEVEL: —				LIFT LEVEL: 2137.6	
				DRAWING No. 112:001	

83247