


LIFT N^o. Sill.

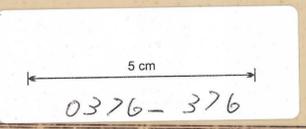

RENISON LIMITED SURVEY			DRAWN JGR	APPROVED
SURVEY JGR	DATE 17-8-82	SCALE 1:500	TRACED RND	CHIEF SURVEYOR <i>[Signature]</i>
			CHECKED RND	Mine Manager Date 31-12-82
1920 PENZANCE Sth				DRAWING No.
LIFT LEVEL: 1929.4				FILL LEVEL: —
				108:000/A