



0376-377

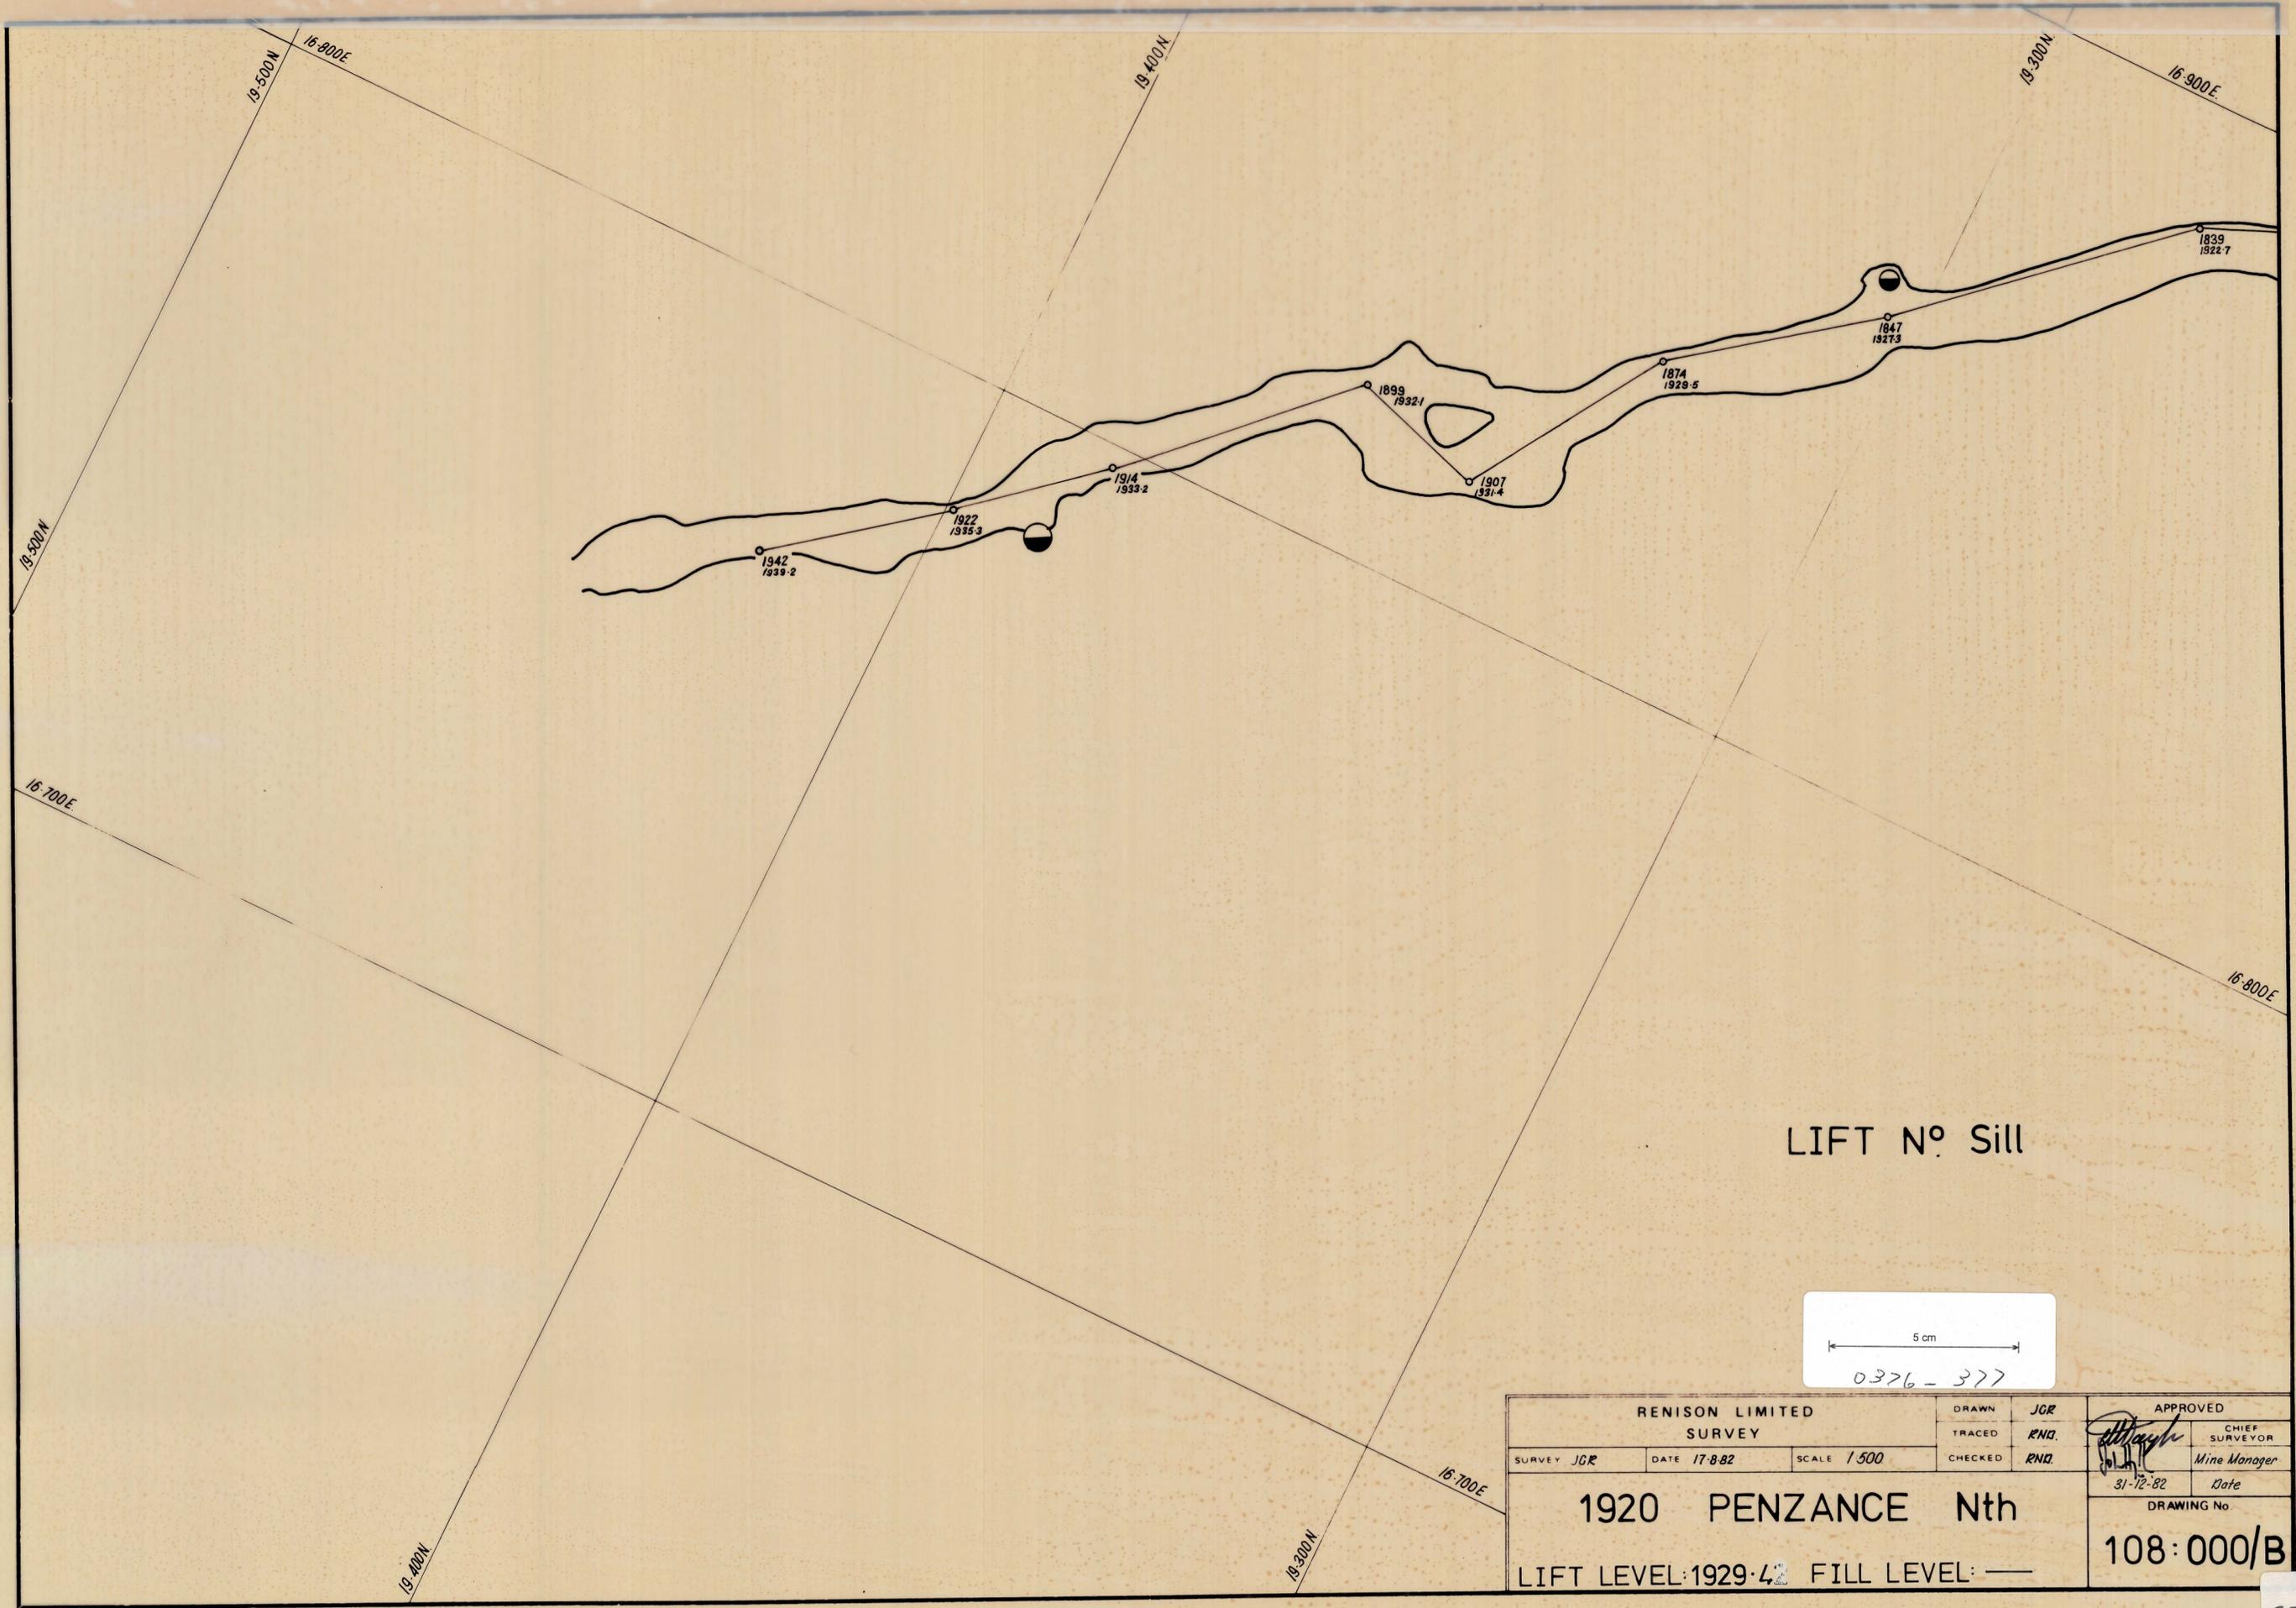

LIFT N° Sill

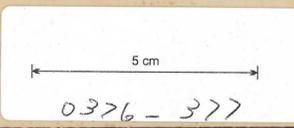

RENISON LIMITED SURVEY			DRAWN JGR	APPROVED	
			TRACED RNO.	CHIEF SURVEYOR	
			CHECKED RNO.	Mine Manager	
SURVEY JGR	DATE 17-8-82	SCALE 1/500	31-12-82 Date		
1920 PENZANCE Nth				DRAWING No	
LIFT LEVEL: 1929.42				108:000/B	
FILL LEVEL: —					

83196