
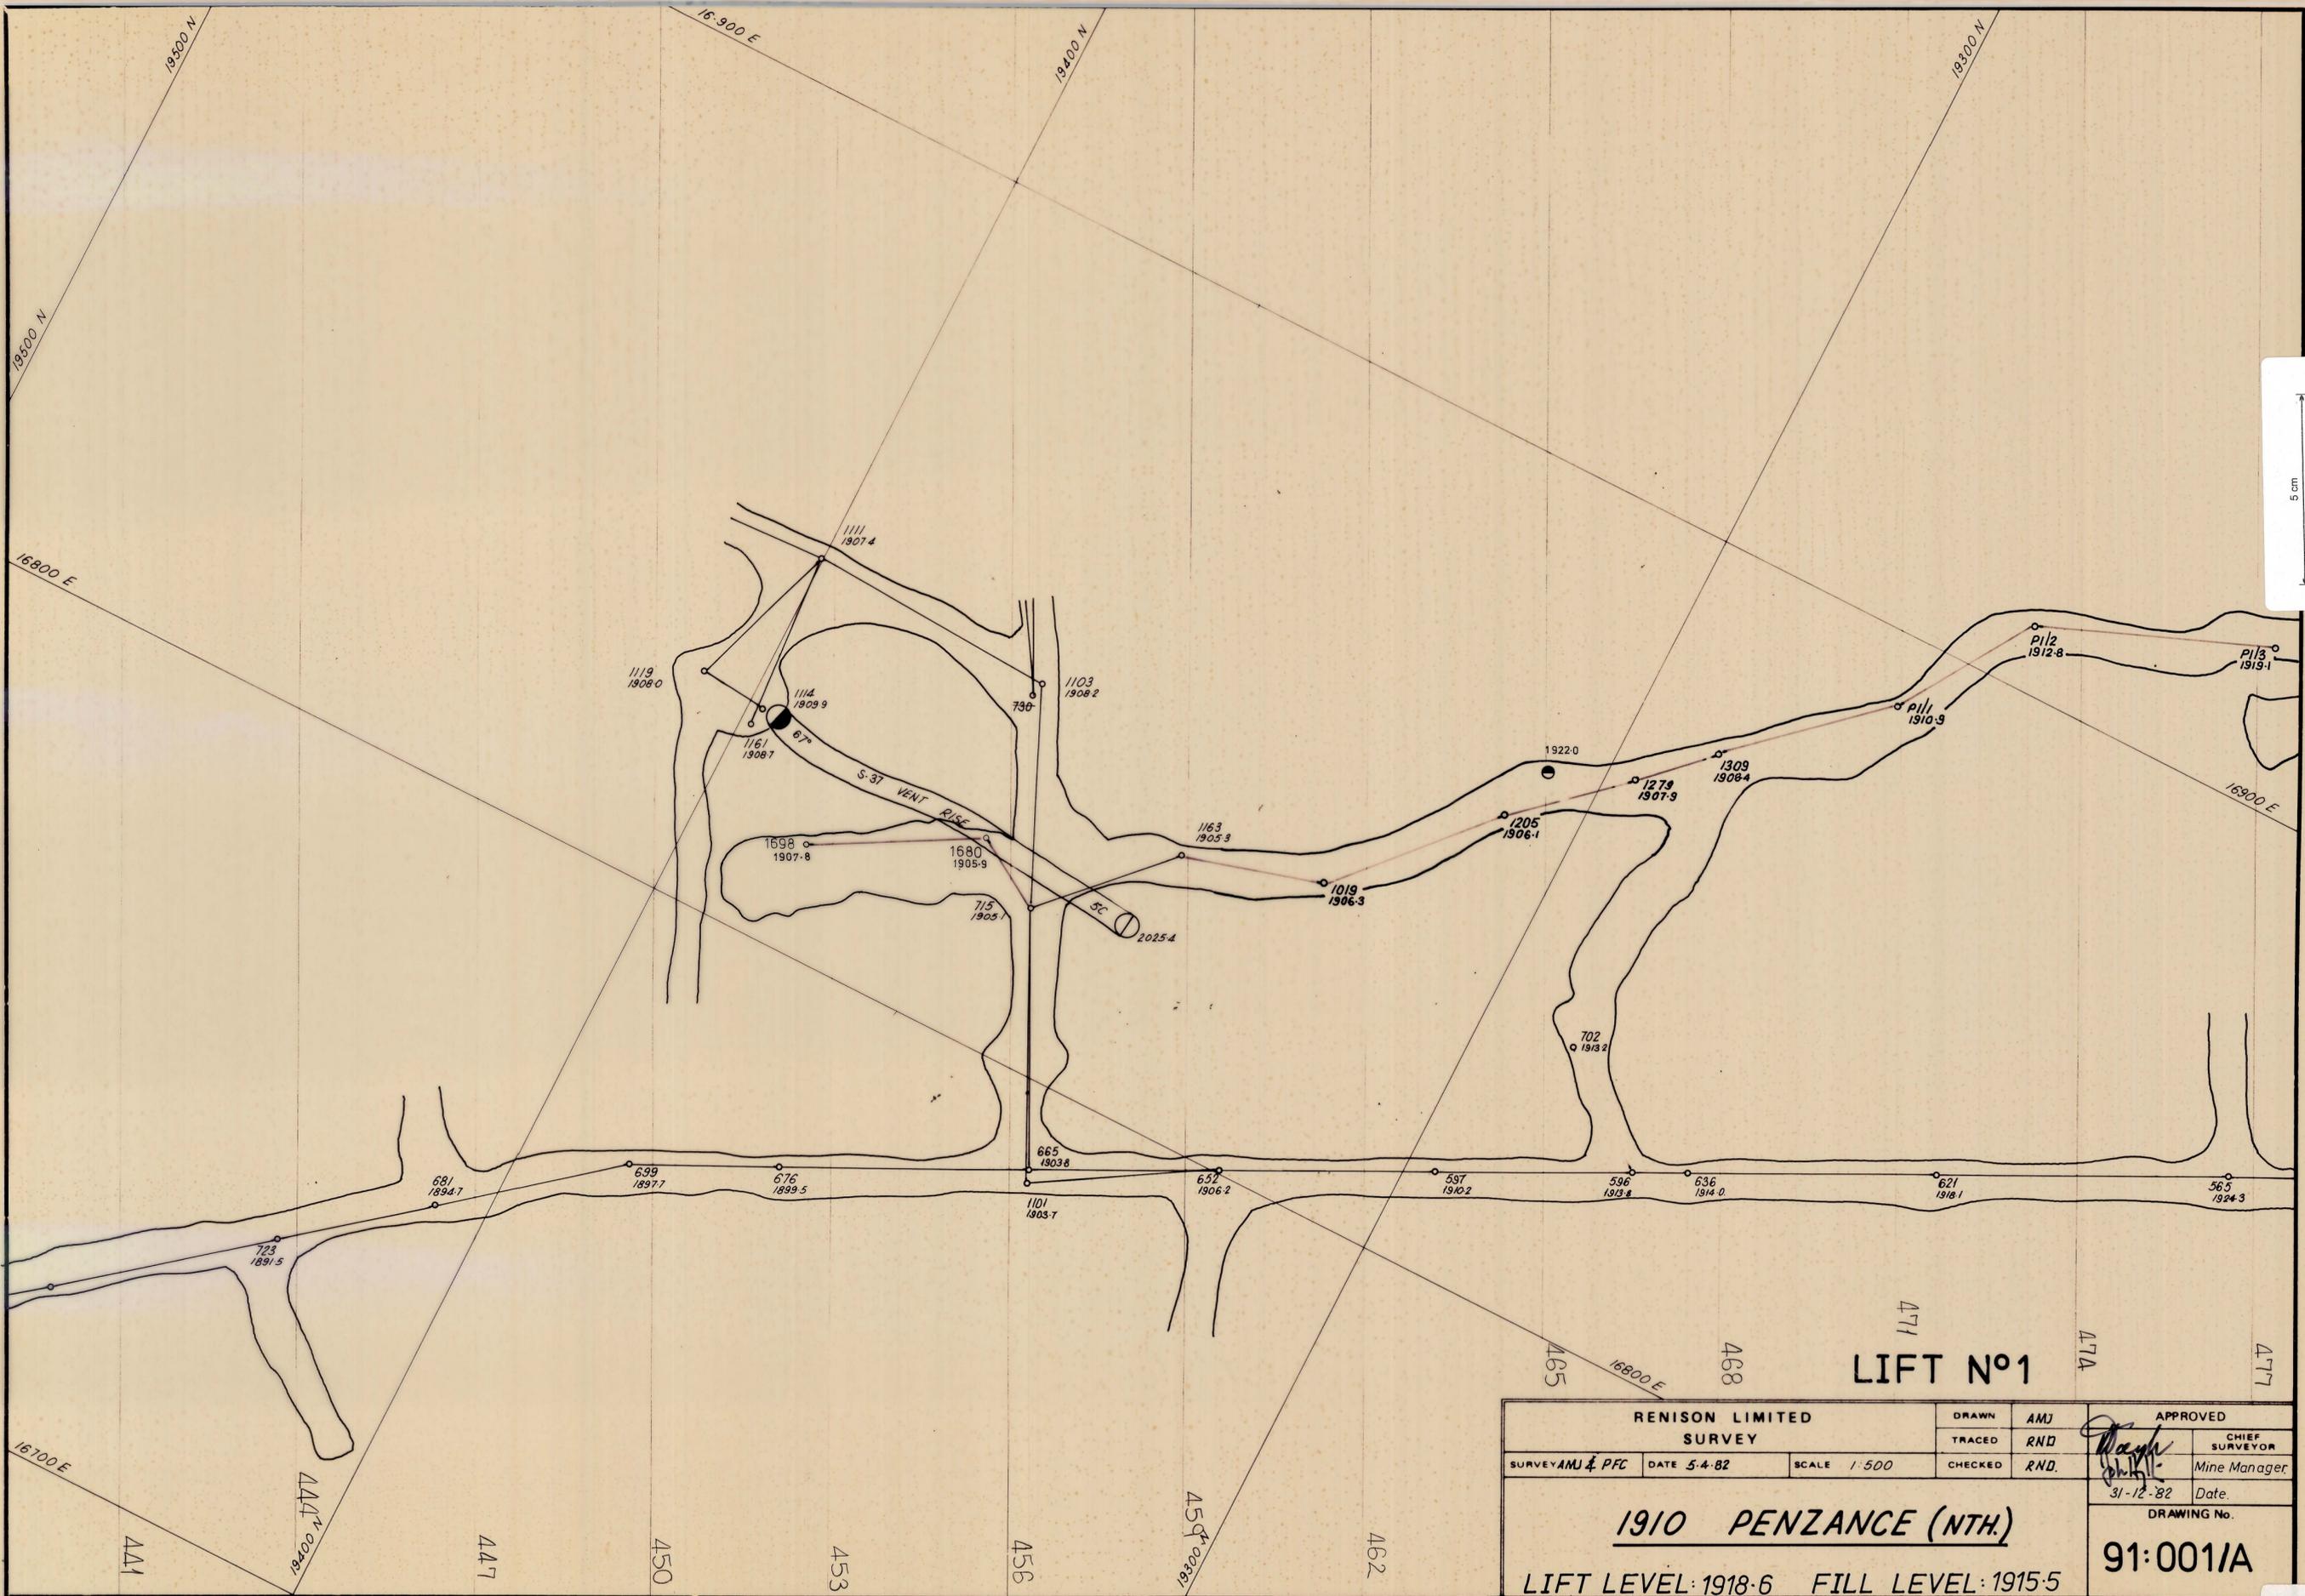


0376-380

5 cm
0376-380

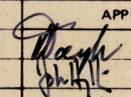

RENISON LIMITED SURVEY			DRAWN AMJ	APPROVED	
			TRACED RND	CHIEF SURVEYOR	
SURVEY AMJ & PFC	DATE 5-4-82	SCALE 1:500	CHECKED RND	 Mine Manager	
1910 PENZANCE (NTH.)				31-12-82 Date	
LIFT LEVEL: 1918.6 FILL LEVEL: 1915.5				DRAWING No. 91:001/A	

83199