


0376-382

5 cm

0376-382

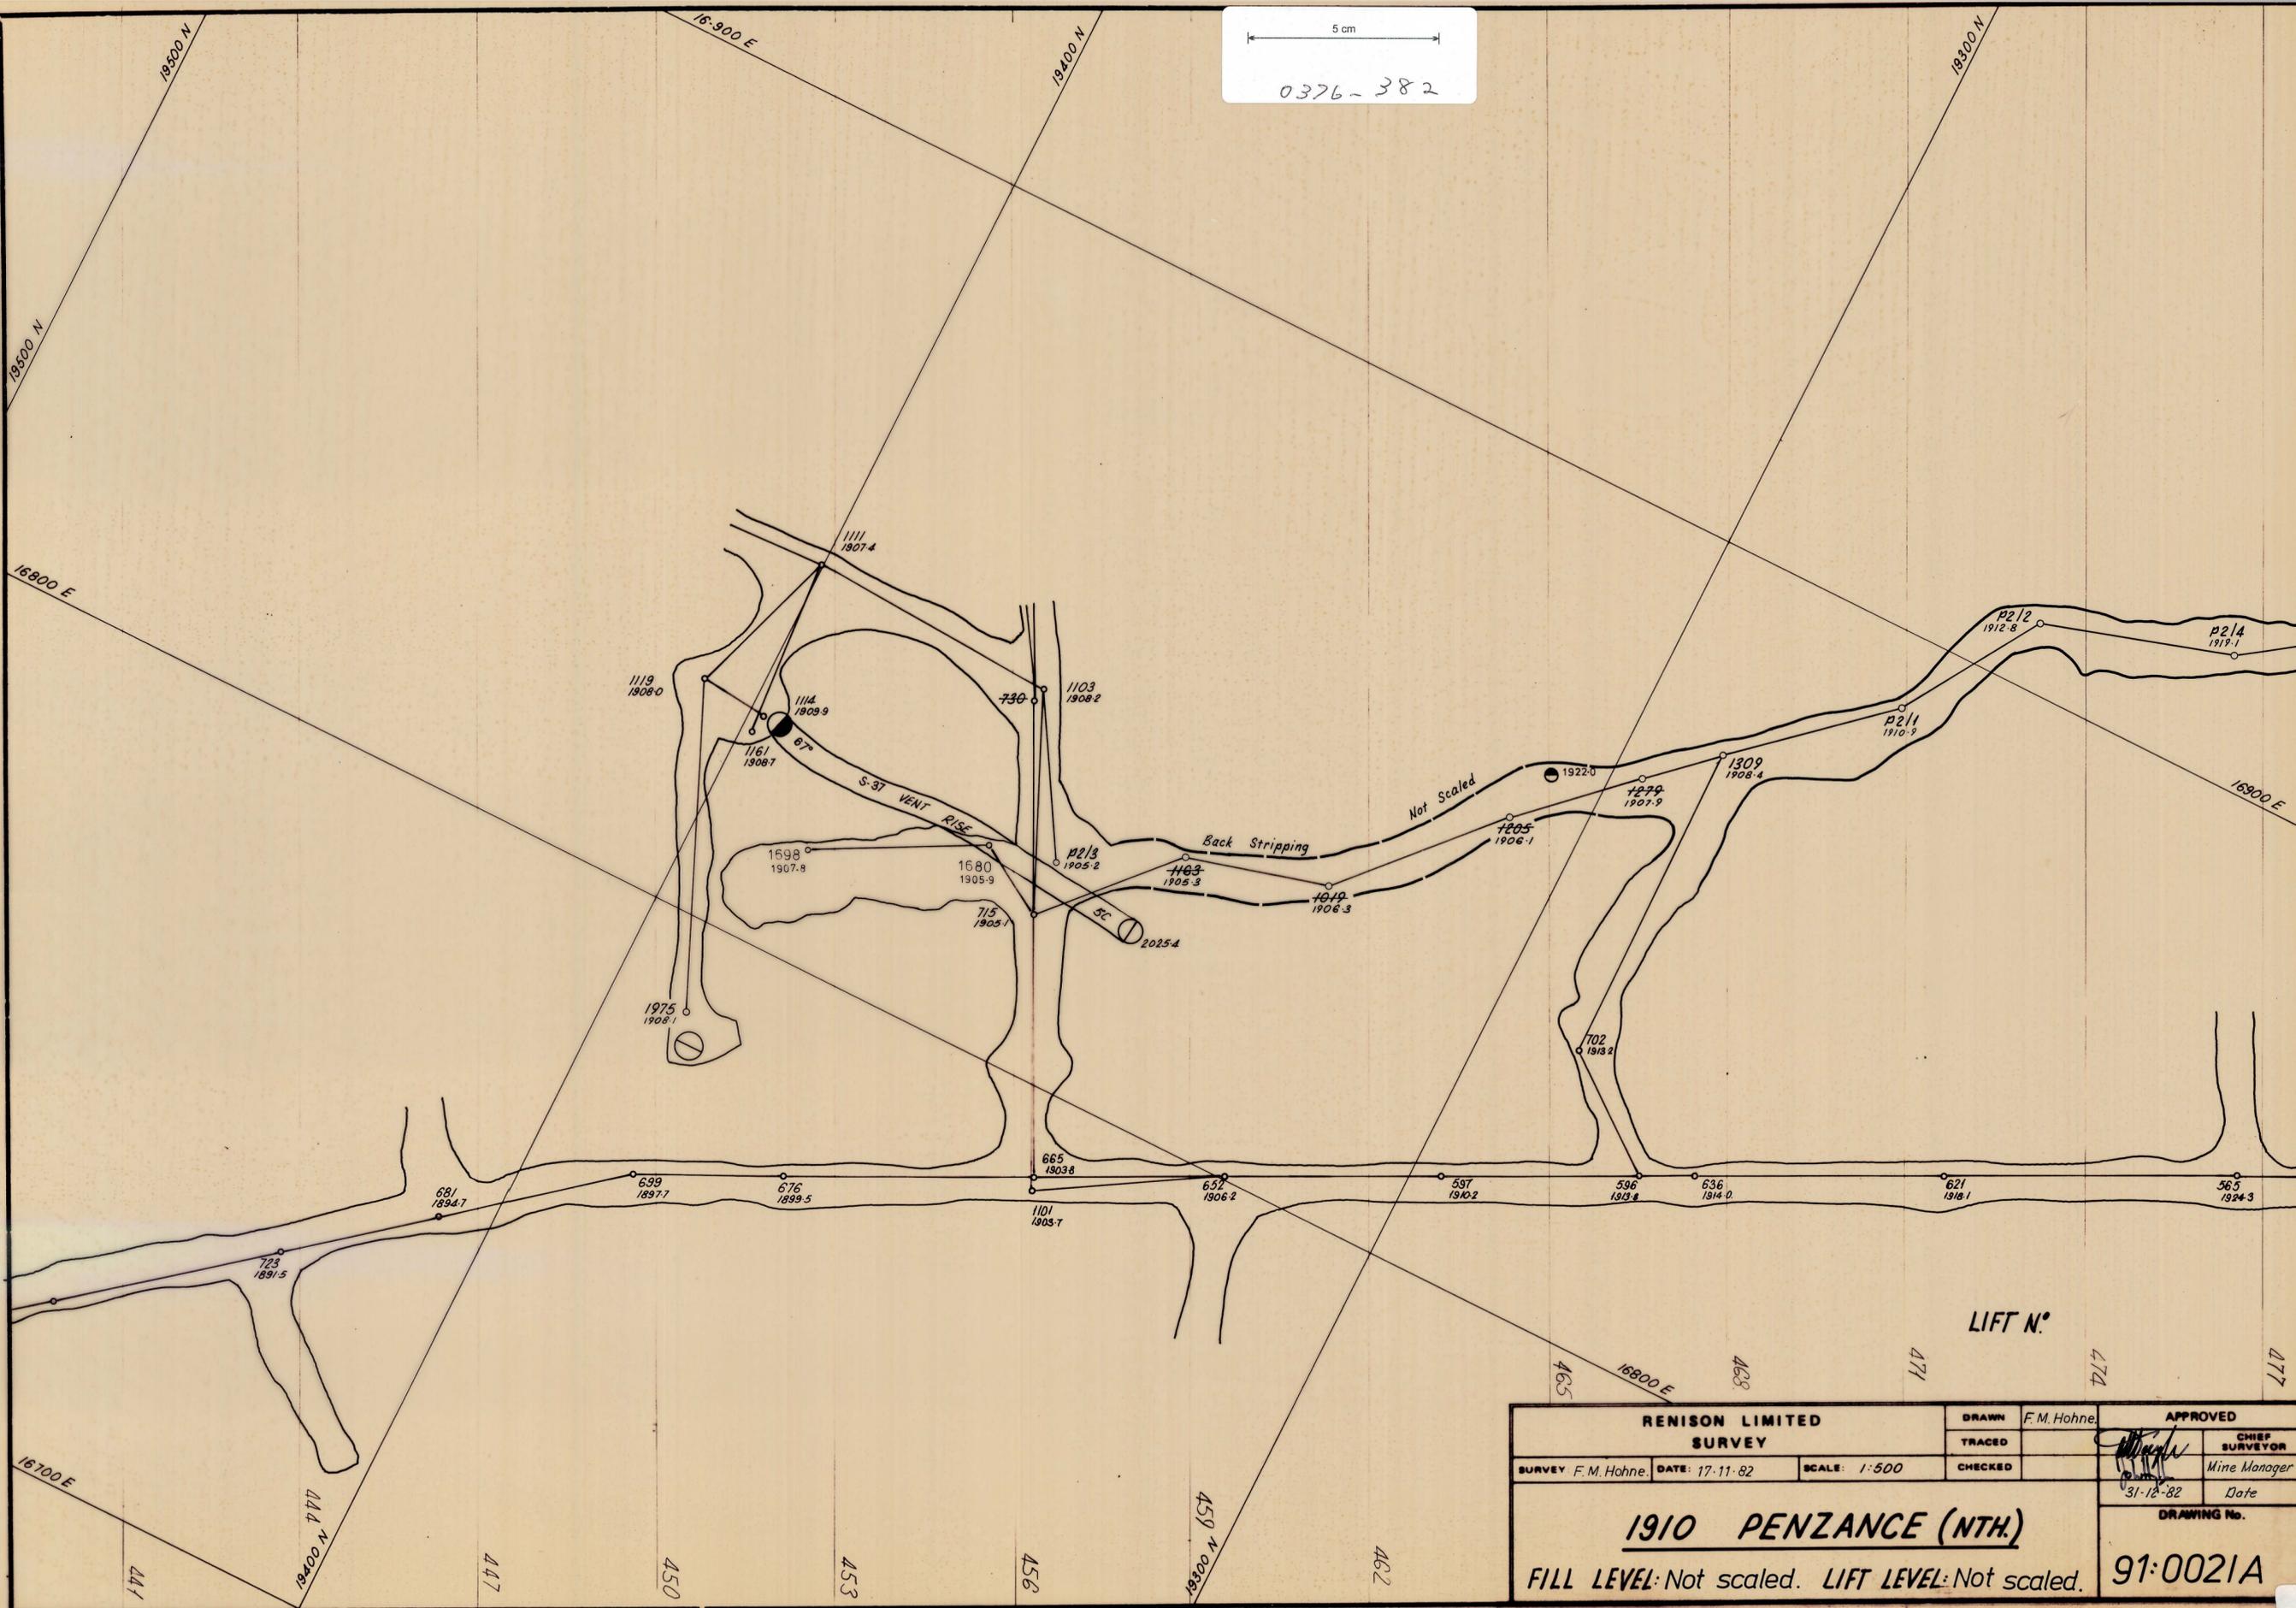

| | | | | |
|---|----------------|-------------------|---|--|
| RENISON LIMITED SURVEY | | DRAWN F. M. Hohne | APPROVED | |
| | | TRACED | <i>[Signature]</i> CHIEF SURVEYOR | |
| SURVEY F. M. Hohne | DATE: 17-11-82 | CHECKED | Mine Manager | |
| | | SCALE: 1:500 | Date | |
| 1910 PENZANCE (NTH.) | | | DRAWING No. | |
| FILL LEVEL: Not scaled. LIFT LEVEL: Not scaled. | | | 91:0021A | |

83201