


0376-383

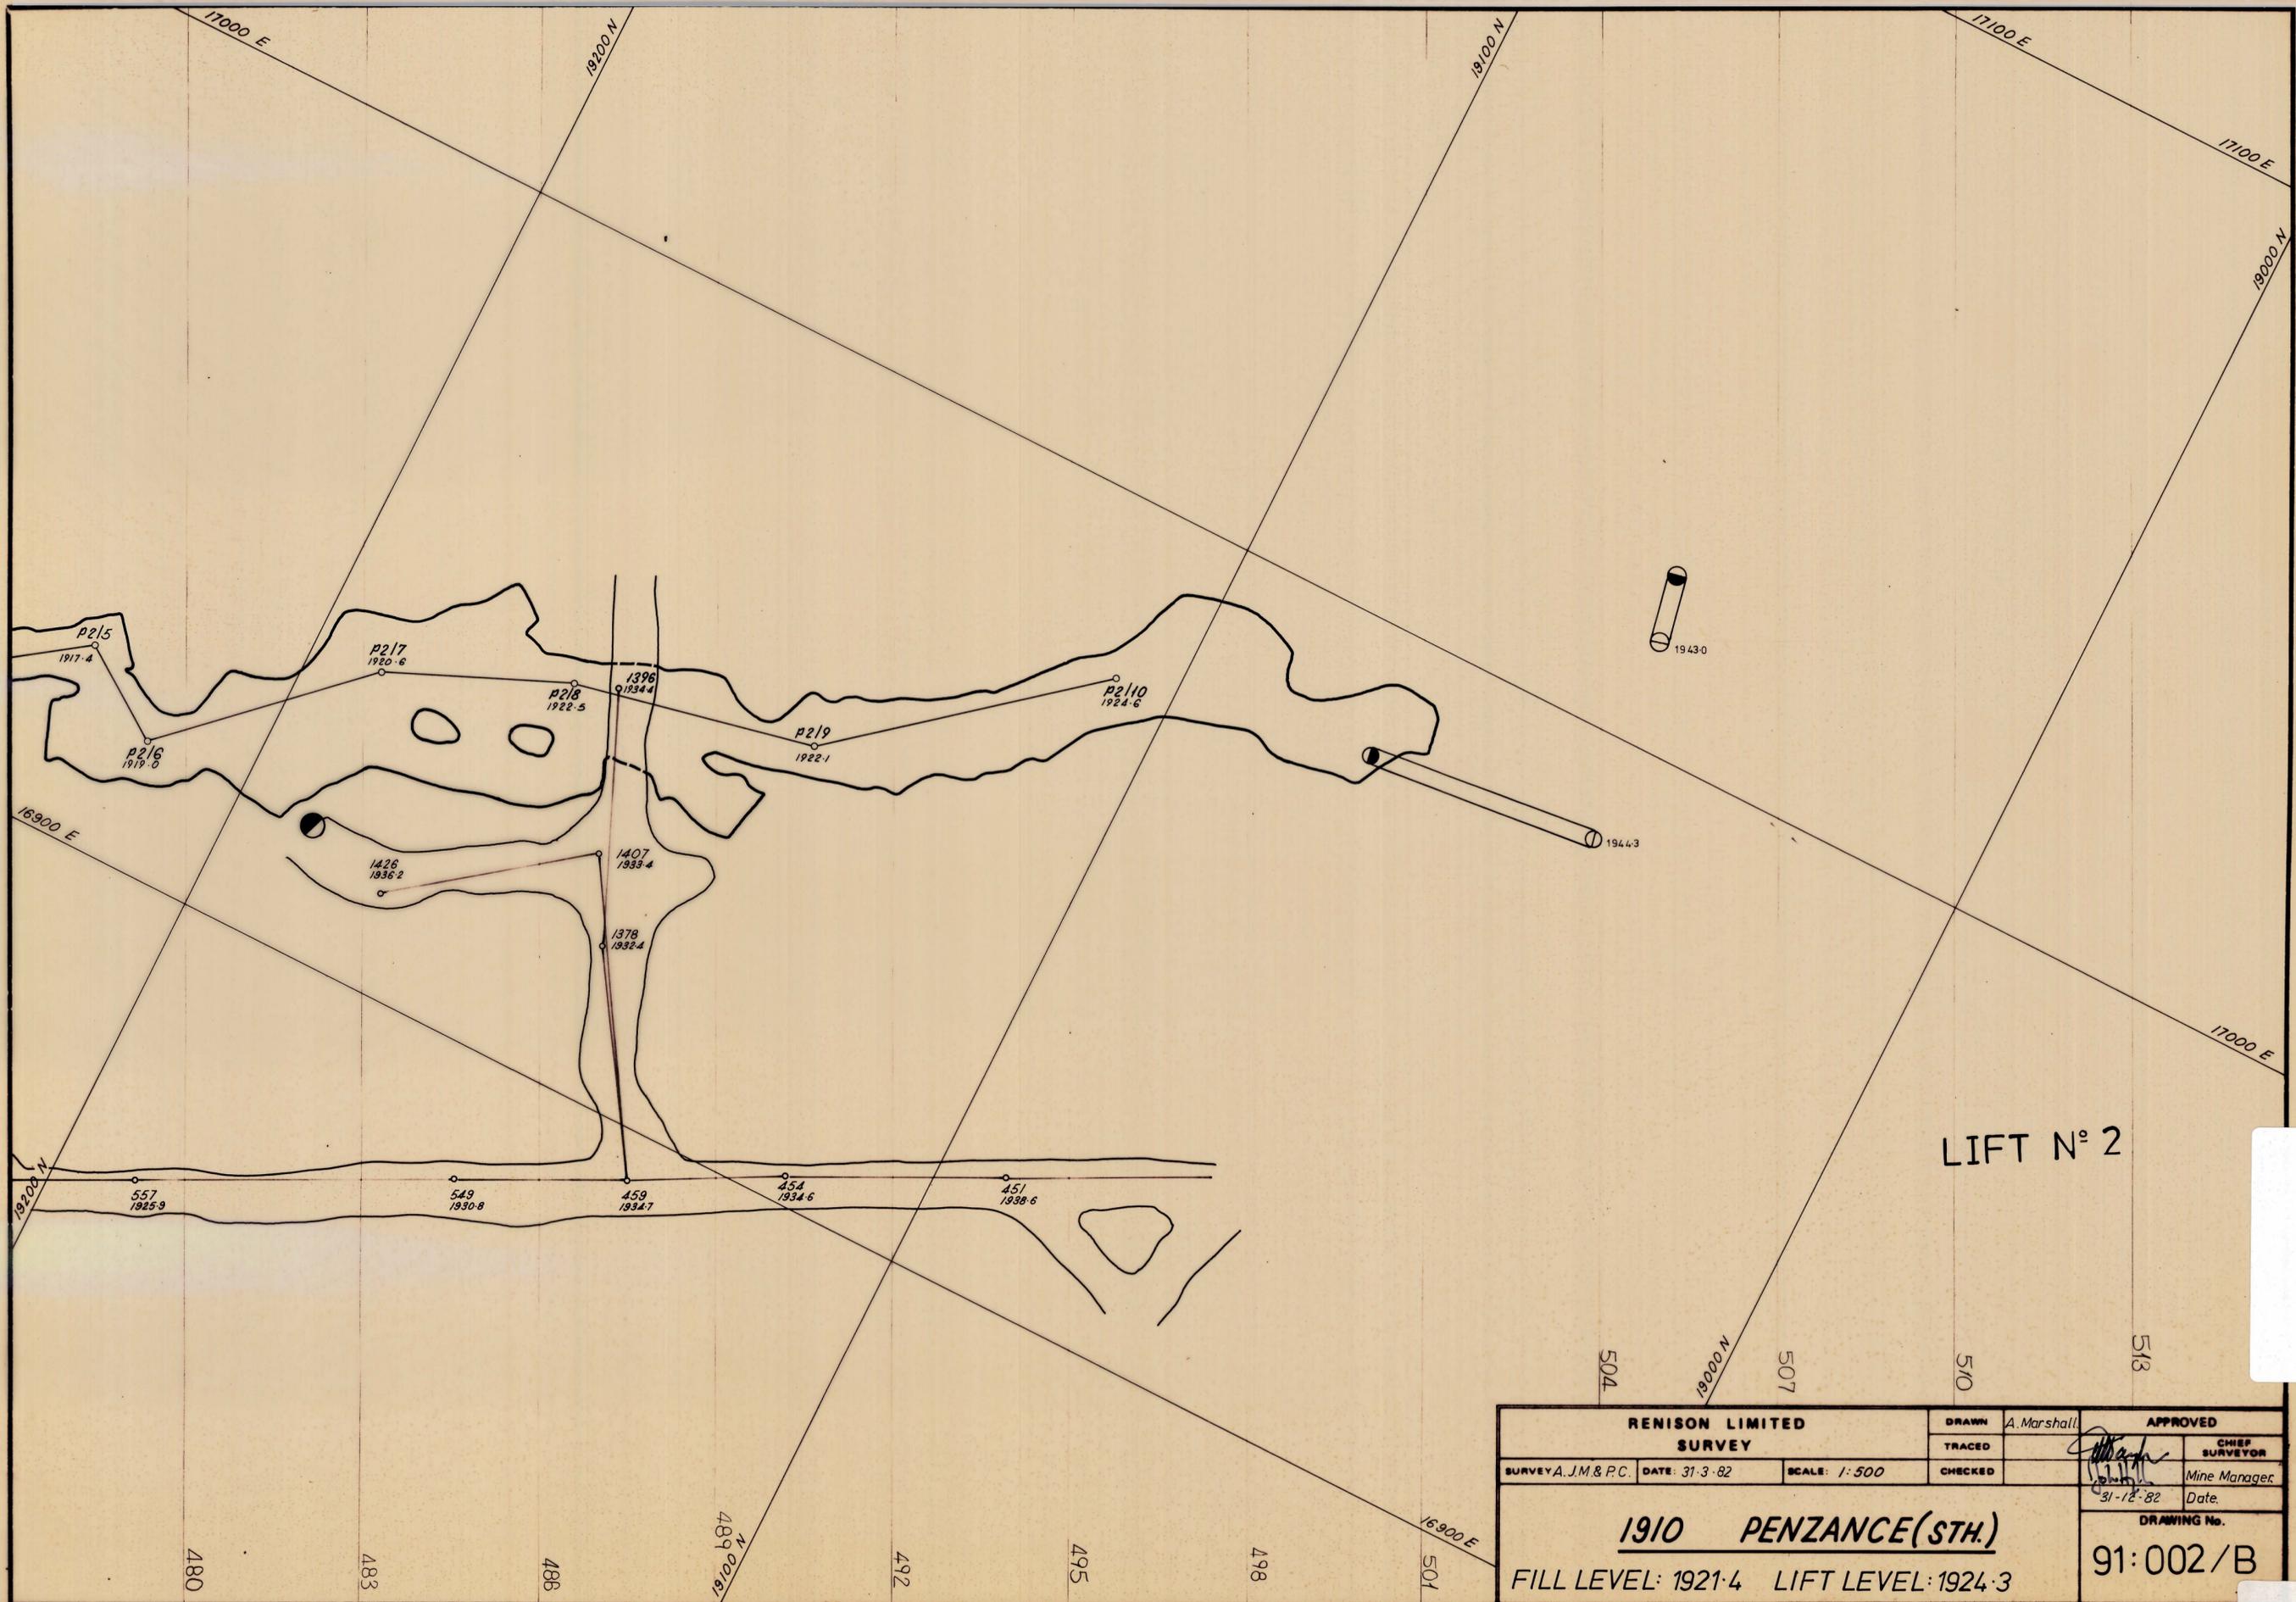

LIFT N° 2

<b>RENISON LIMITED</b>		<b>DRAWN</b> A. Marshall	<b>APPROVED</b>
<b>SURVEY</b>		<b>TRACED</b>	<b>CHIEF SURVEYOR</b>
SURVEY A.J.M. & P.C.	DATE: 31.3.82	SCALE: 1:500	<b>CHECKED</b>
<b>1910 PENZANCE (STH.)</b>			31-12-82 Date.
FILL LEVEL: 1921.4 LIFT LEVEL: 1924.3			DRAWING No. <b>91:002/B</b>

5 cm  
0376-383

83202