


0376-386

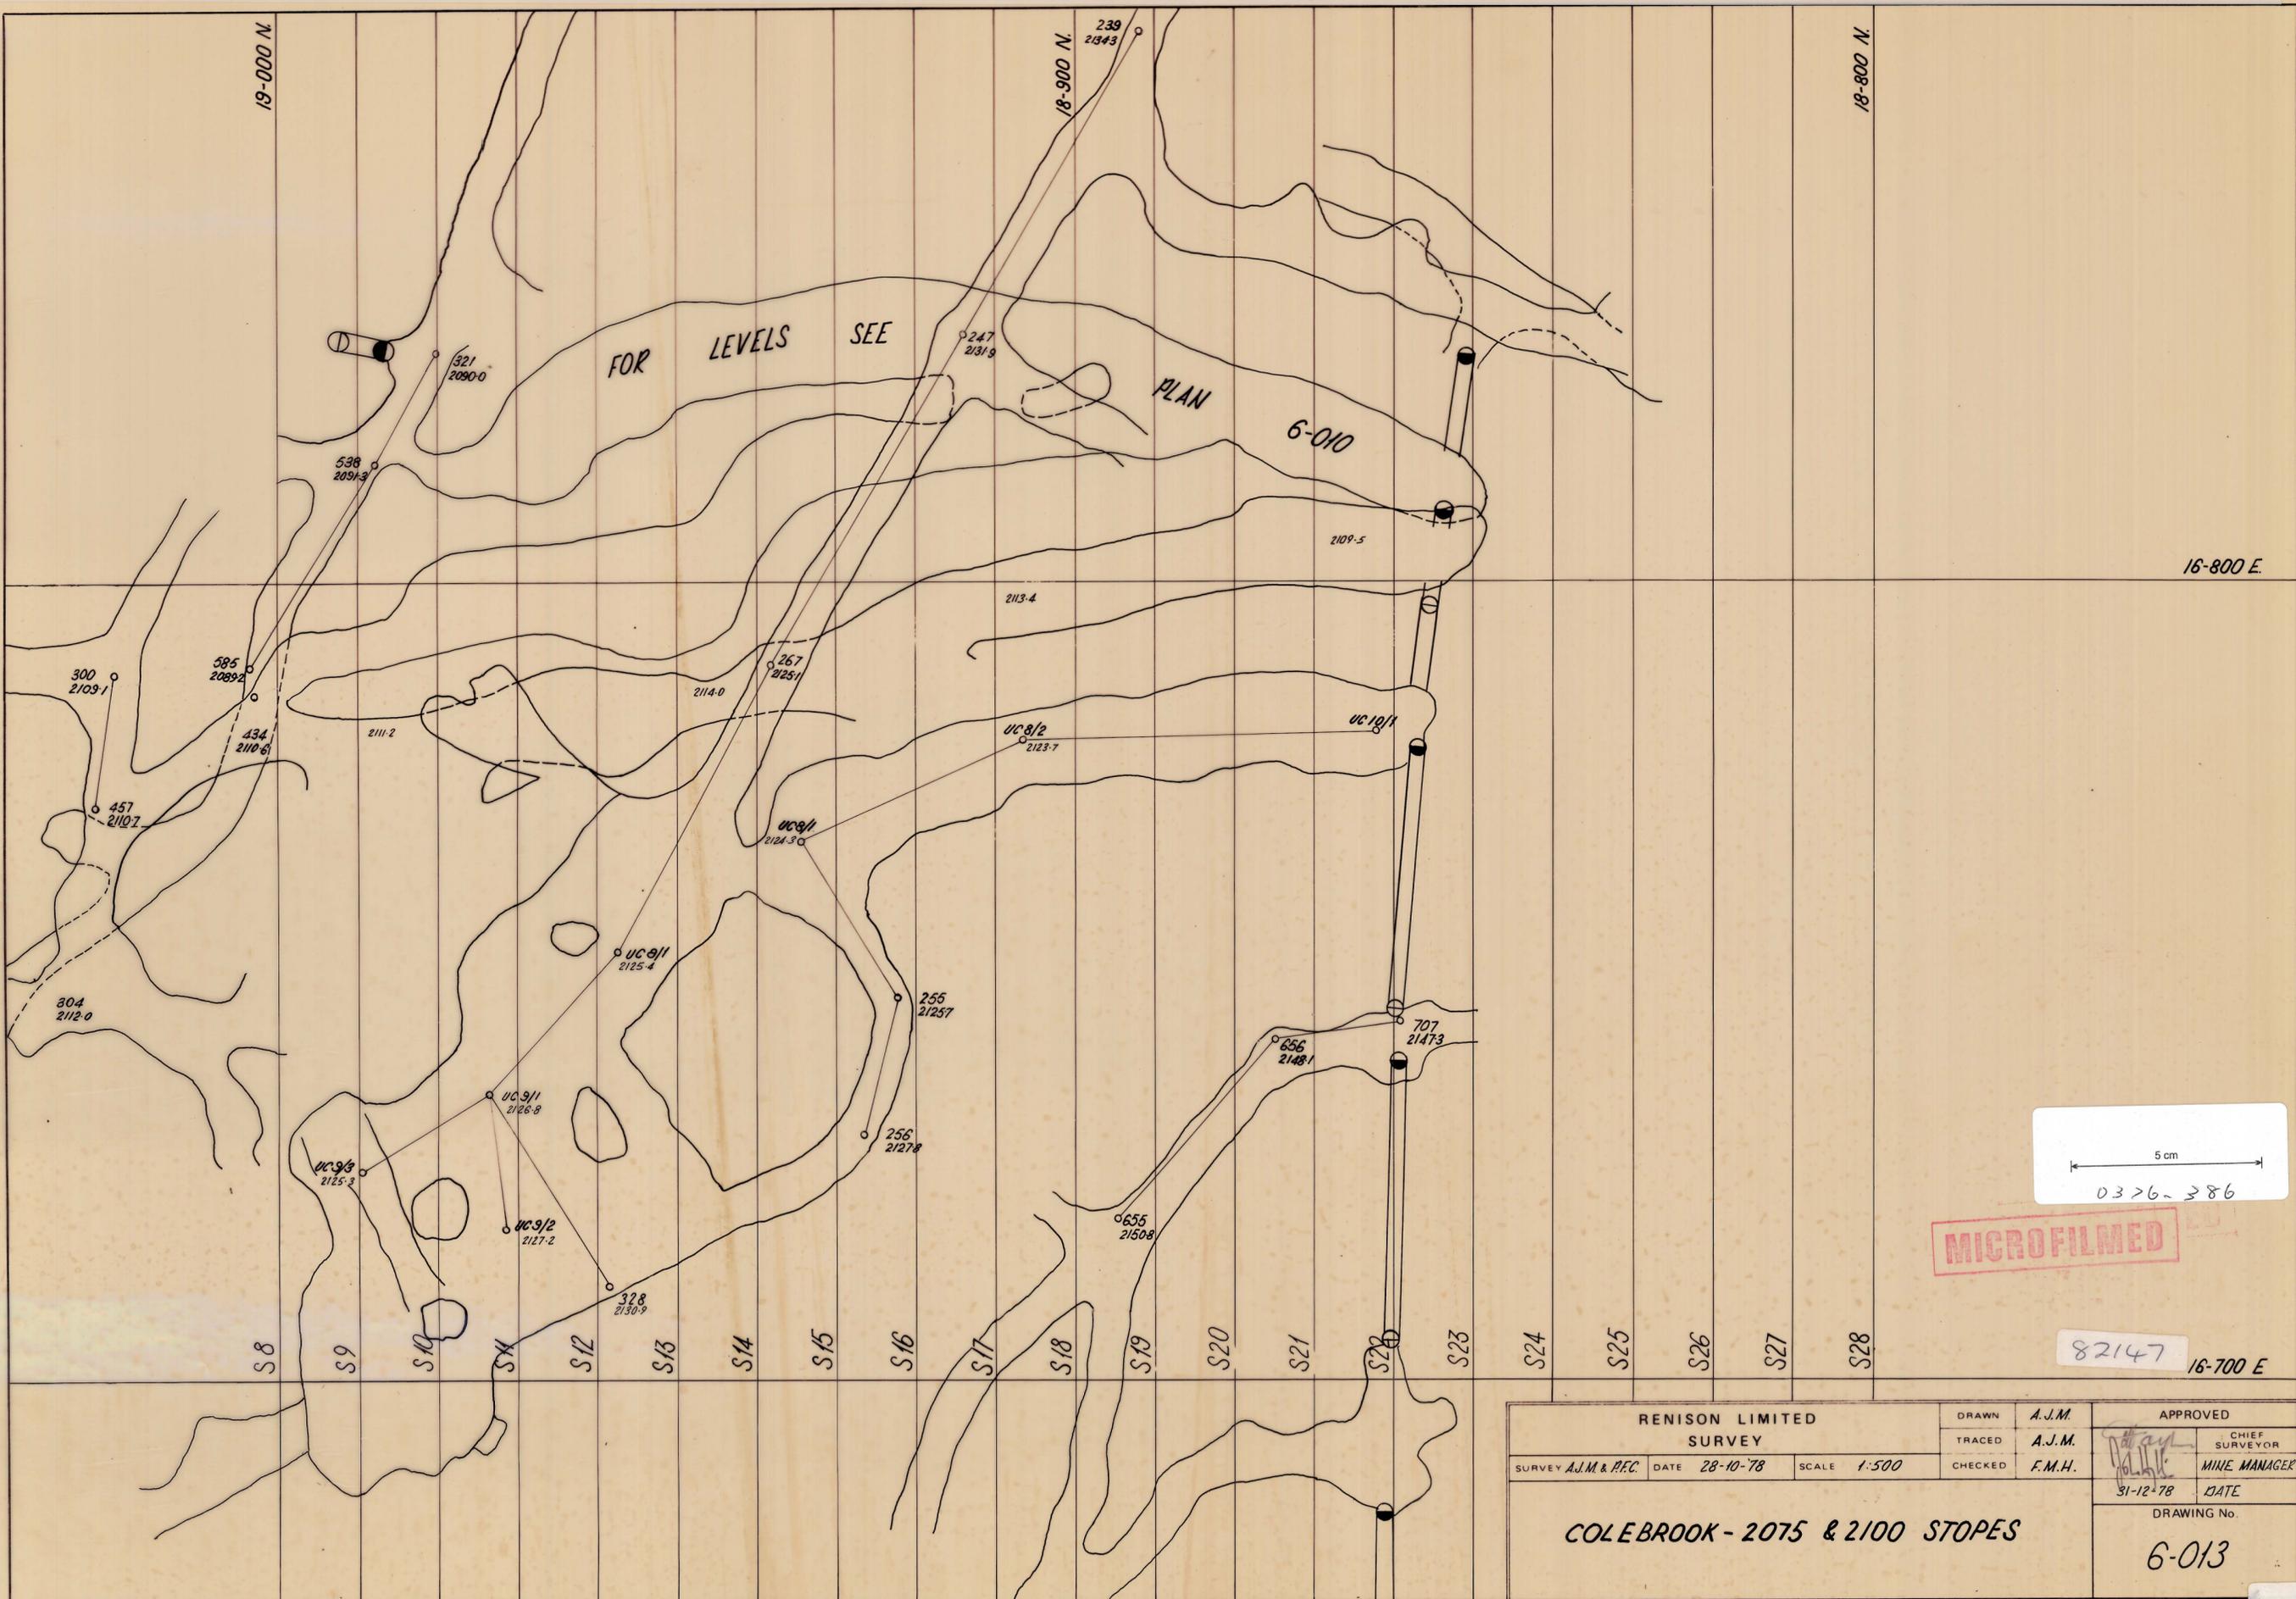

MICROFILMED

82147 16-700 E

RENISON LIMITED SURVEY			DRAWN	A.J.M.	APPROVED
SURVEY A.J.M. & P.F.C.			TRACED	A.J.M.	CHIEF SURVEYOR
DATE	28-10-78	SCALE	1:500	CHECKED	F.M.H.
COLEBROOK - 2075 & 2100 STOPES					DATE
					31-12-78
					DRAWING No.
					6-013

83206