


0376-388

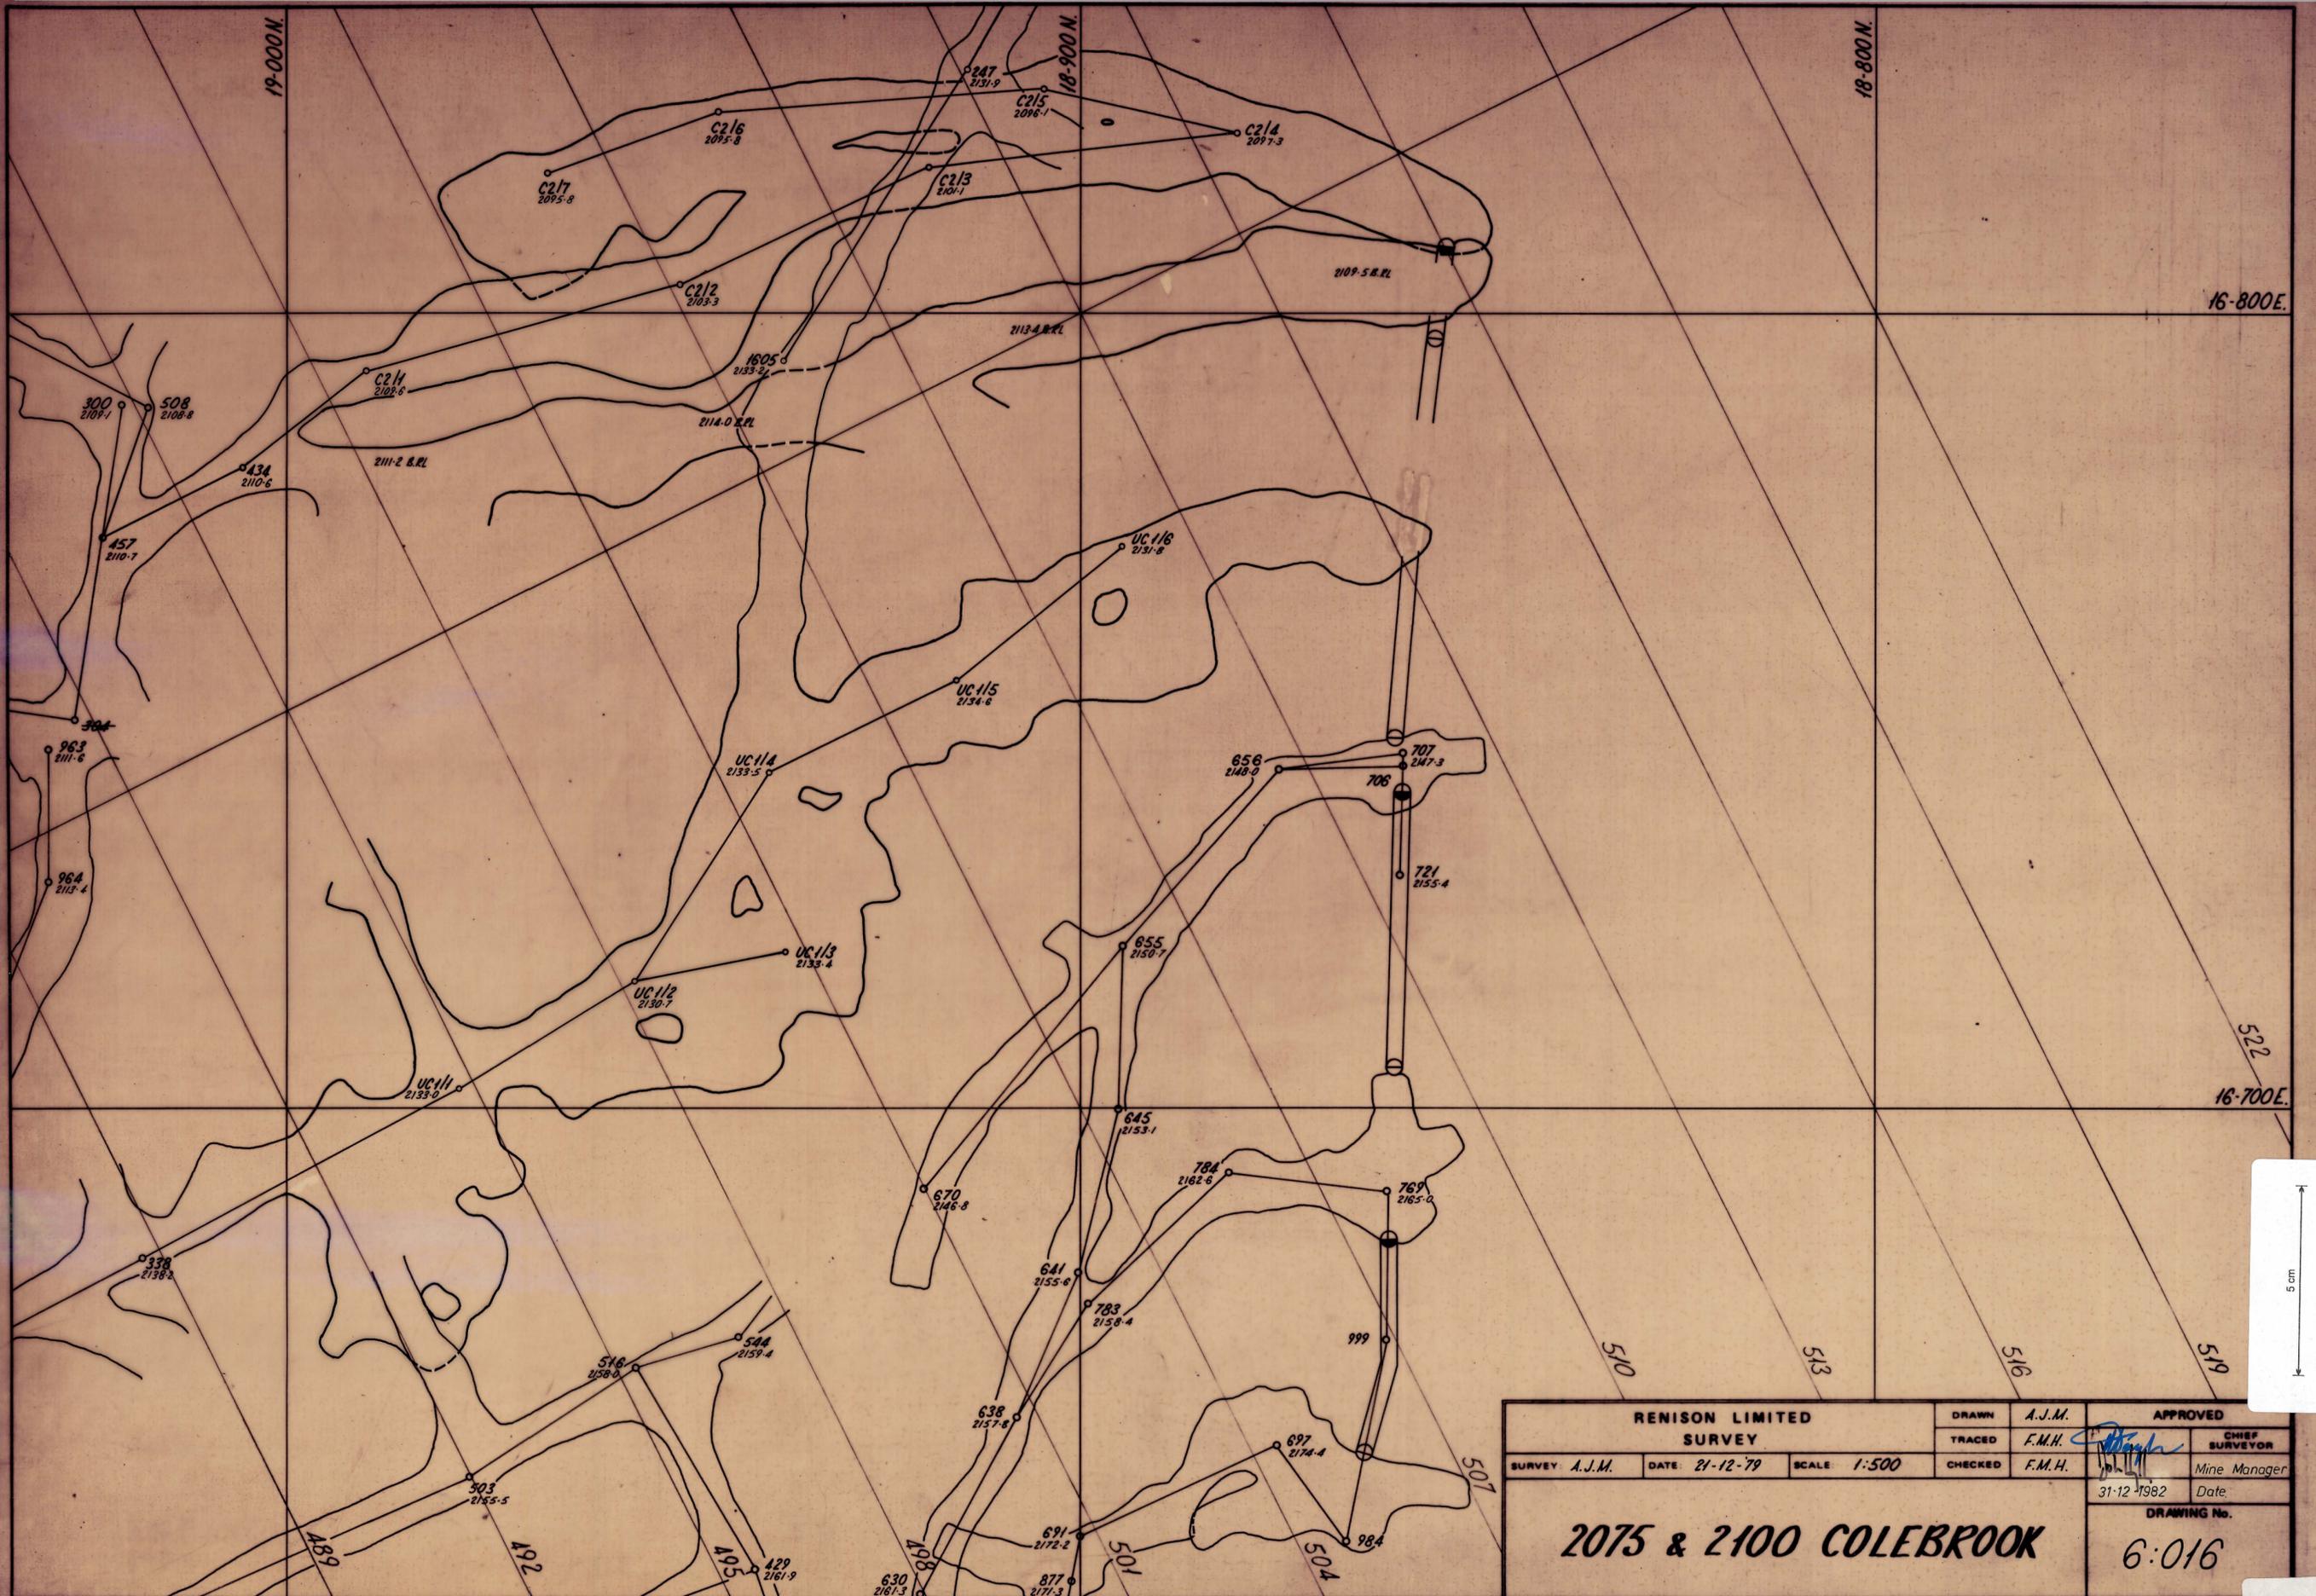

RENISON LIMITED SURVEY SURVEY: A.J.M. DATE: 21-12-79 SCALE: 1:500			DRAWN: A.J.M.	APPROVED: <i>[Signature]</i>
			TRACED: F.M.H.	CHIEF SURVEYOR: <i>[Signature]</i>
CHECKED: F.M.H.			Date: 31-12-1982	Mine Manager:
2075 & 2100 COLEBROOK				DRAWING No. 6:016

5 cm
0376-388

83209